


T255 R12WWM

RECEIVED
DEC 23 1969
STATE ENGINEER
SALEM, OREGON

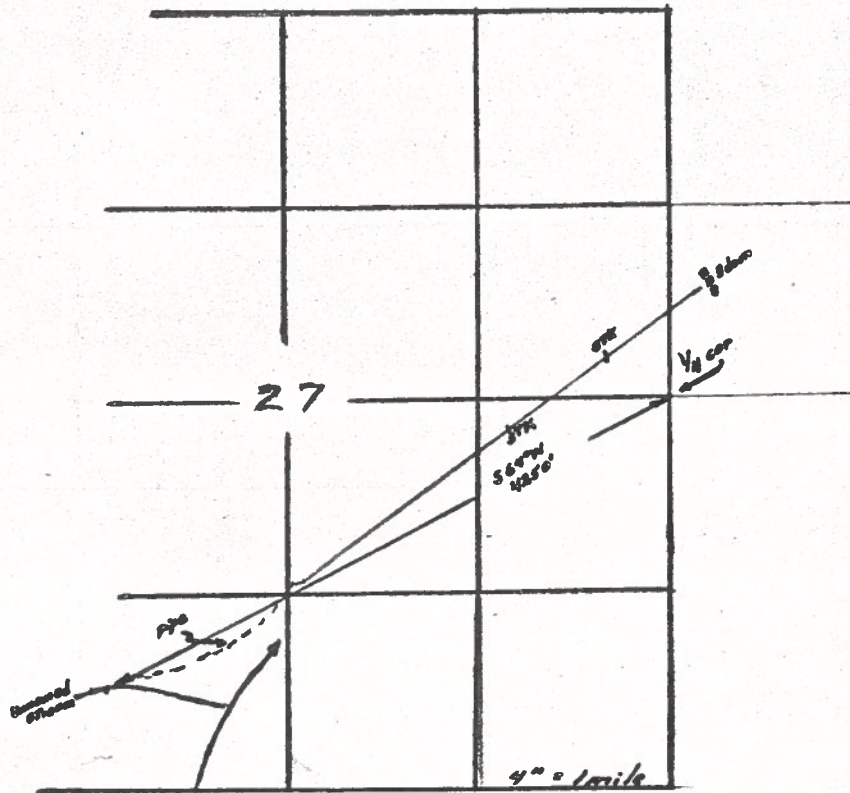

Application No. 46610
Permit No. 34831