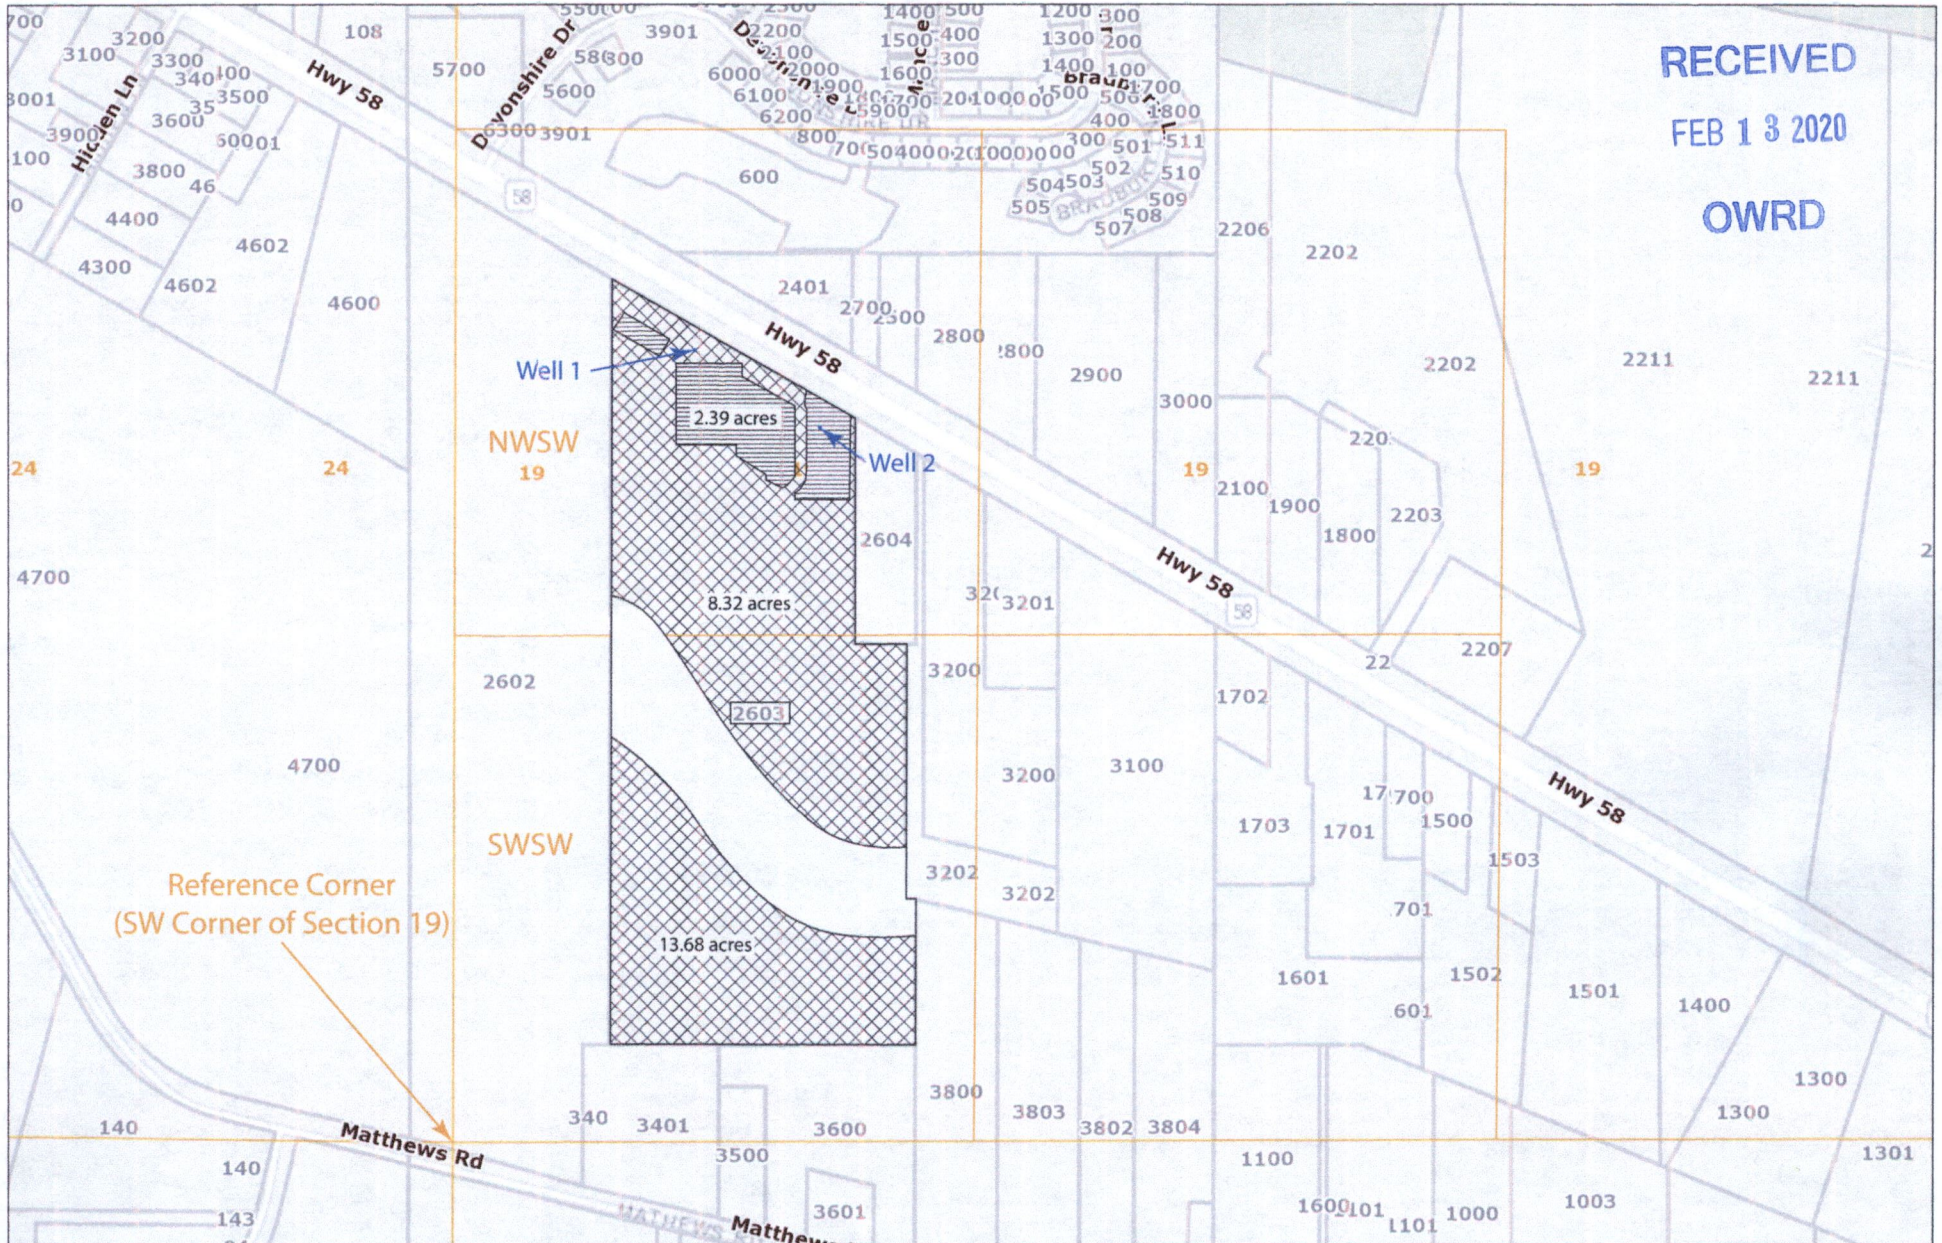

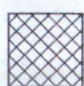
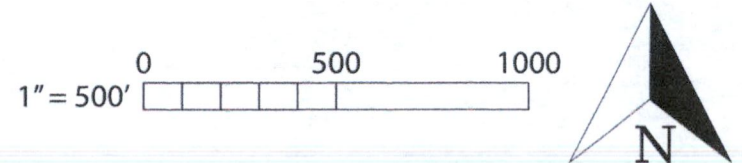


RECEIVED  
FEB 13 2020  
OWRD



-  = Container Area
-  = In-ground Area

Well 1 is 2084 ft N and 632 ft E of SW Corner of Section 19  
Well 2 is 1886 ft N and 945 ft E of SW Corner of Section 19  
Property Location 18-02-19-00-02603



6-10914



CANCELLED:

- 200
- 3400
- 2204
- 411
- 2400
- 3203
- 2000
- 3700
- 201
- 2503
- 3900
- 2600
- 3300
- 2205
- 2501
- 301
- 2208
- 2502
- 2200
- 2601
- 400

OVRD

RECEIVED

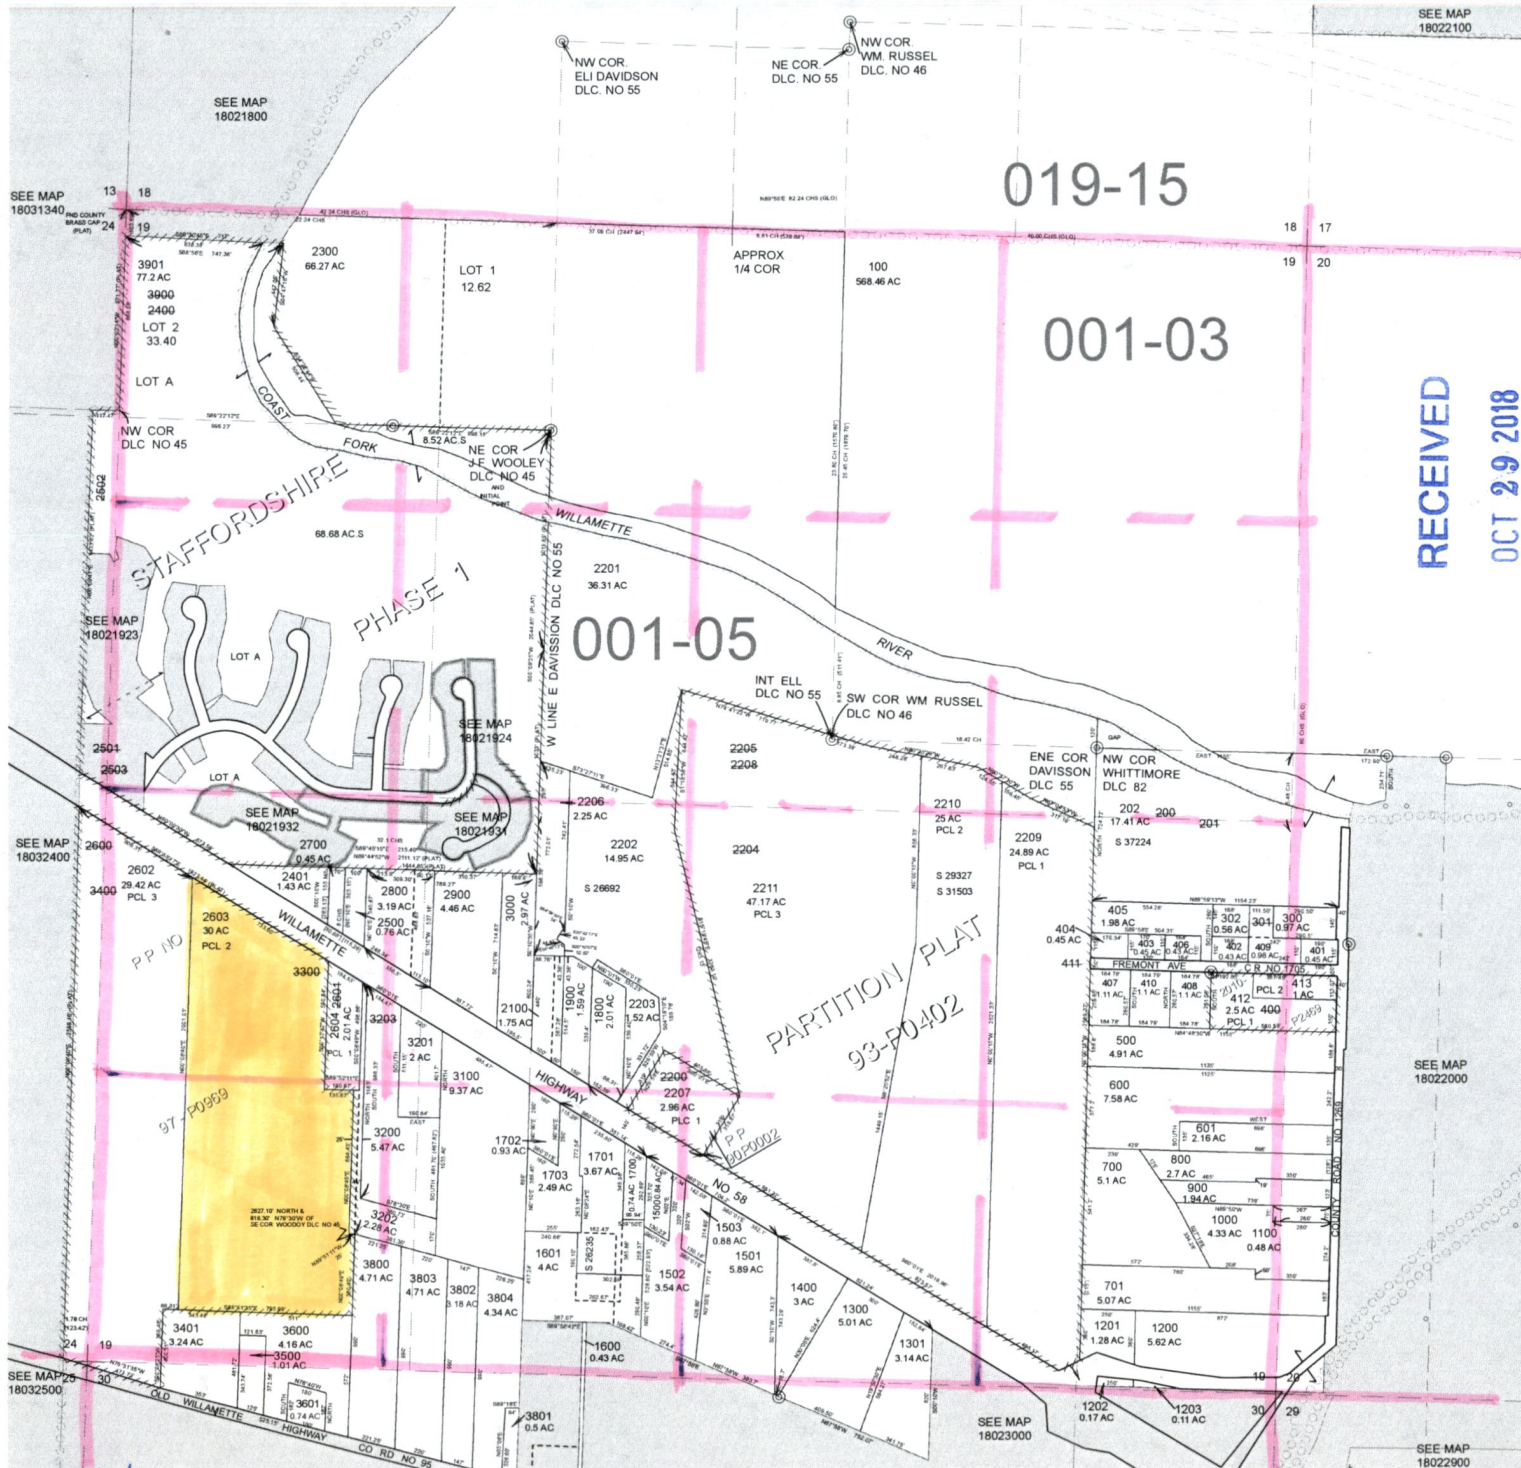
FEB 13 2020

OVRD

RECEIVED

OCT 29 2018

OVRD



Tax lot  
2603  
30 AC

6-10914