


T.17S.R.2W.W.M.

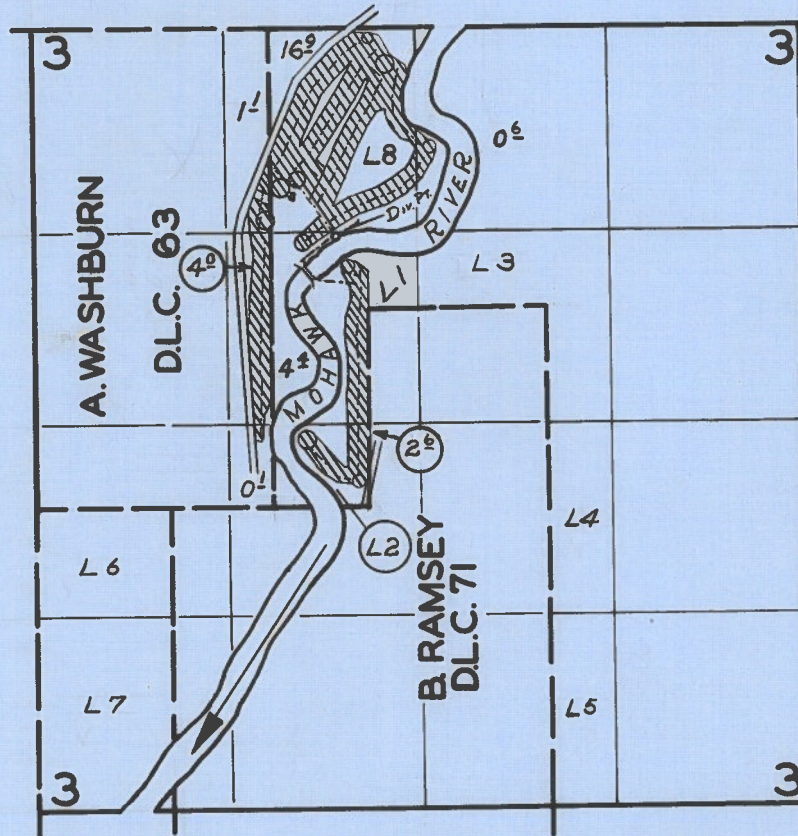

FINAL PROOF SURVEY
UNDER

Application No. 32520... Permit No. 25691.....
IN NAME OF

.....*SPRINGFIELD COUNTRY CLUB INC.*.....

Surveyed *May 9* 1961, by *M. Bish*.....