

TOWNSHIP 40S, RANGE 8W
SECTION 23

ENE COR
DLC No 43

Note: The indicated point of diversion for irrigation lies 40 feet East of the West line of D.L.C. No. 43 and the indicated point of diversion for domestic use lies 12 feet East of the West line of D.L.C. No. 43

RECEIVED
AUG 24 1983
WATER RESOURCES DEPT.
SALEM, OREGON

Township 40S, Range 8W,
Section 23


Application No. 65595
Permit No. *Superseded*

RECEIVED
NOV 16 1983
WATER RESOURCES DEPT.
SALEM, OREGON

22 23
27 26

23 24
26 25


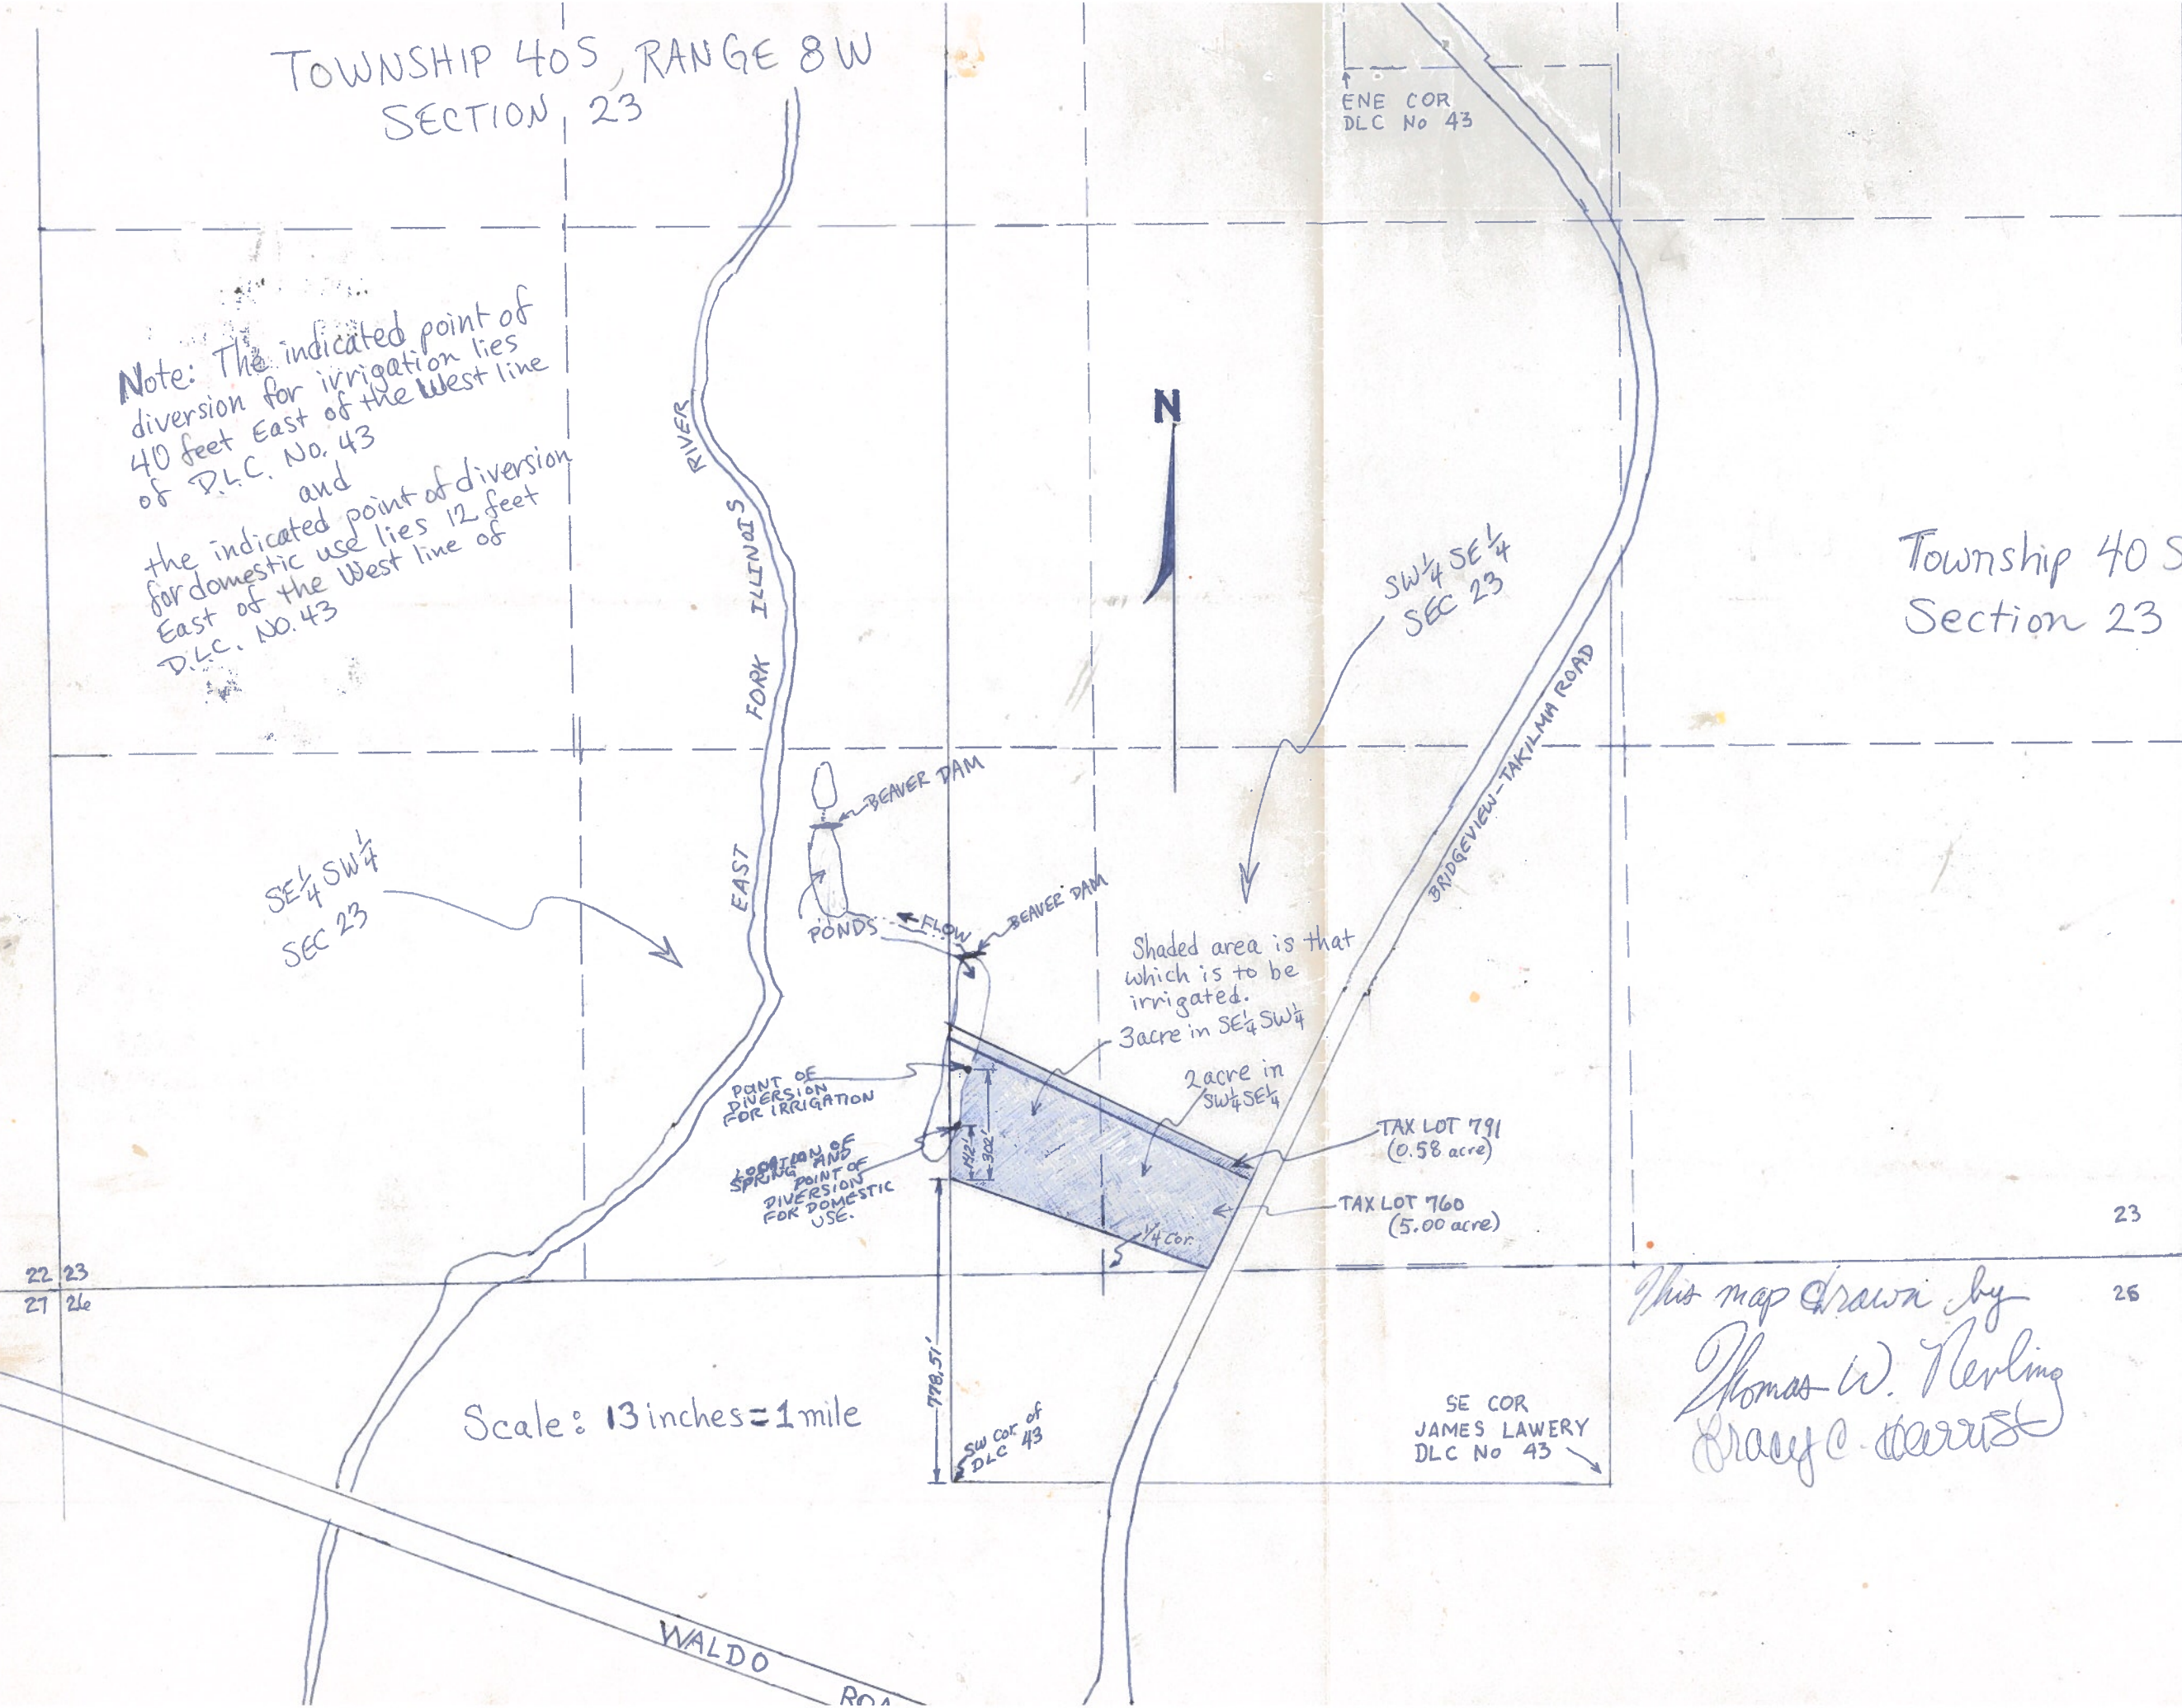


This map drawn by
Thomas W. Nerling
Craig C. Harris

SE COR
JAMES LAWERY
DLC No 43

SW COR of
DLC 43

WALDO ROAD

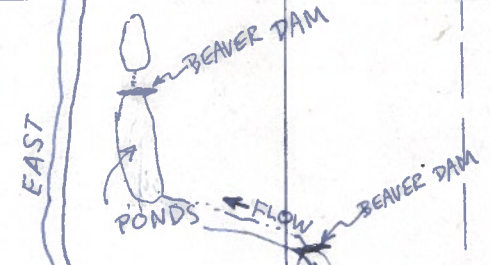

Shaded area is that which is to be irrigated.
3 acre in SE 1/4 SW 1/4
2 acre in SW 1/4 SE 1/4

POINT OF DIVERSION FOR IRRIGATION
LOCATION OF SPRING AND POINT OF DIVERSION FOR DOMESTIC USE.

TAX LOT 791
(0.58 acre)

TAX LOT 760
(5.00 acre)

1/4 cor.

778.51'

142.1'

902'