
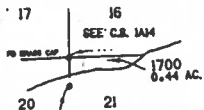


23 12 21

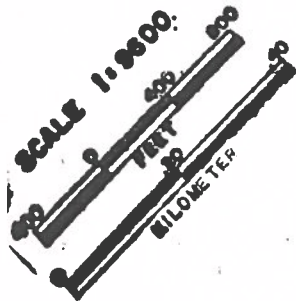

Application No. 81655  
Permit No. 53292

WALEH RESOURCES DEPT  
SALEM, OREGON

NOV 6 1996

RECEIVED  
SEE MAP 23 12 20


**CHECKED -**

**TRACED**

## LAYOUT

**CONTROL**

RECEIVED  
SEP 1989  
DEPT. OF REVENUE STATE OF OREGON  
ASSESSMENT & APPRAISAL DIV.

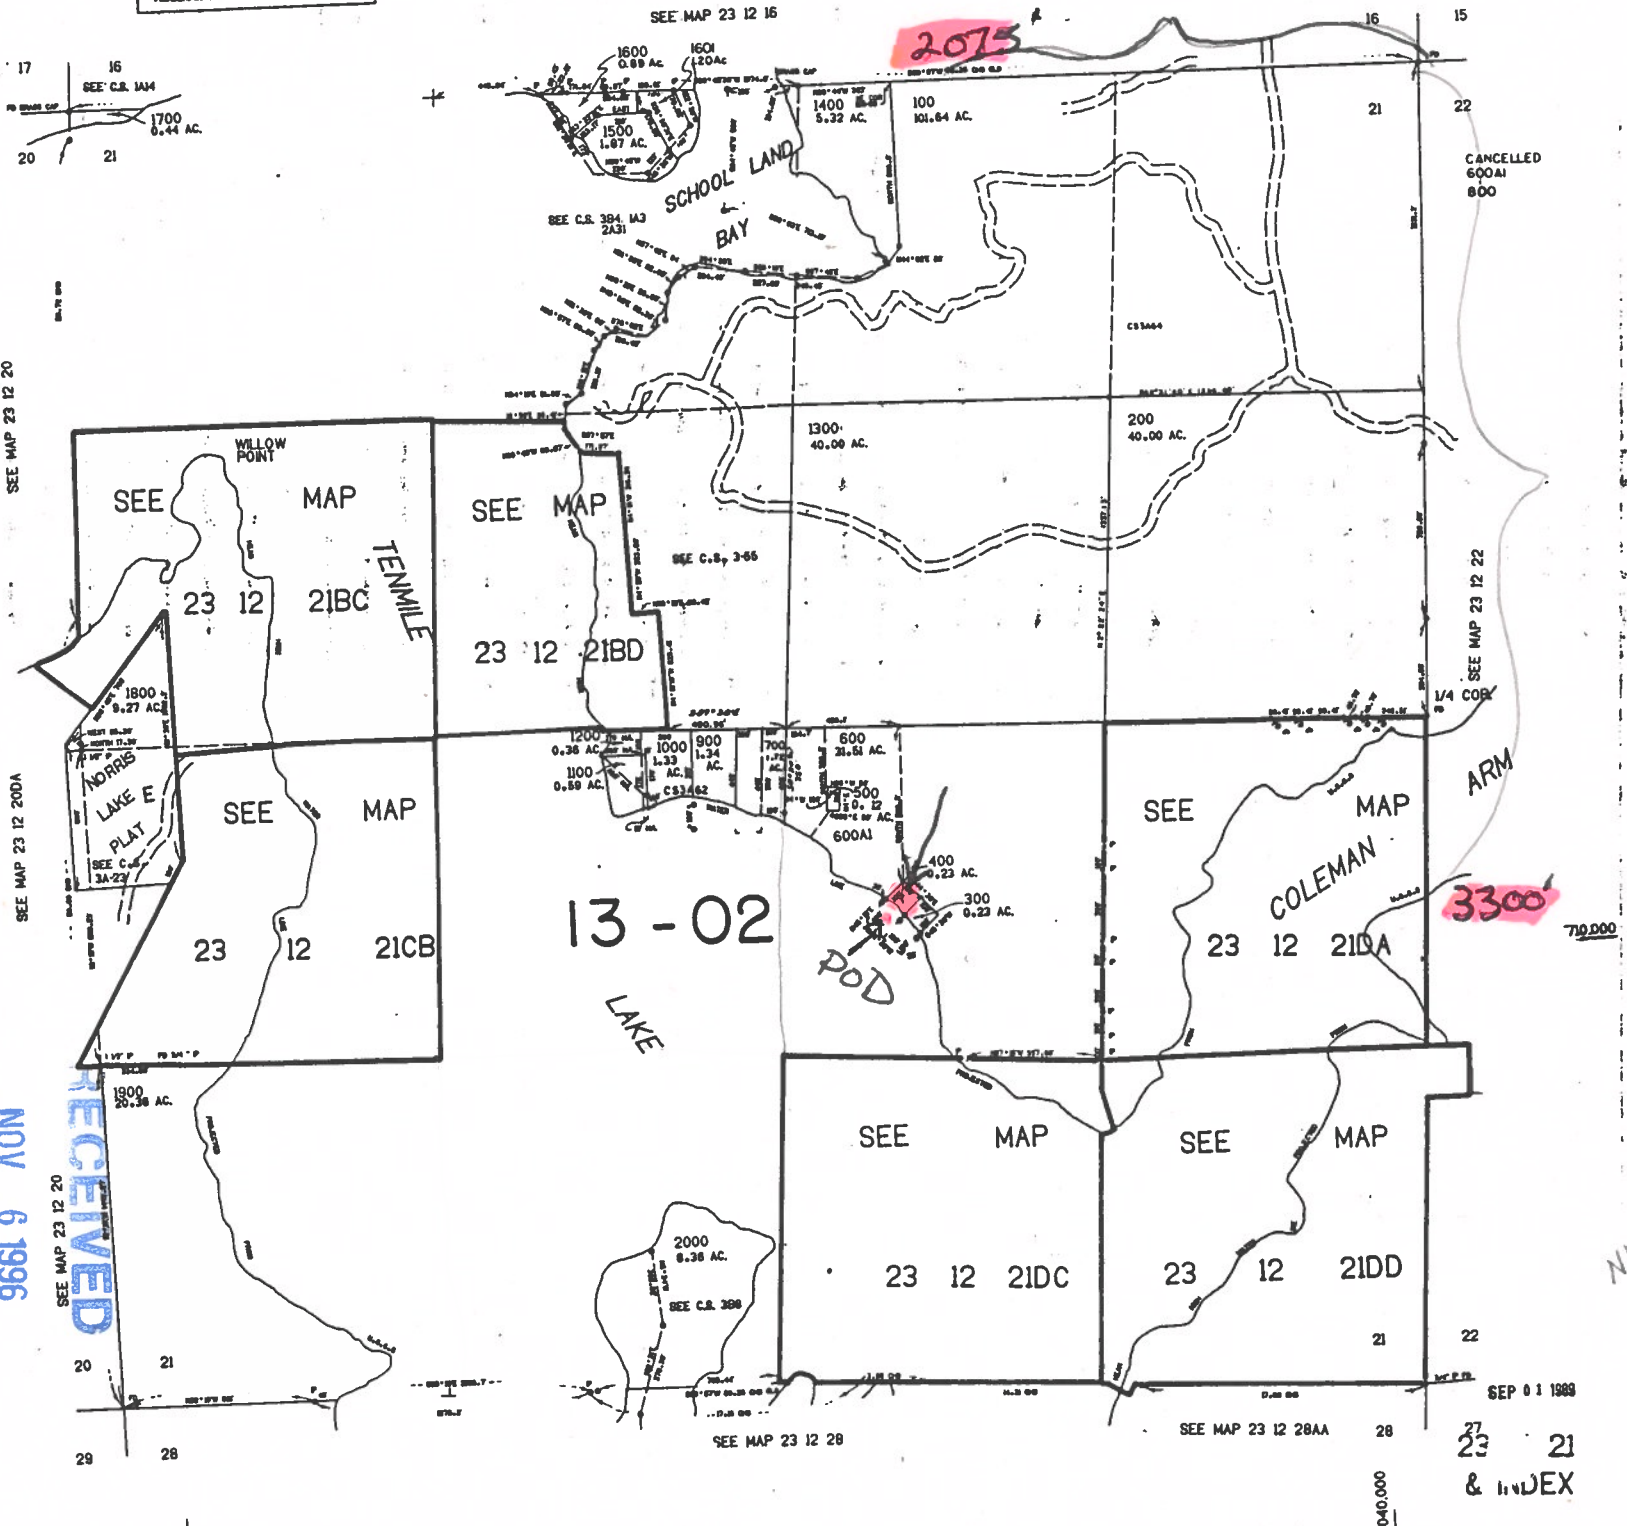

NWSE

SEP 01 1969  
23 21  
& INDEX