


Application Map for Sabre Ridge Ranch, LLC


RECEIVED
MAR 02 2020

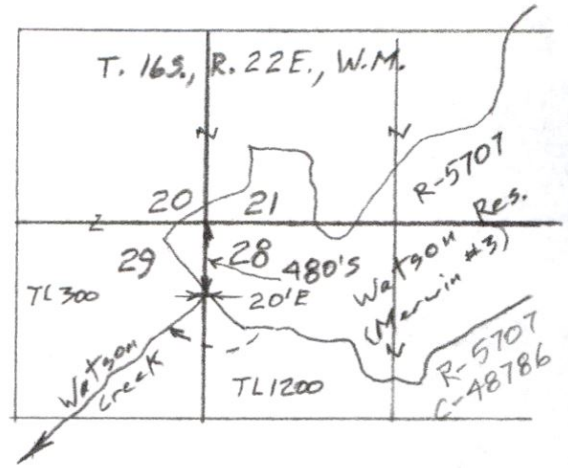

OWRD

RECEIVED
OCT 24 2019
OWRD
RECEIVED
FEB 03 2020
OWRD

Scale 1" = 1320'
(4" = 1 mile)

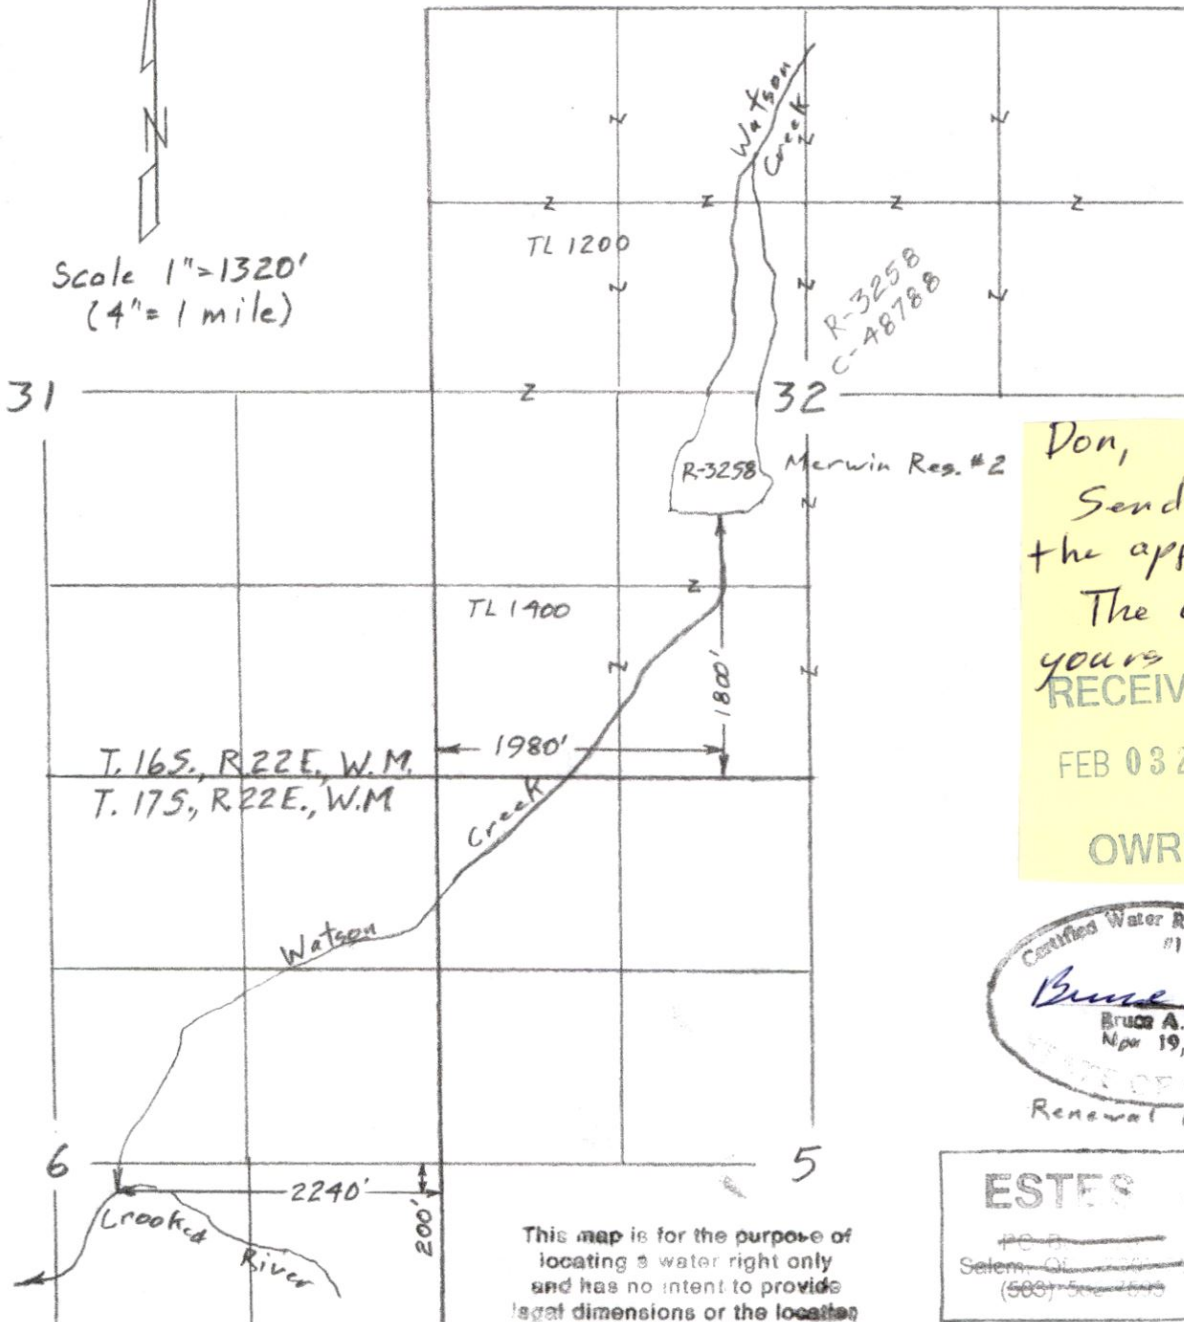


Don,
Send these with the application.
The other 2 are yours to keep.

RECEIVED
FEB 03 2020

RECEIVED
OCT 24 2019

OWRD OWRD

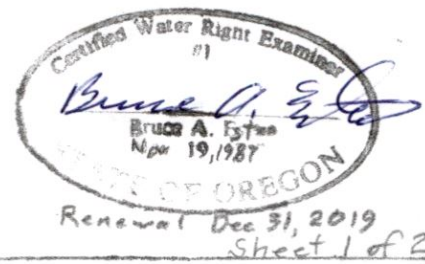


ESTES SURVEYS, LLC

60382 Arnold Rd
Bend, OR 97702
(541) 382-7391

This map is for the purpose of locating a water right only and has no intent to provide legal dimensions or the location of property lines.

Application Map for Sabre Ridge Ranch, LLC

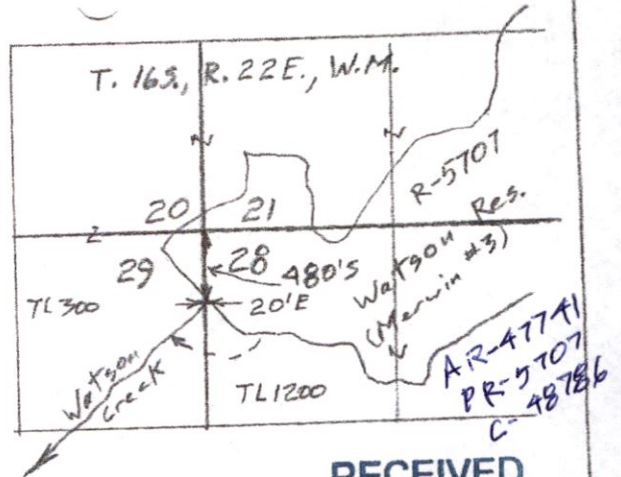

RECEIVED

JAN 07 2019

OWRD

RECEIVED

OCT 24 2019

OWRD

RECEIVED

MAR 02 2020


OWRD

RECEIVED


FEB 03 2020

OWRD

Scale 1"=1320'
(4"=1 mile)

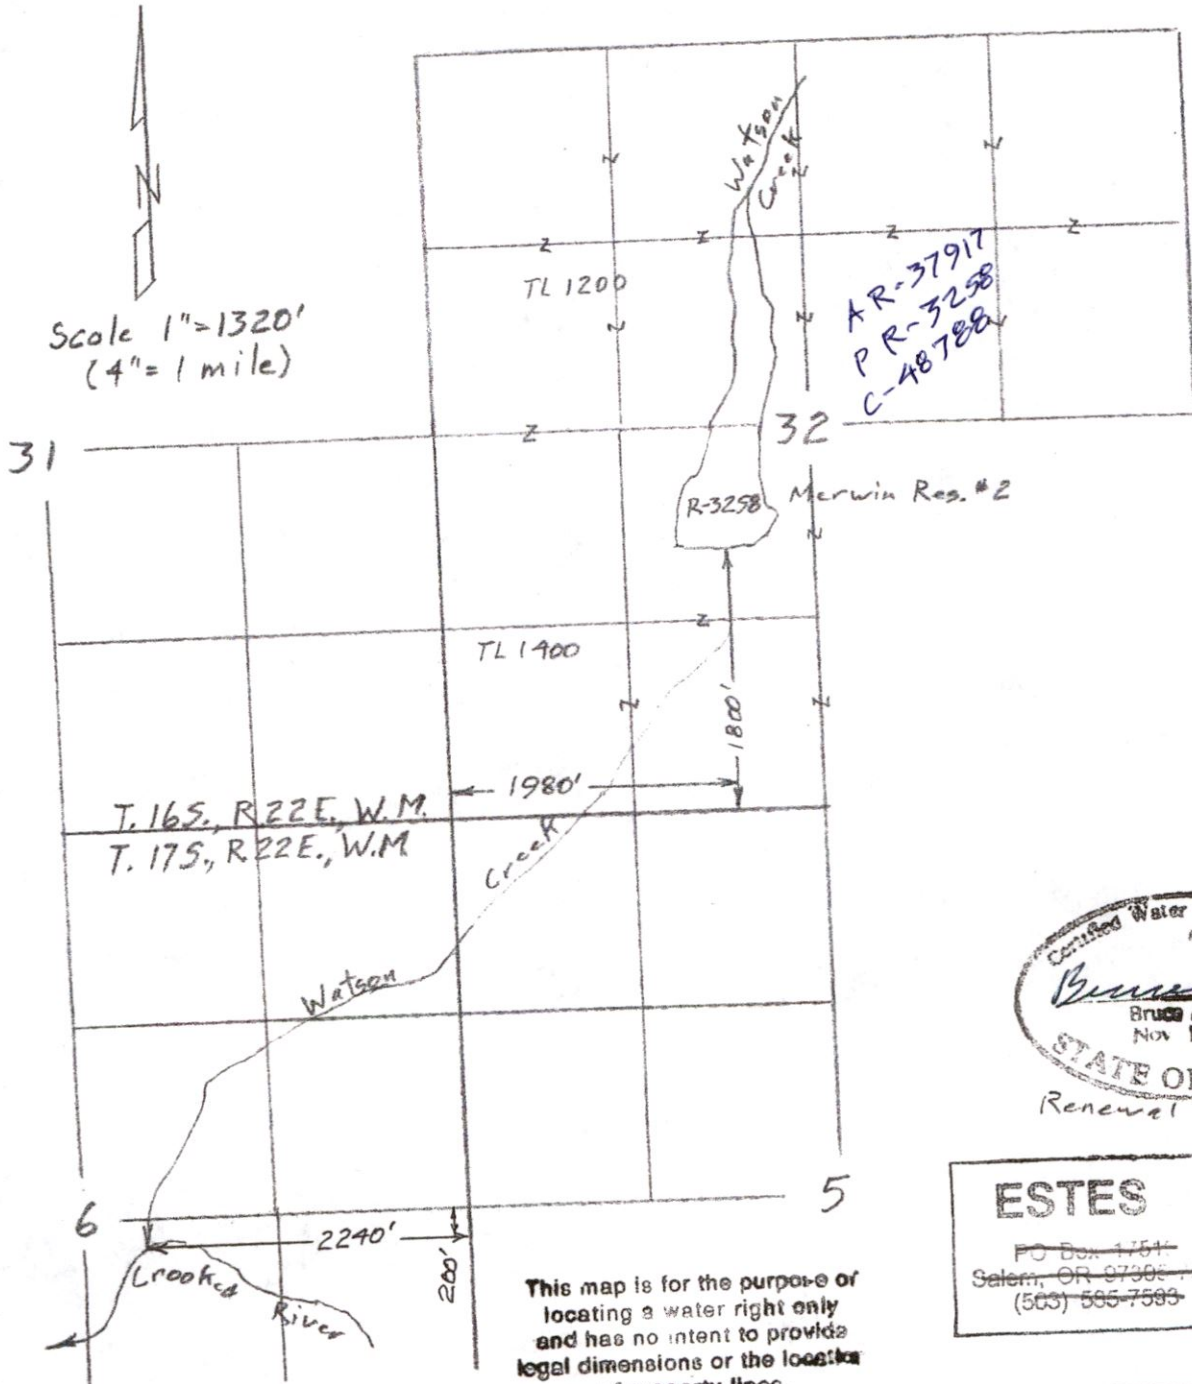

AR-37917
PR-3258
C-48786

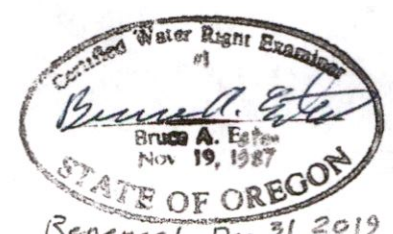

Renewal Dec 31, 2019
Sheet 1 of 2

ESTES SURVEYS, LLC
 PO Box 1751
 Salem, OR 97302-1751
 (503) 585-7589
 60382 Arnold Rd
 Bend, OR 97702
 (541) 382-7301

This map is for the purpose of locating a water right only and has no intent to provide legal dimensions or the location of property lines.


S-80014

RECEIVED

JAN 07 2019

OWRD

T. 17 S., R. 21 E., W.M.

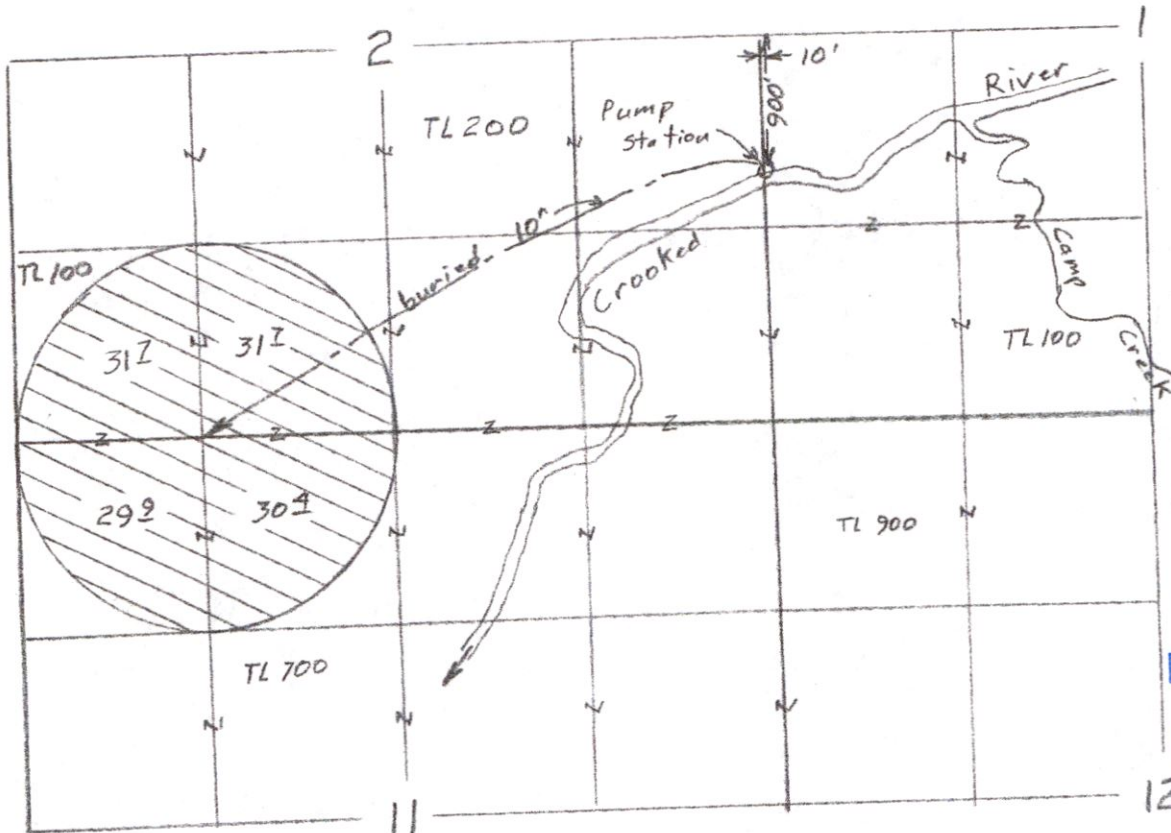

Scale
1" = 1320'
(4" = 1 mile)

RECEIVED

MAR 02 2020

OWRD

RECEIVED


⊙ Stored water only Supp 123¹/₂ acres

RECEIVED OCT 24 2019

FEB 03 2020 OWRD

OWRD

Application Map
for
Sabre Ridge Ranch, LLC

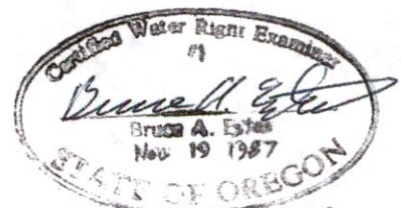

Sheet 2 of 2

ESTES SURVEYS, LLC

PO Box 47610 Salem, OR 97305-7649 (503) 585-7689	60302 Arnold Rd Bend, OR 97702 (541) 382-7391
--	---

This map is for the purpose of locating a water right only and has no intent to provide legal dimensions or the location of property lines.

S-88814

RECEIVED


MAR 02 2020

RECEIVED

OCT 24 2019

T. 17S., R. 21E., W.M. OWRD

OWRD

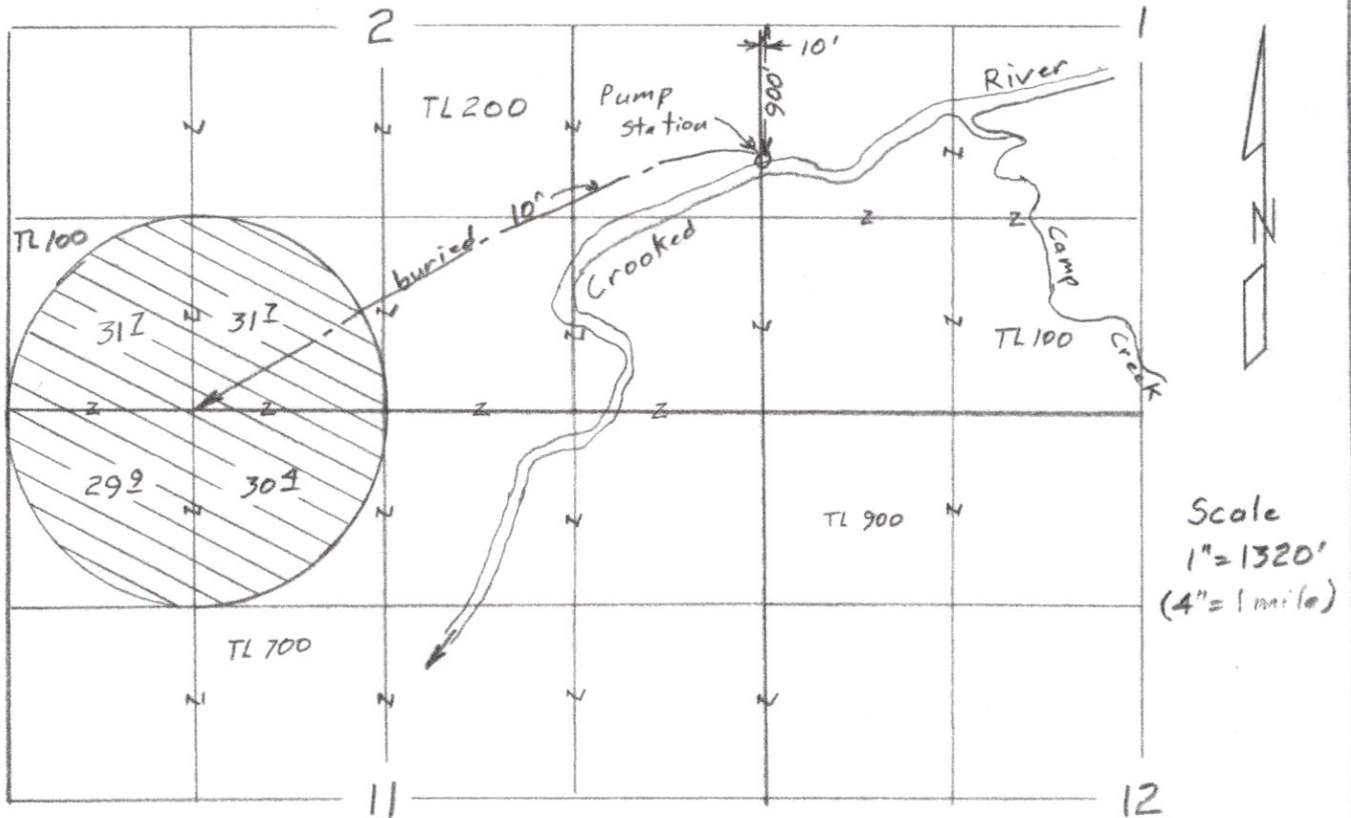


⊗ Stored water only Supp 123¹ acres

RECEIVED

FEB 03 2020

OWRD

Application Map
for
Sabre Ridge Ranch, LLC

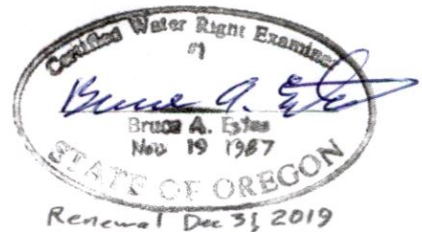

Sheet 2 of 2

ESTES SURVEYS, LLC
 PO Box 47610 60382 Arnold Rd
 Salem, OR 97306-7549 Bend, OR 97702
 (503) 586-7688 (541) 382-7391

This map is for the purpose of locating a water right only and has no intent to provide legal dimensions or the location of property lines.