

CLAIM OF BENEFICIAL USE AND SITE REPORT

IN THE NAME OF JAMES AND ROBERTA SMITH

APPLICATION S-72411 PERMIT 52552

SECTION 31, TOWNSHIP 25 SOUTH, RANGE 11 WEST, W.M.

GENERAL INFORMATION

The methods and documents used to determine the information contained in this document:

1. Examination of Assessor Map 25-11-31,
2. Examination of Arial Photograph 25-11-31,
3. On-site survey, 30 September, 2000,
4. Interview with James Smith, 30 September, 2000.

SOURCE

South Fork Coos River, a tributary of Coos River.

USE AND PLACE OF USE

35.4 acres of irrigation of hay and pasture, and stockwater; being:
4.9 acres: NE1/4 NE1/4 and stockwater,
13.9 acres: SW1/4 NE1/4 and stockwater,
10.4 acres: SE1/4 NE1/4 and stockwater,
6.2 acres: NW1/4 SE1/4 and stockwater; all being within Section 31, Township 25 South, Range 11 West, W.M., Coos County.

POINT OF DIVERSION

The point of diversion is located 3380 feet north and 1700 feet east from the south 1/4 corner of Section 31, being within the SE1/4 NE1/4 Section 31, Township 25 South, Range 11 West, W.M., Coos County.

DIVERSION WORKS AND DELIVERY SYSTEM

Irrigation: A 50 horsepower electric motor/centrifugal pump diverts and delivers water to the place of use via a 6" metered P.V.C. pipeline. Irrigation is by two wheel-mounted "Big-Gun" irrigation units having orifice diameters of 1 3/16" and 1 1/16".
Stockwater: Garden hoses connected to the 6" P.V.C. pipeline deliver water to portable stocktanks as required.

Motor: Marathon,
Frame#: 32ZJP,
Model#: YM324TIDP8211AA.

RECEIVED

OCT 02 2000

CLAIM OF BENEFICIAL USE - SMITH - PERMIT 52552

Pump: Berkeley,
Model#: B32PL,
Serial#: G020393,
Intake: 4-inch,
Discharge: 3 1/2-inch.

Meter: McCrometer,
Size: 6-inch,
Serial#: 99-7988-6.

DELIVERY SYSTEM CAPACITY

By observation of the meter, the capacity of the system was determined to be 450 gallons/minute.

RECEIVED


OCT 02 2000

WATER RESOURCES DEPT.
SALEM, OREGON

CLAIM OF BENEFICIAL - SMITH - PERMIT 52552

CERTIFICATION

The Final Proof Survey Map and Site Inspection Report associated with Permit 52552 were completed by James F. Gosson, Certified Water Right Examiner #54, on 30 September, 2000, and the facts contained herein are correct to the best of my knowledge.

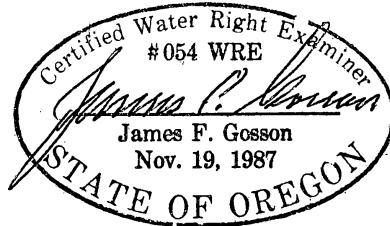

We, James and Roberta Smith, agree with the findings of James F. Gosson, Certified Water Right Examiner #54, and submit this Site Inspection Report and Final Proof Survey Map as the Claim of Beneficial Use of Permit 52552.

James A Smith
Signature

10-1-2000
Date

Roberta A Smith
Signature

10-1-00
Date

RECEIVED
OCT 12 2000
3

RECEIVED
OCT 02 2000
WATER RESOURCES DEPT.
SALEM, OREGON


FINAL PROOF SURVEY MAP

IN THE NAME OF JAMES AND ROBERTA SMITH

SECTION 31, TOWNSHIP 25 SOUTH, RANGE 11 WEST, W.M.

APPLICATION S-72411

PERMIT 52552

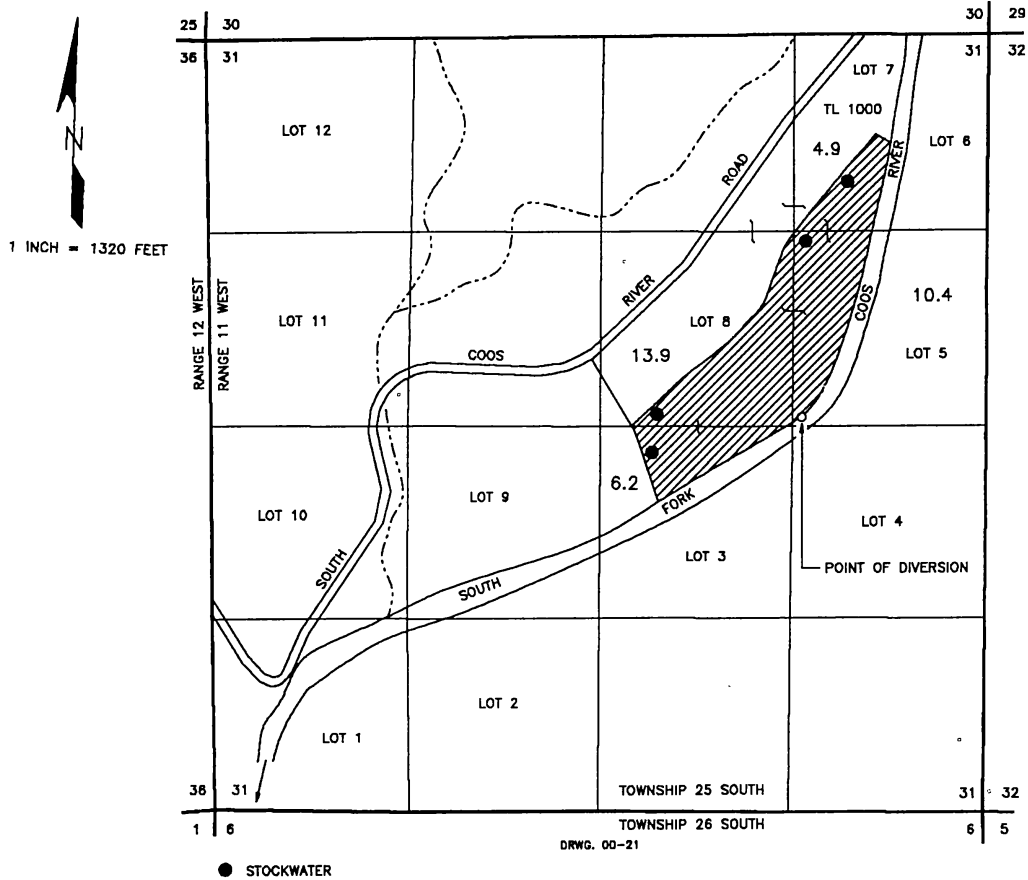

The point of diversion is located 3380 feet north and 1700 feet east from the south 1/4 corner of Section 31, being within the SE 1/4 NE 1/4 Section 31, Township 25 South, Range 11 West, W.M., Coos County.

The purpose of this map is to identify the location of the water right. It is not intended to provide information relative to the location of property ownership boundary lines.

