



Herbert Farms Inundation Map

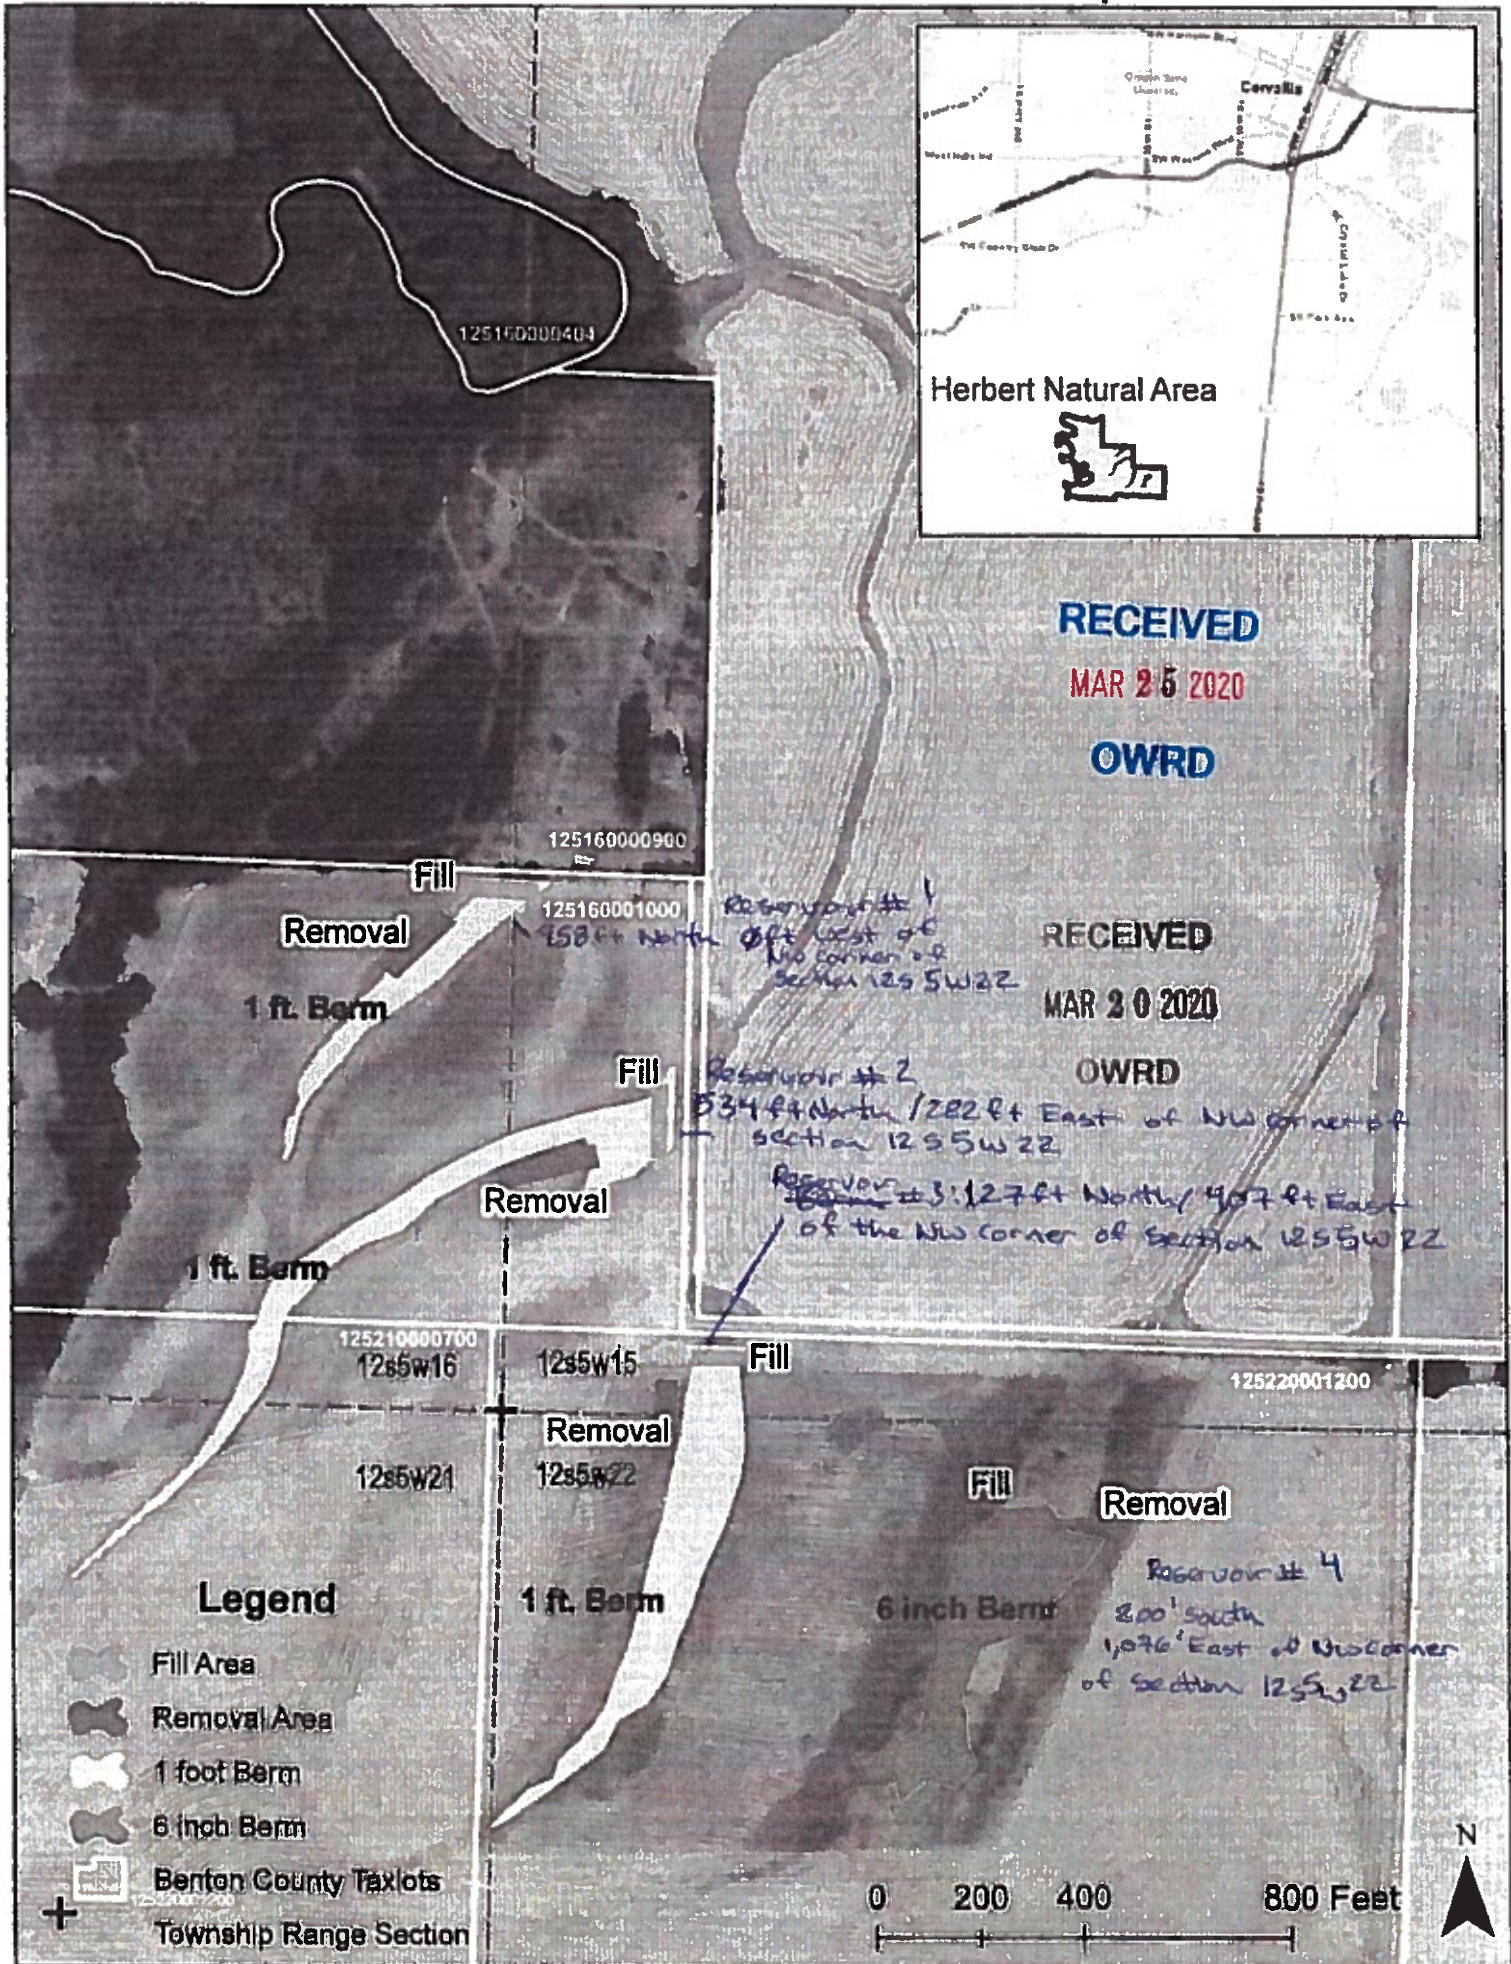

Herbert Farms Inundation Map

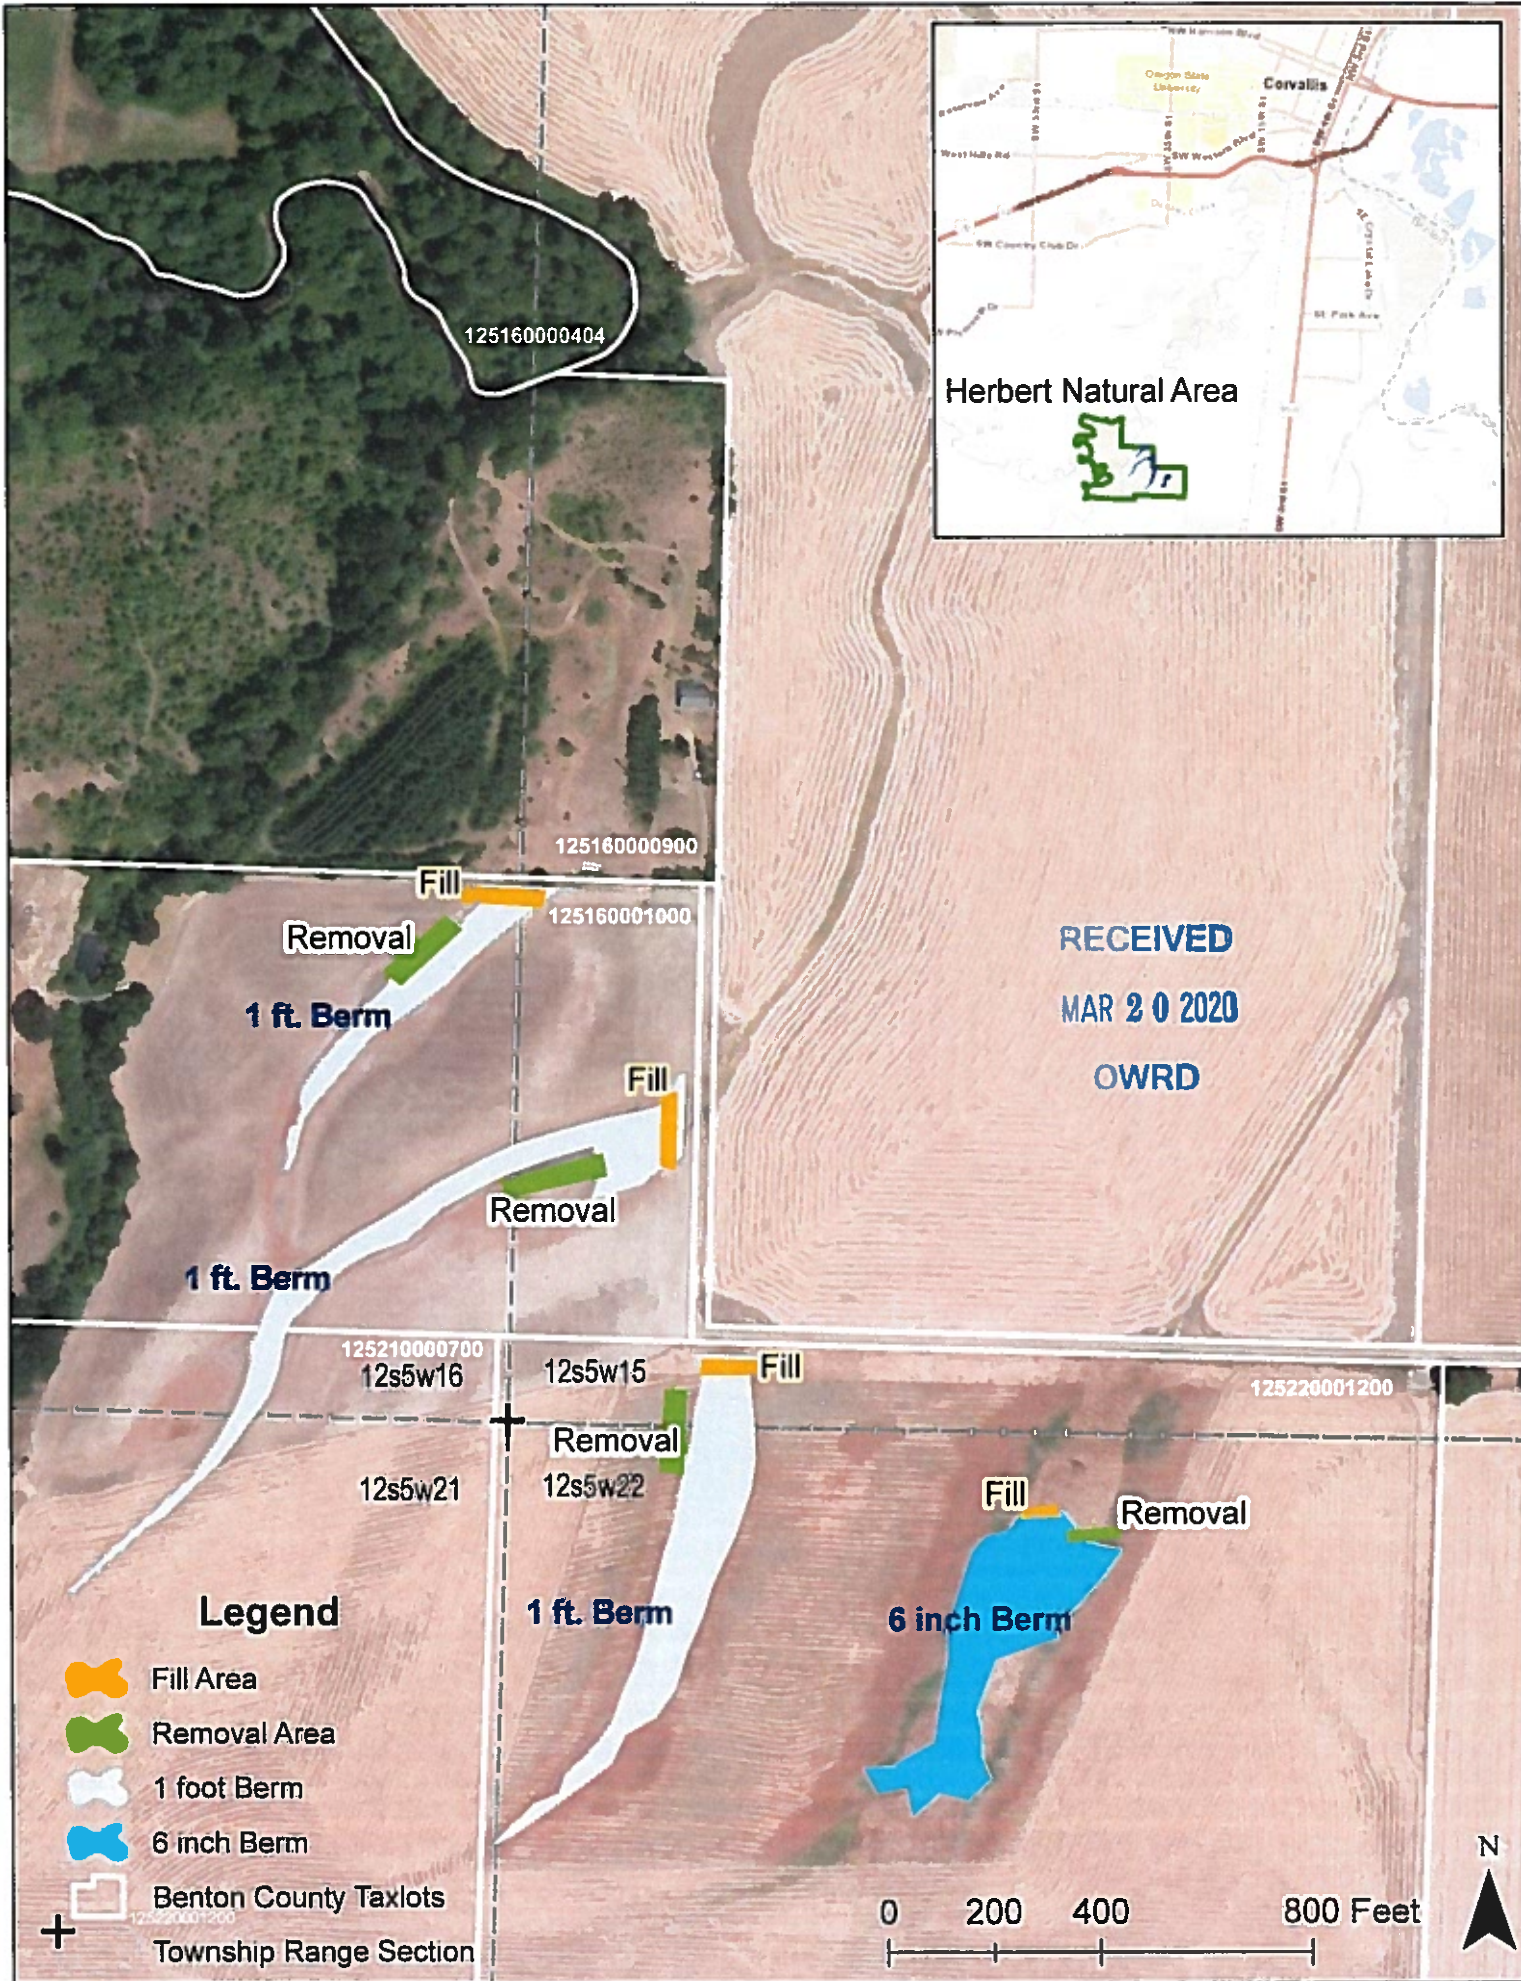


THIS MAP WAS PREPARED FOR ASSESSMENT PURPOSE ONLY

SECTION 16 T.12S. R.5W. W.M.
BENTON COUNTY
1" = 400'

0 200 400 800 Feet

12516

REV 12-20-2010
CANCELLED
400 THRU 403
500
701
800

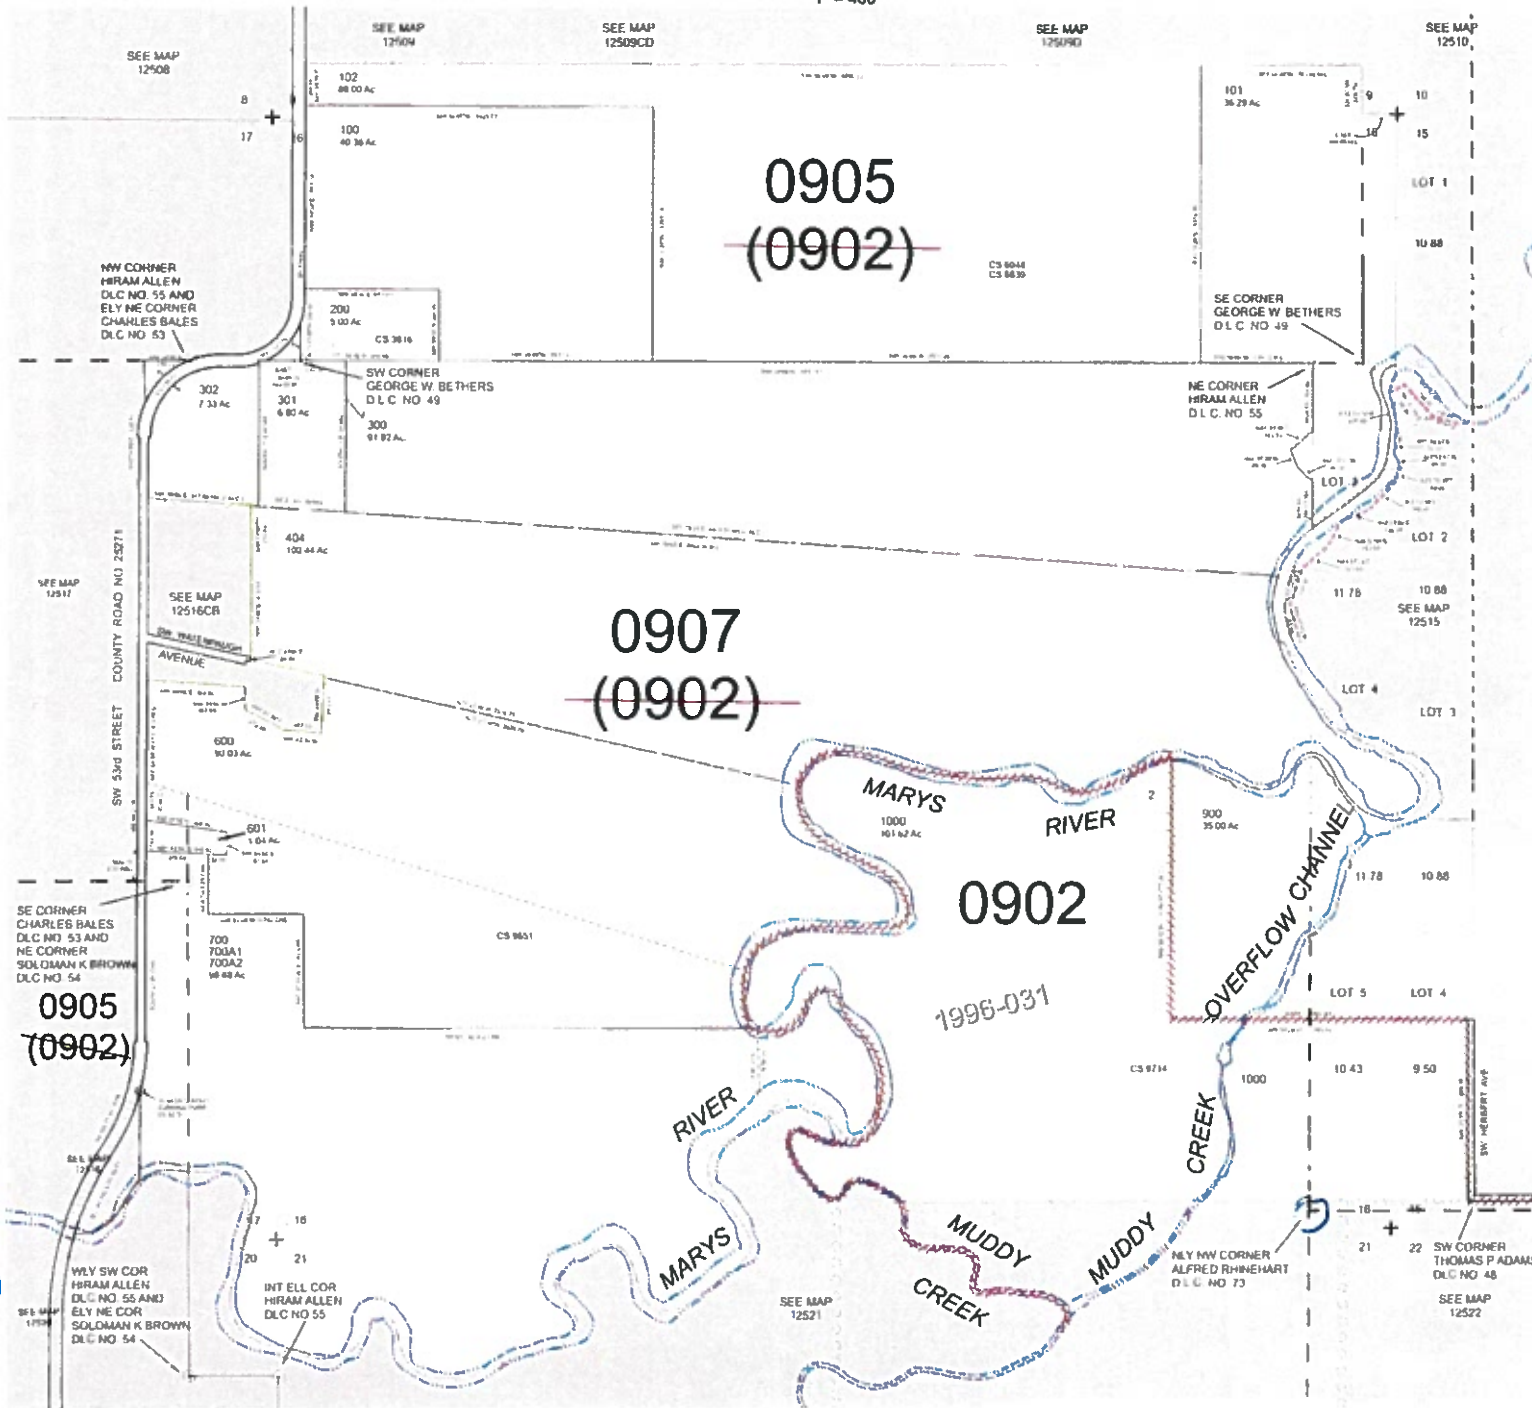

RECEIVED
MAR 20 2020
OWRD

RECEIVED
SEP 19 2019
OWRD

12516