


Herbert Farms Inundation Map




THIS MAP WAS PREPARED FOR ASSESSMENT PURPOSE ONLY

SECTION 16 T.12S. R.5W. W.M.
BENTON COUNTY
1" = 400'

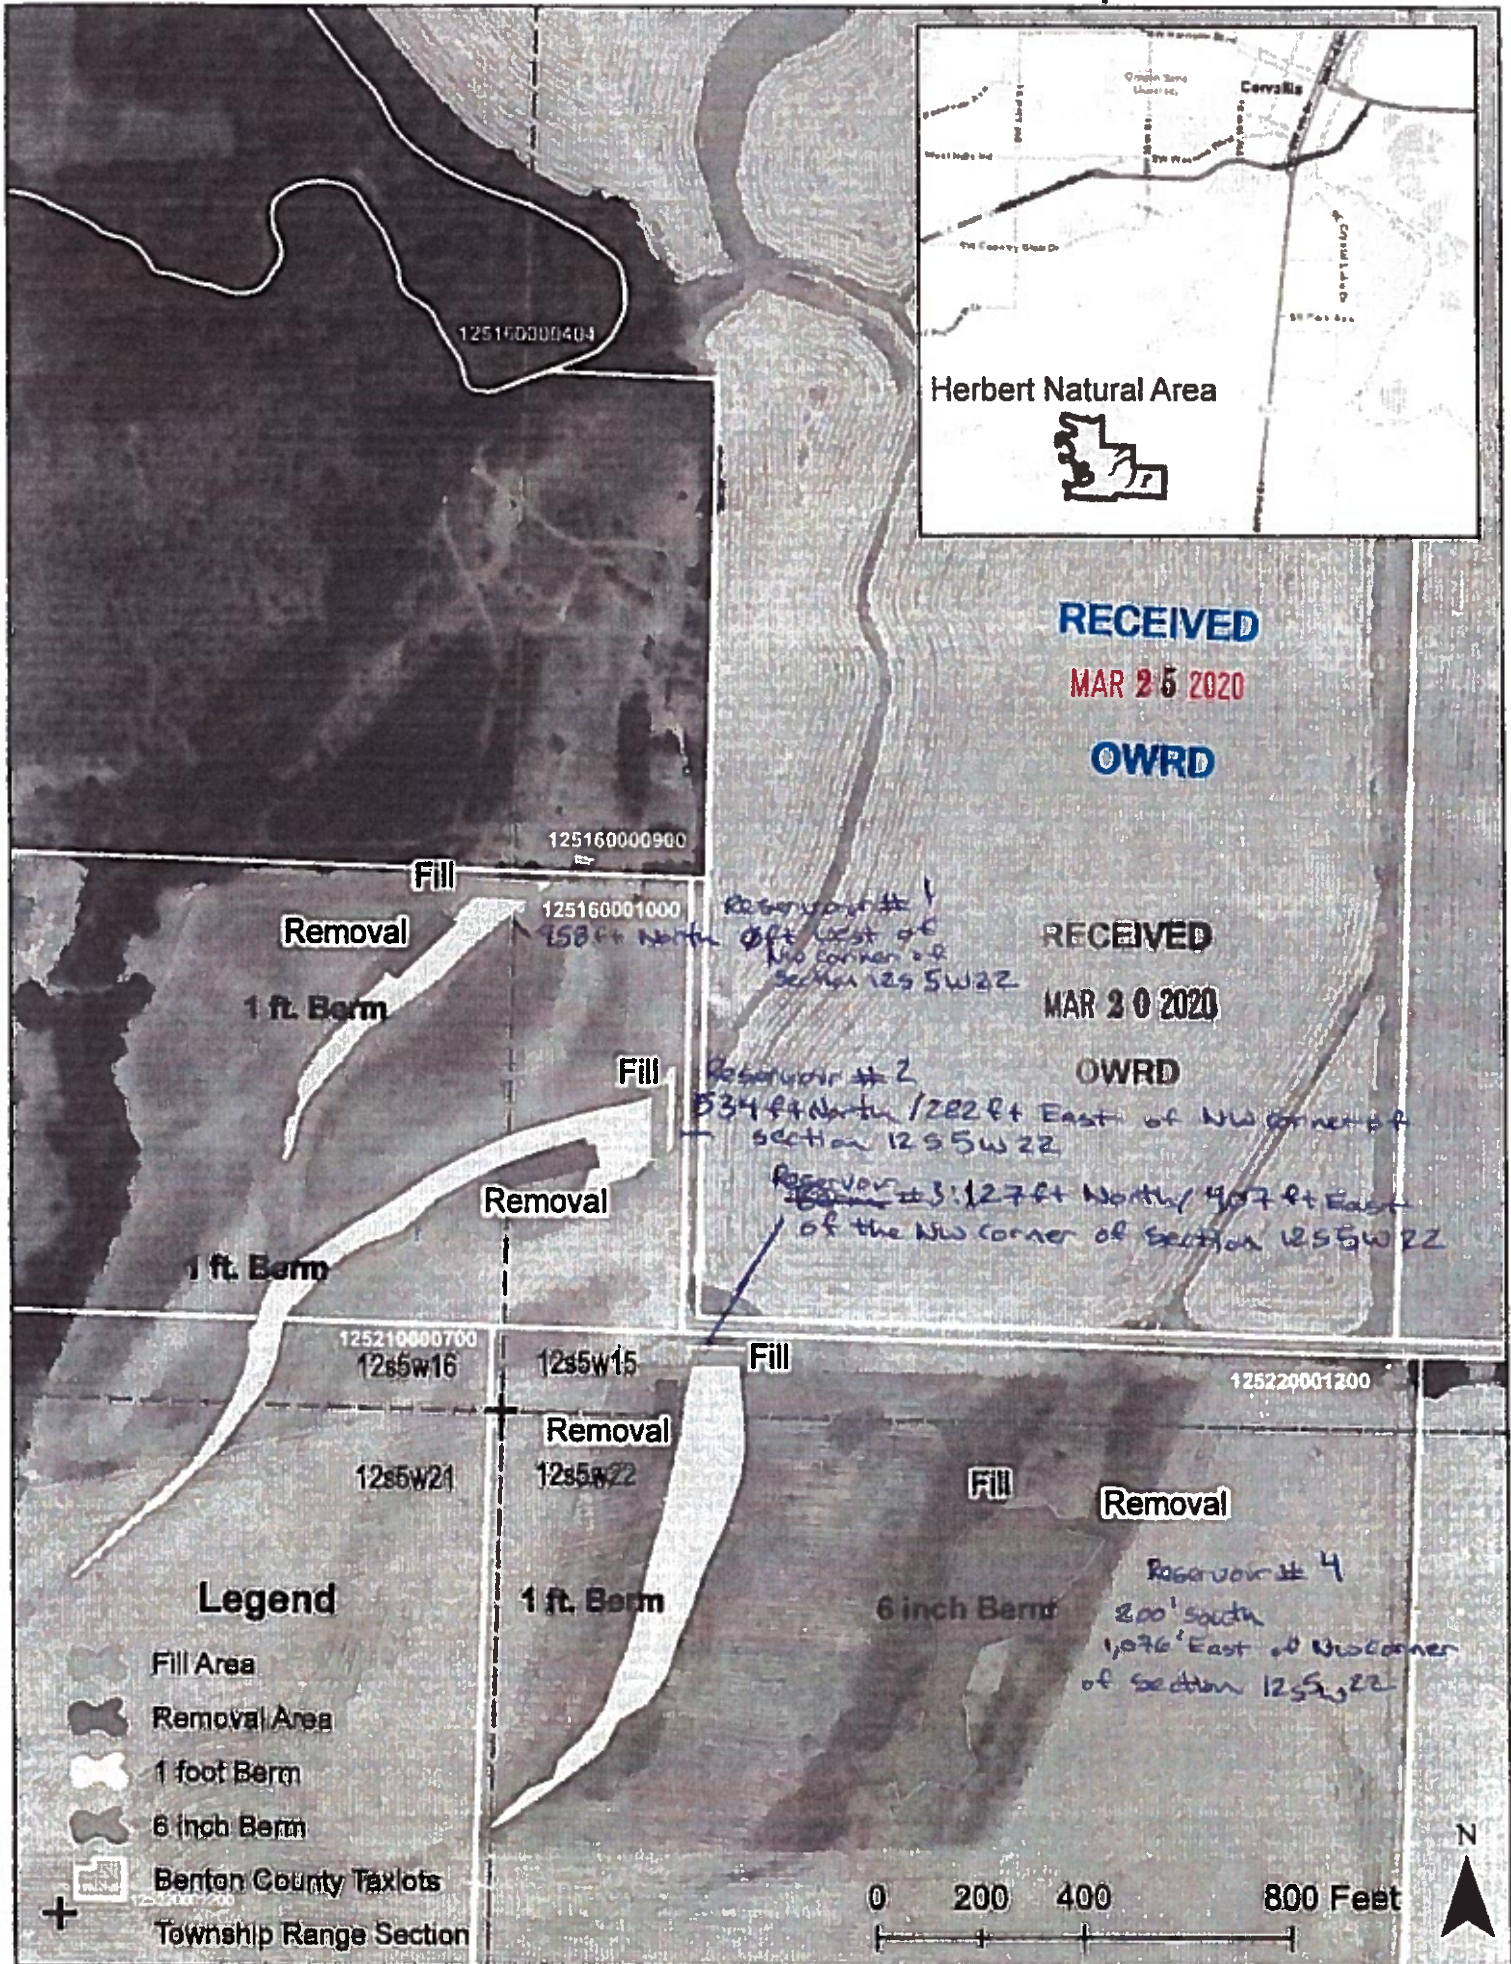

12516

REV 12-20-2010
CANCELLED
400 THRU 403
500
701
800

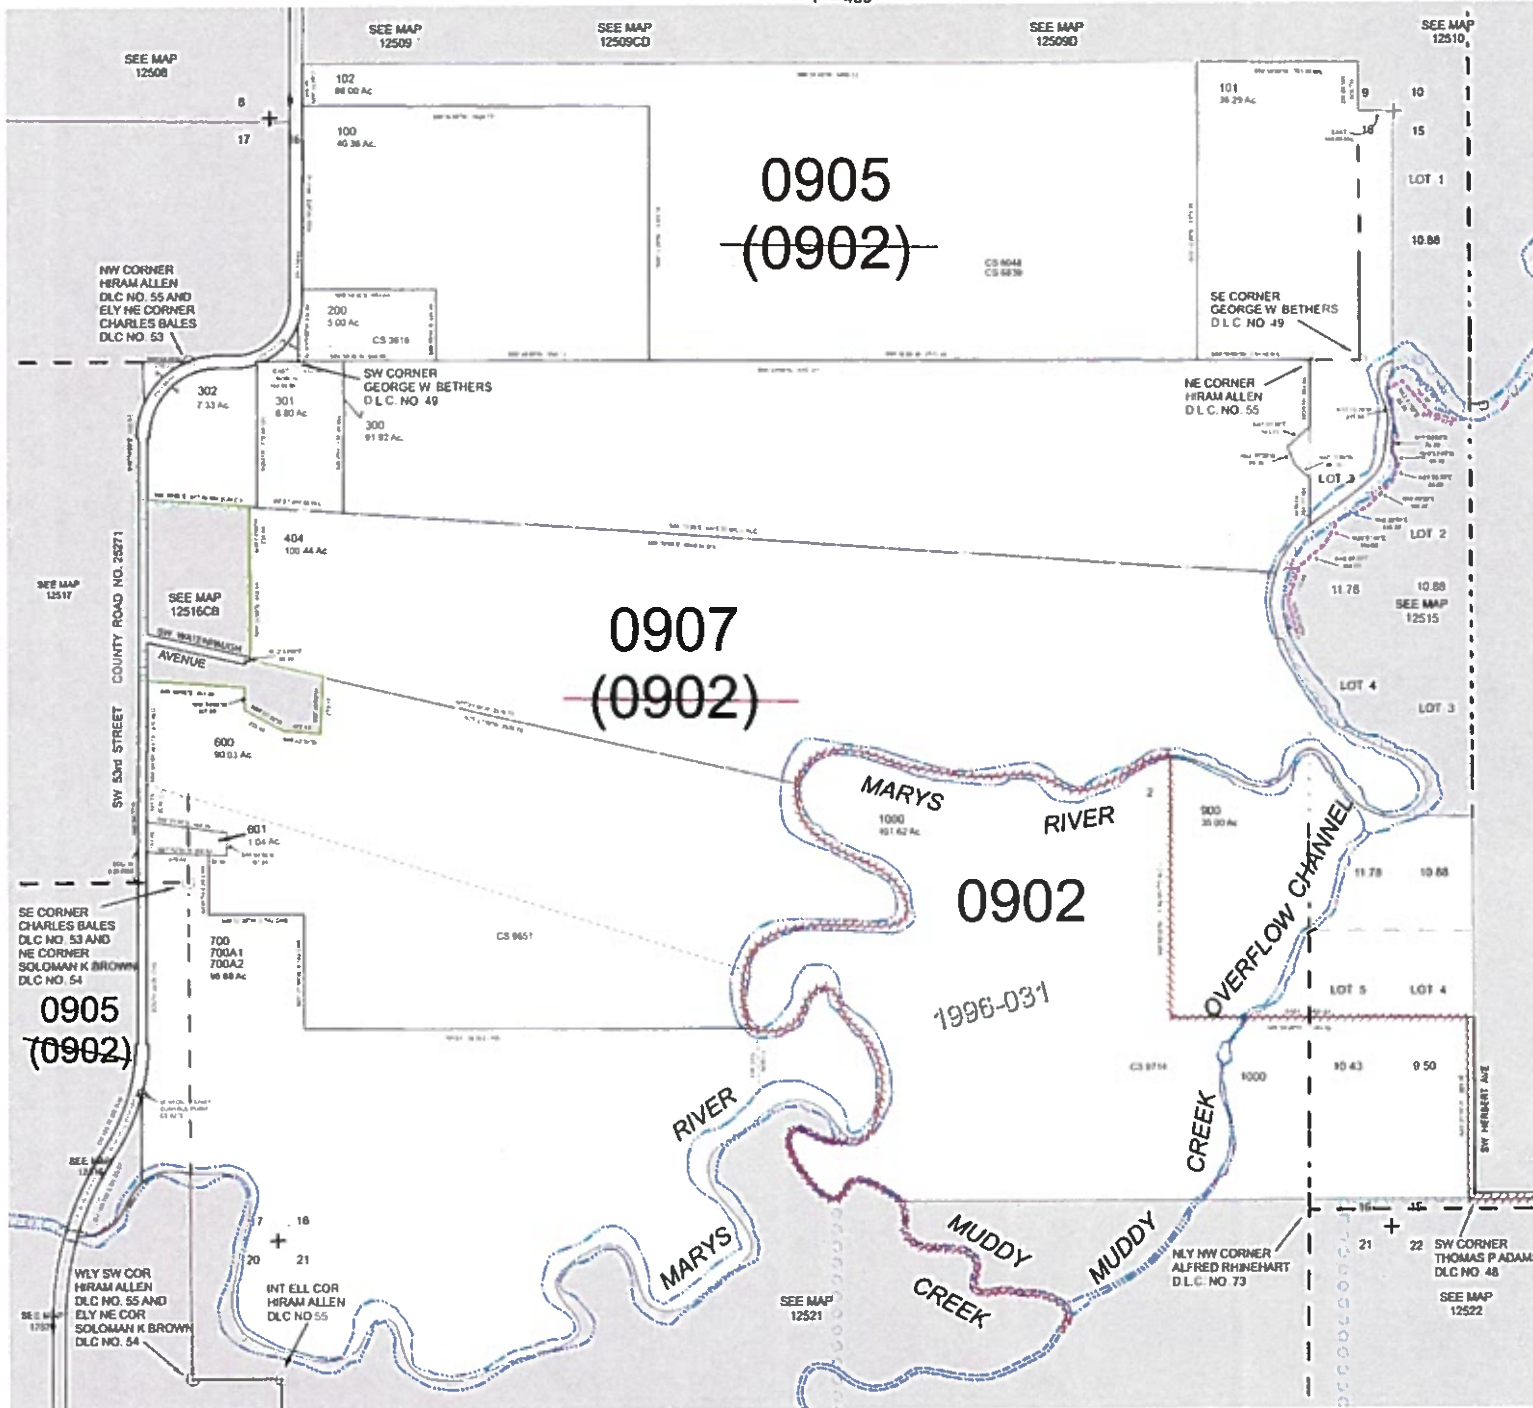


RECEIVED
MAR 2 0 2020
OWRD

RECEIVED
SEP 1 9 2019
OWRD

12516

9-02)
9-07

RECEIVED
MAR 20 2020
OWRD

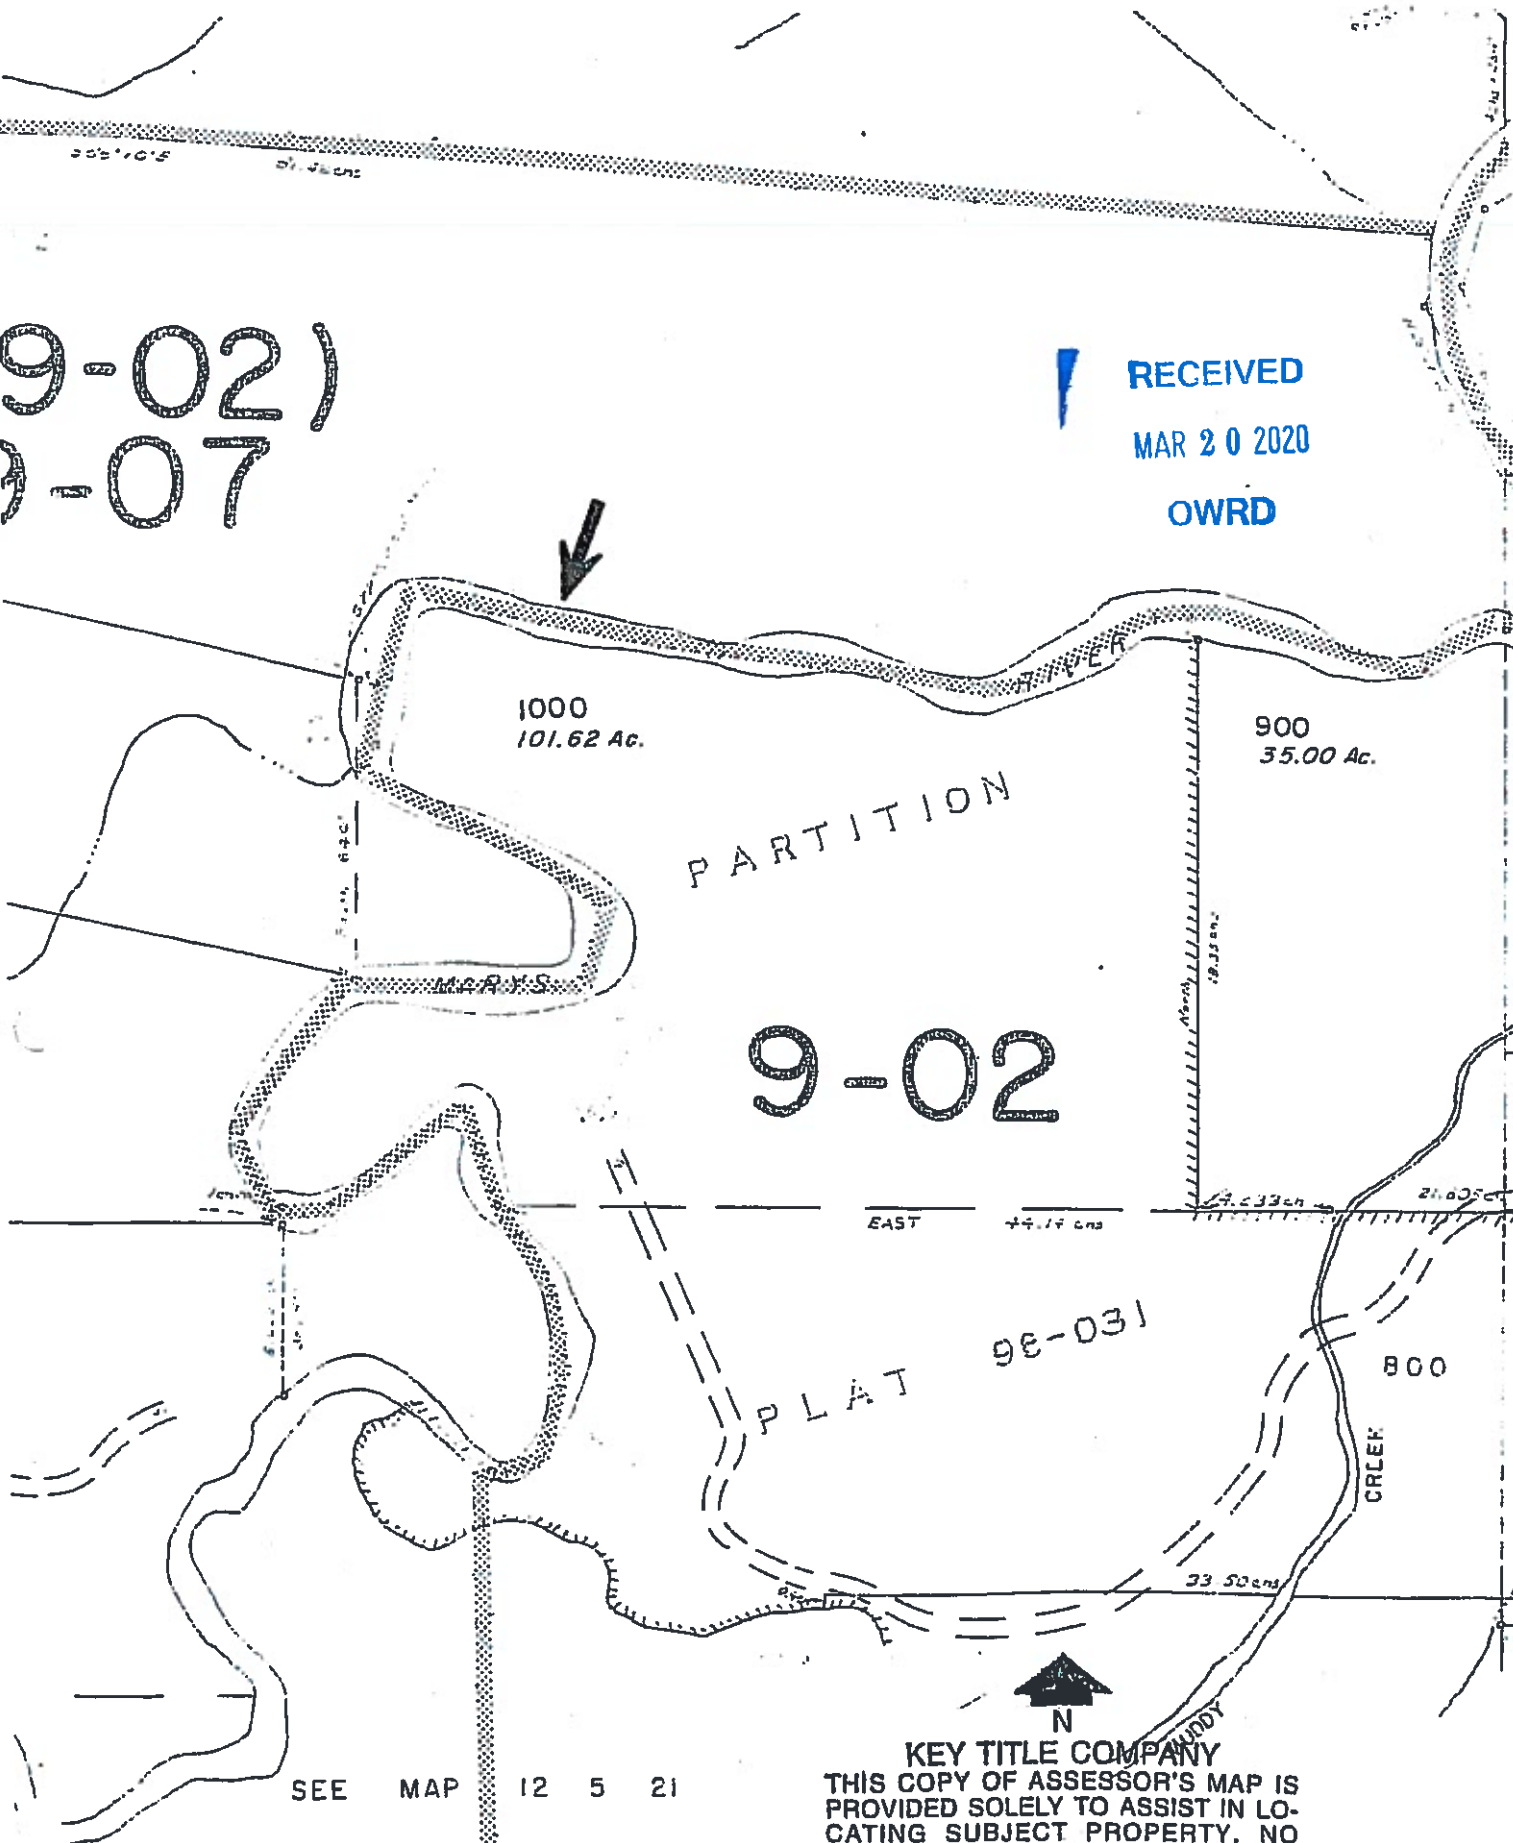

9-02

SEE MAP 12 5 21

KEY TITLE COMPANY
 THIS COPY OF ASSESSOR'S MAP IS PROVIDED SOLELY TO ASSIST IN LOCATING SUBJECT PROPERTY. NO LIABILITY IS ASSUMED BY KEY FOR DISCREPANCIES IN THIS MAP AS OUTLINED AND THE ACCOMPANYING LEGAL DESCRIPTION.


5W. W.M.

NTY

12 5 21
REV. 03-19-97
CANC.

301
503
100

00
76.03 Ac.

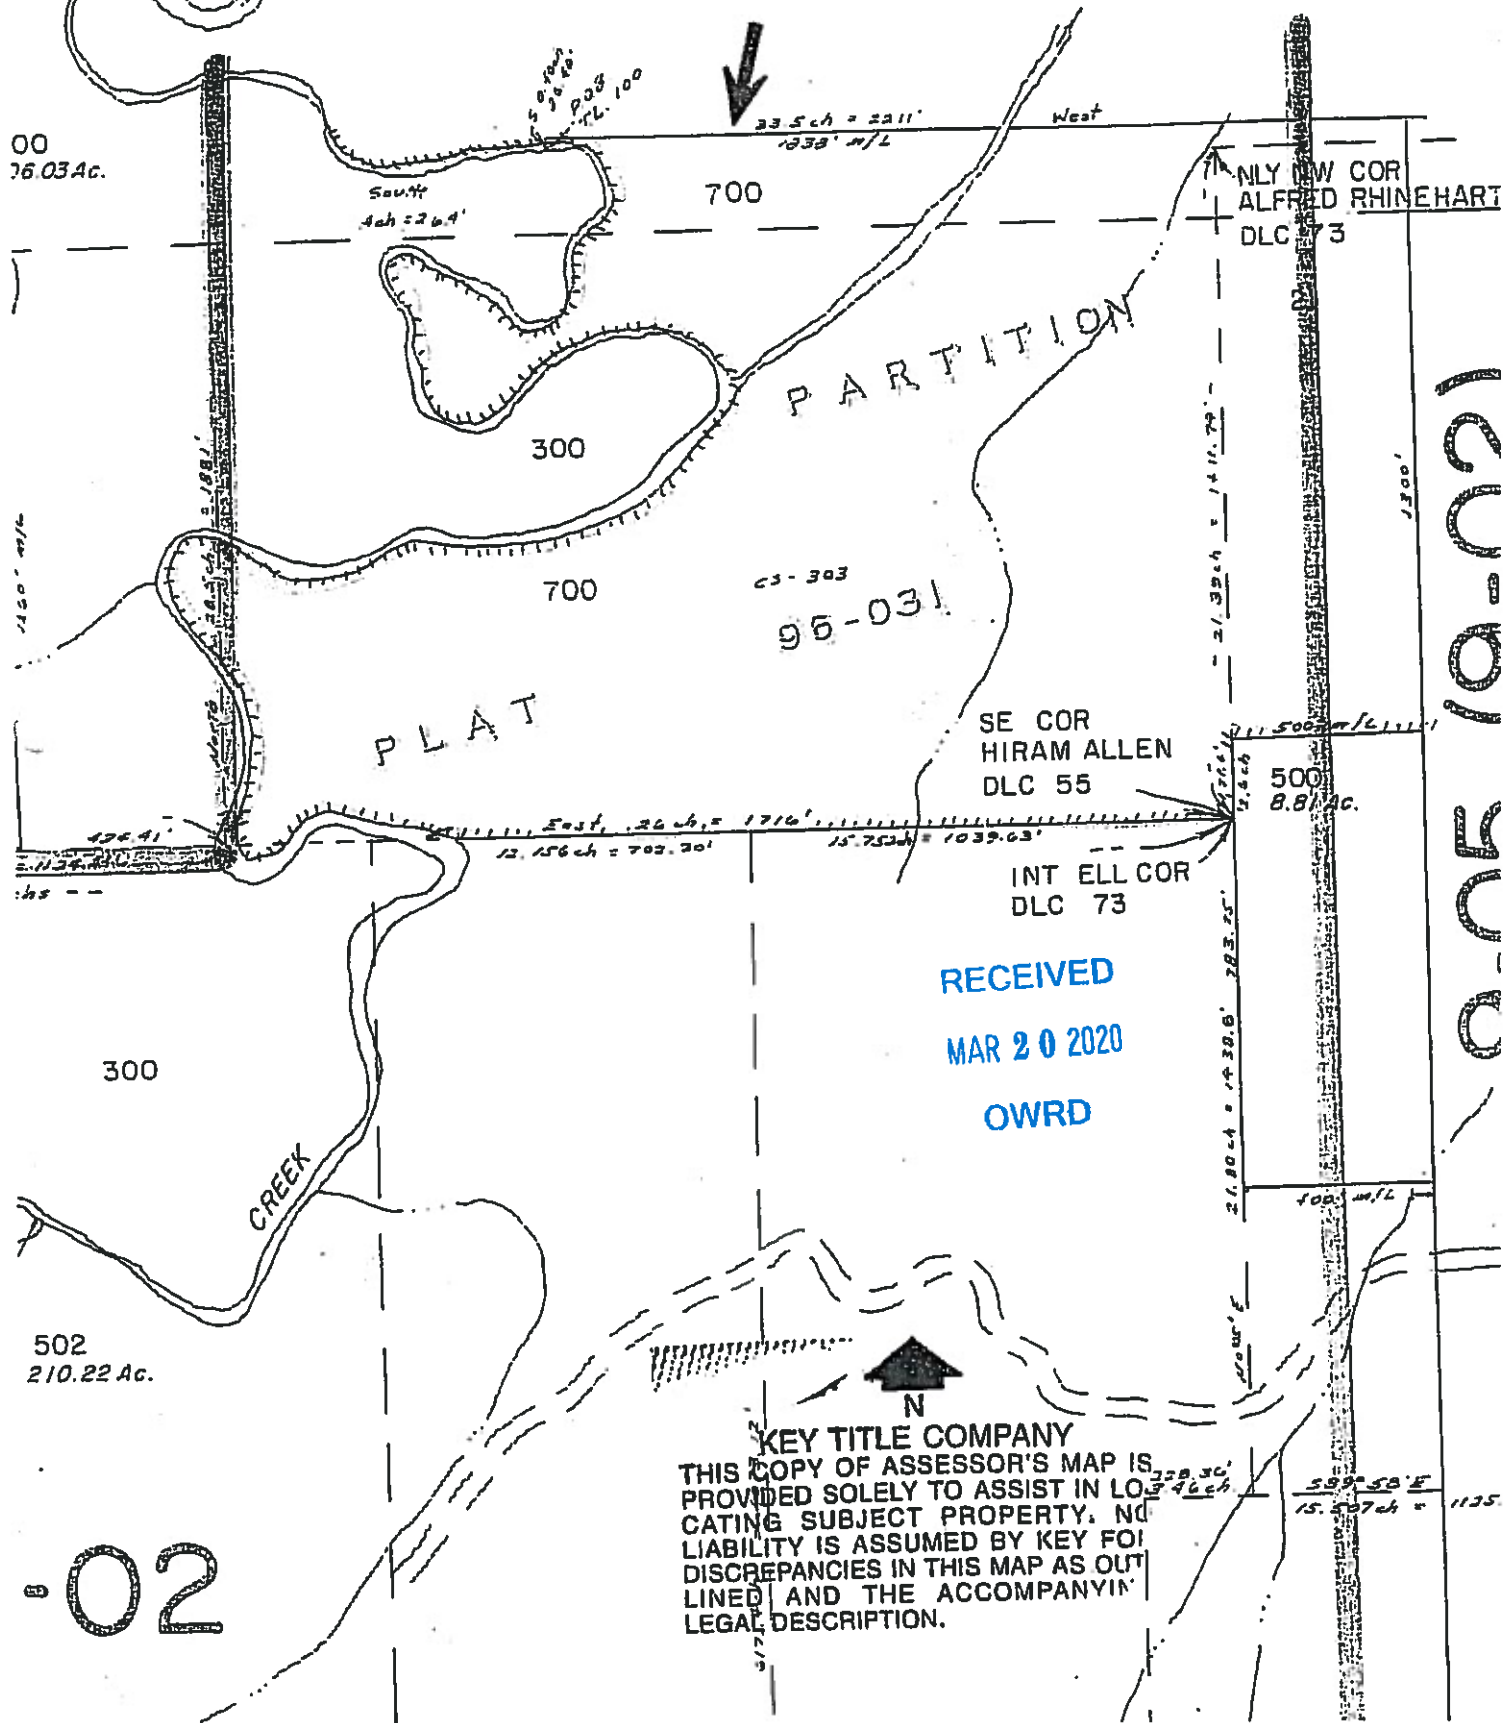

RECEIVED
MAR 20 2020
OWRD

KEY TITLE COMPANY
THIS COPY OF ASSESSOR'S MAP IS
PROVIDED SOLELY TO ASSIST IN LOCATING
SUBJECT PROPERTY. NO LIABILITY IS ASSUMED BY KEY FOR
DISCREPANCIES IN THIS MAP AS OUTLINED
AND THE ACCOMPANYING LEGAL DESCRIPTION.

02





KEY TITLE COMPANY
 THIS COPY OF ASSESSOR'S MAP IS PROVIDED SOLELY TO ASSIST IN LOCATING SUBJECT PROPERTY. NO LIABILITY IS ASSUMED BY KEY FOR DISCREPANCIES IN THIS MAP AS OUTLINED AND THE ACCOMPANYING LEGAL DESCRIPTION.

SEC

SEE MAP 12

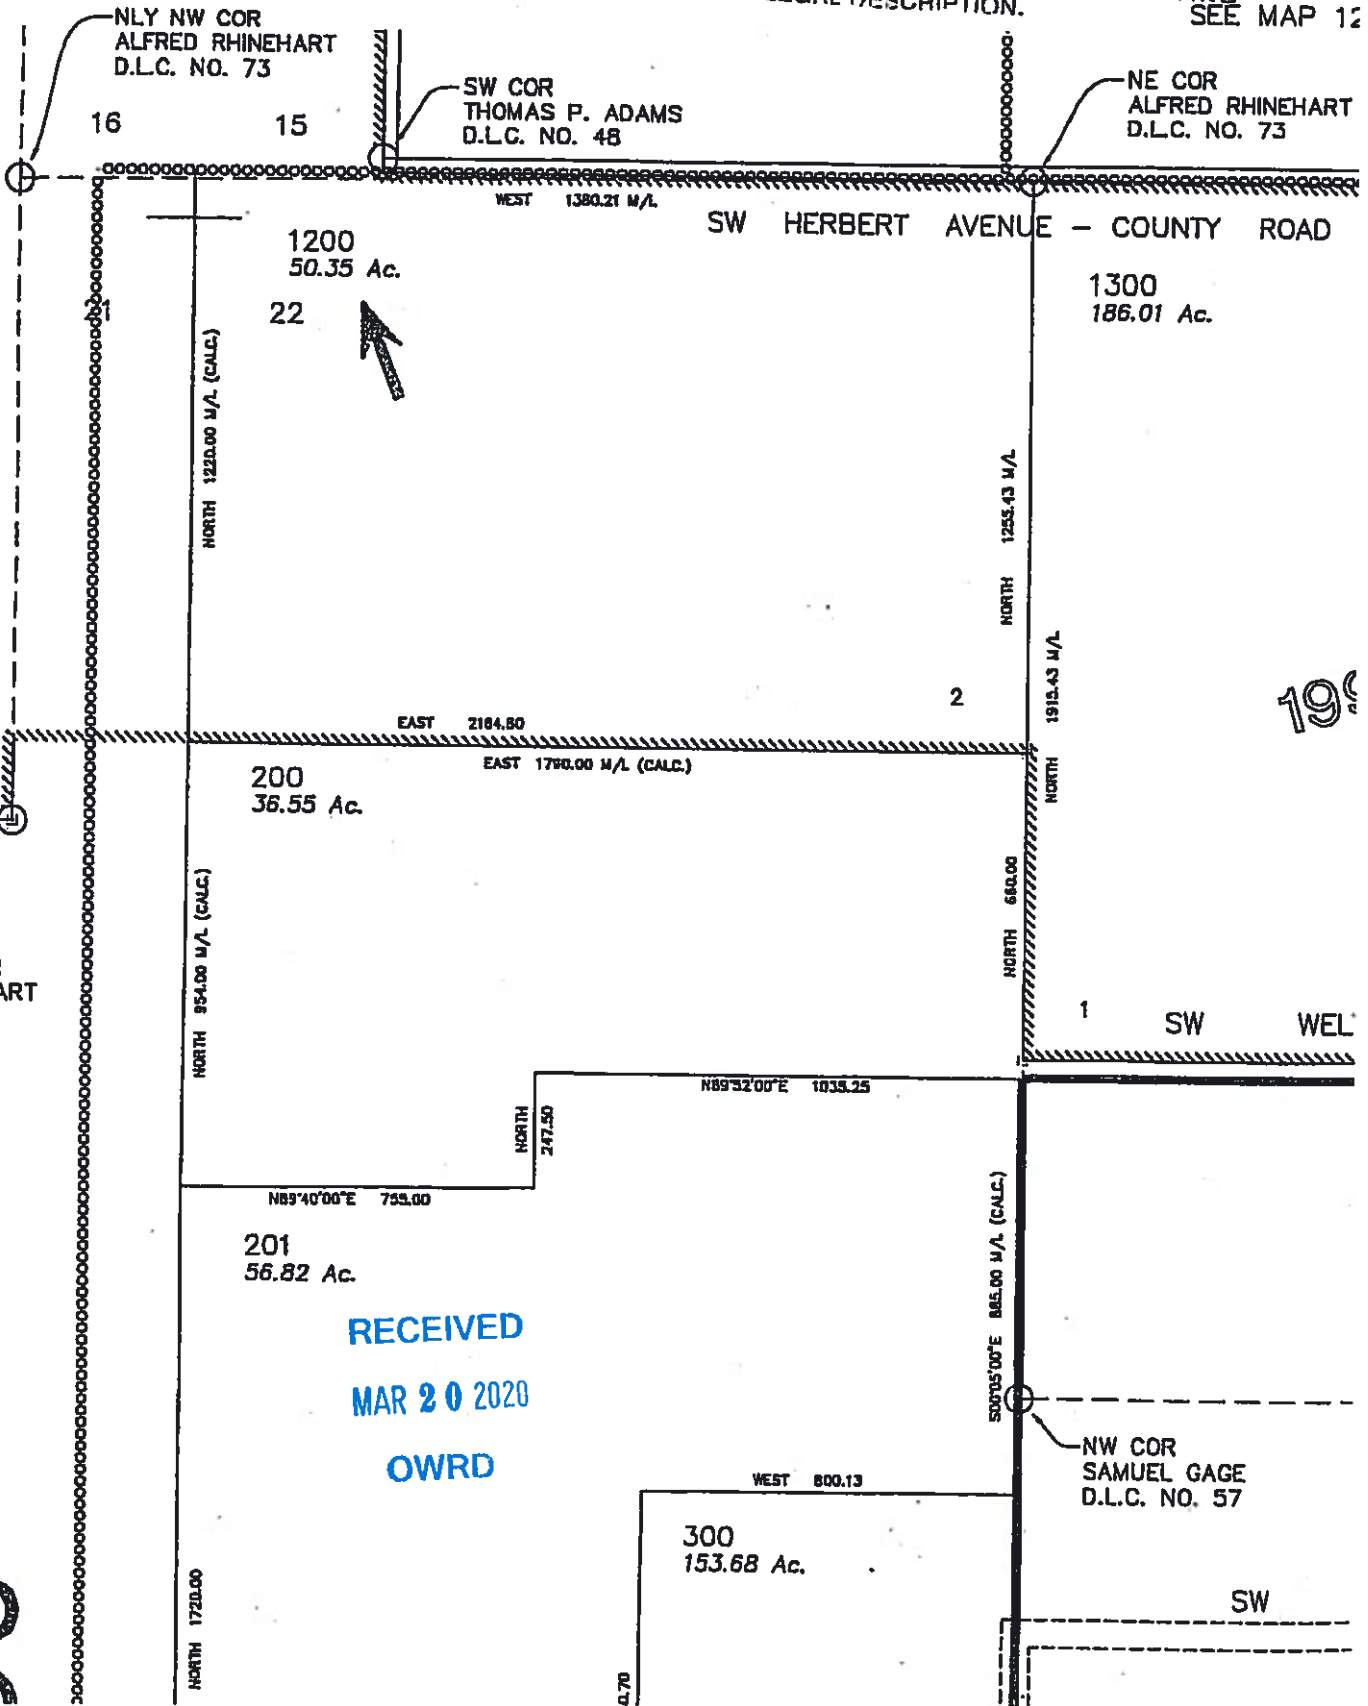

19^{ac}

COR AM ALLEN
 D.C. NO. 55
 ELL CORNER
 RED RHINEHART
 D.C. NO. 73

RECEIVED
 MAR 20 2020
 OWRD

SEE MAP 12 5 21

30