


04 1W 05B
CLACKAMAS
COUNTY

04 1W 05B

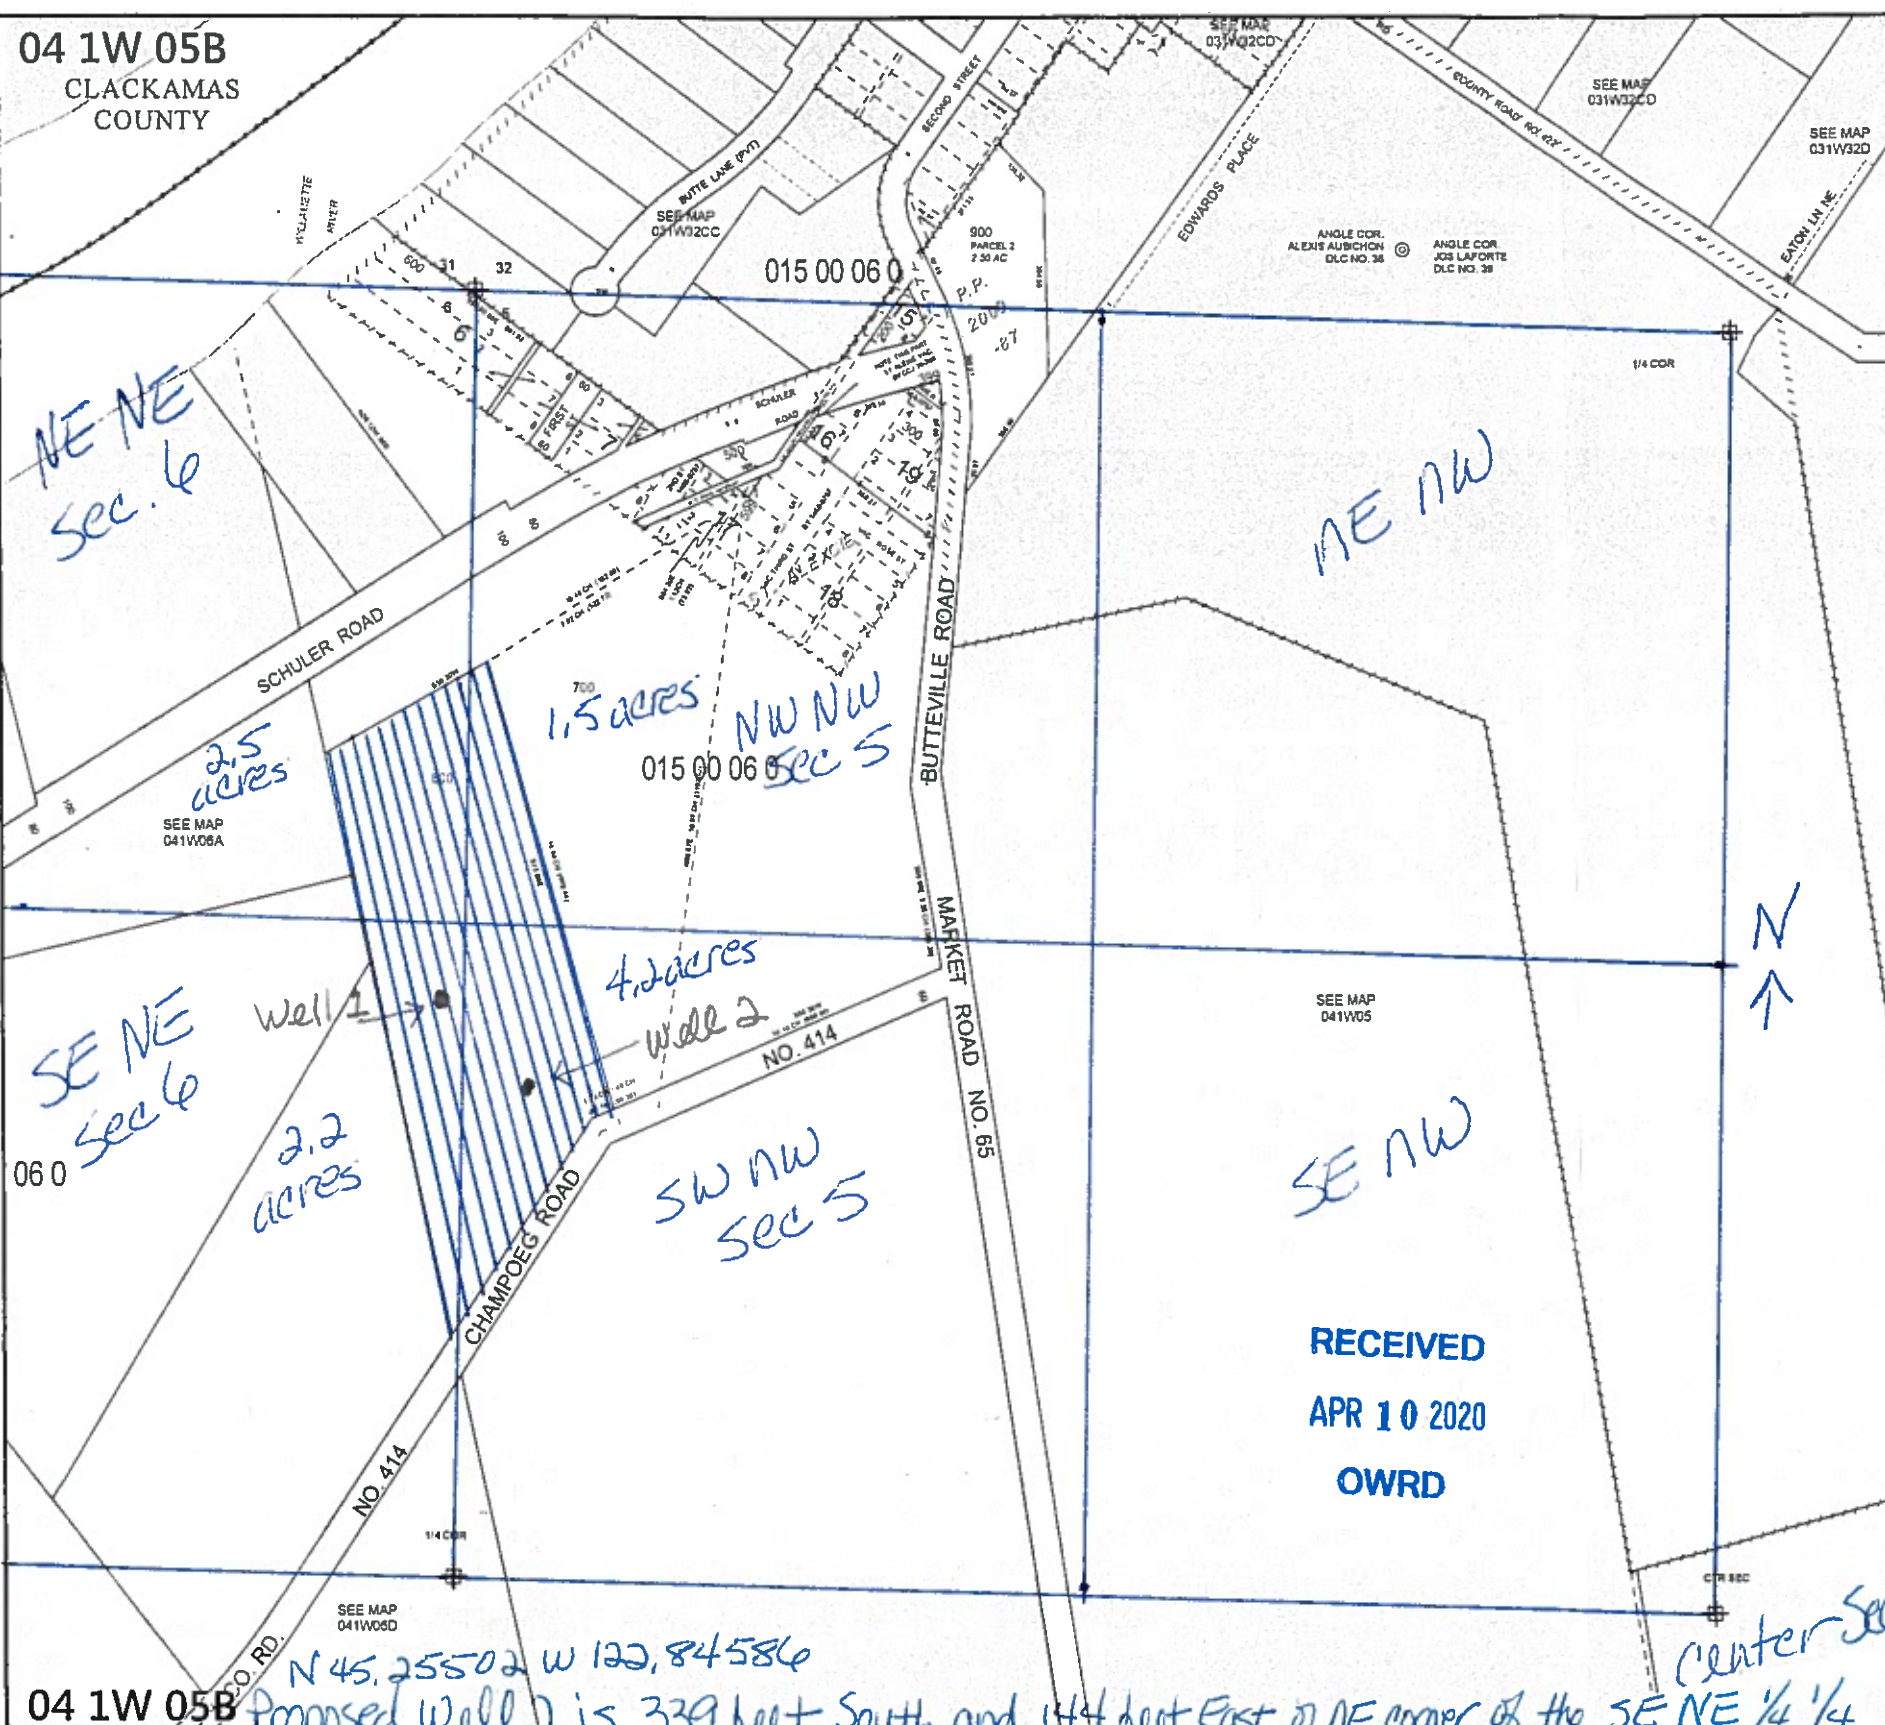

MARION COUNTY, OREGON
NW1/4 SEC5 T4S R1W W.M.
SCALE

LEGEND

- LINE TYPES
- Taxlot Boundary
 - Road Right-of-Way
 - Railroad Right-of-Way
 - Private Road ROW
 - Subdivision/Plat Bndry
 - Waterline - Taxlot Bndry
 - Historical Boundary
 - Easement
 - Railroad Centerline
 - Taxcode Line
 - Map Boundary
 - Waterline - Non Bndry

- CORNER TYPES
- + 1/16TH Section Cor.
 - ⊙ DIC Corner
 - ⊕ 1/4 Section Cor
 - 16, 15 Section Corner
 - 21, 22

NUMBERS
Tax Code Number
000 00 00 0

Acreage 2.2 AC All acres listed are Net Acres, excluding any portions of the taxlot within public ROWs

NOTES
Tick Marks: A tick mark in the road indicates that the labeled dimension extends into the public ROW

CANCELLED NUMBERS

400			
-----	--	--	--

DISCLAIMER: THIS MAP WAS PREPARED FOR ASSESSMENT PURPOSES ONLY



FOR ADDITIONAL MAPS VISIT OUR WEBSITE AT www.co.marion.or.us

PLOT DATE: 1/23/2018

04 1W 05B

04 1W 05B N 45.25502 W 122.84586
Proposed Well 2 is 339 feet South and 144 feet East of NE corner of the SE NE 1/4 1/4
Well 1 is 147 feet South and 54 feet West of the NE corner of the SE NE 1/4 1/4 - N 45.25557 W 122.84669

Scale 1" = 400'

RECEIVED
APR 10 2020
OWRD