


T 8 S., R. 2 W., W.M.

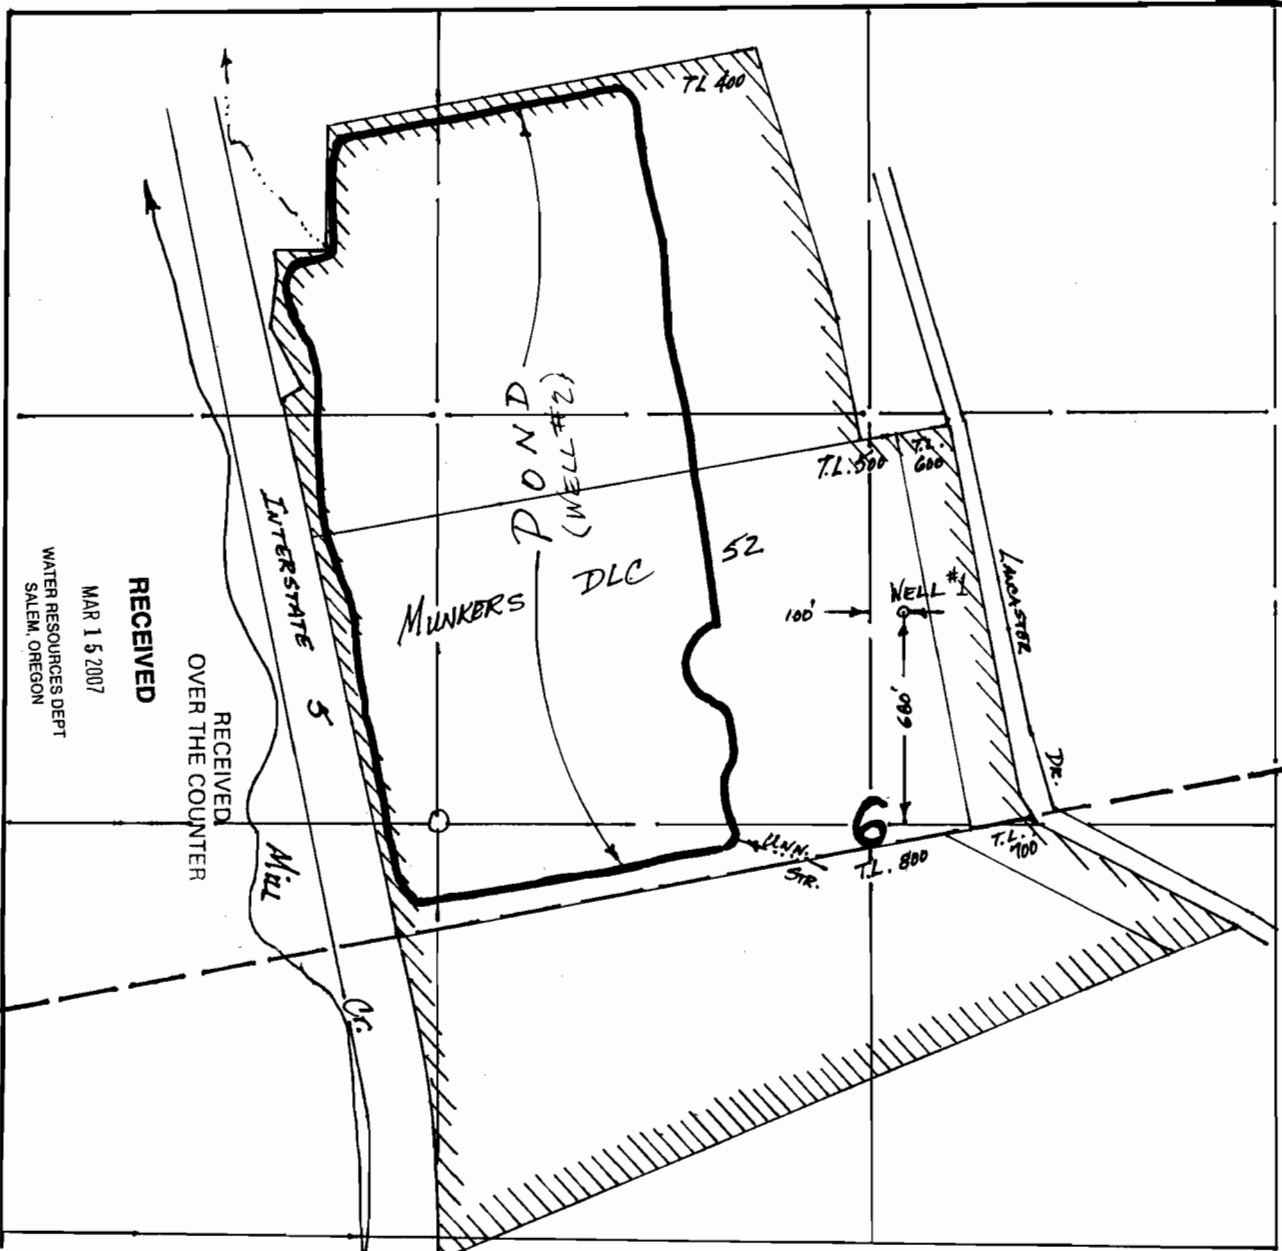

RECEIVED
MAR 15 2007
WATER RESOURCES DEPT
SALEM, OREGON

RECEIVED
OVER THE COUNTER

INDUSTRIAL USE AREA BOUNDARY 

Application Map for
Walling Properties, LLC

N

SCALE 1" = 400'

01/07 XLR