T 8S., R. 2W., W.M.

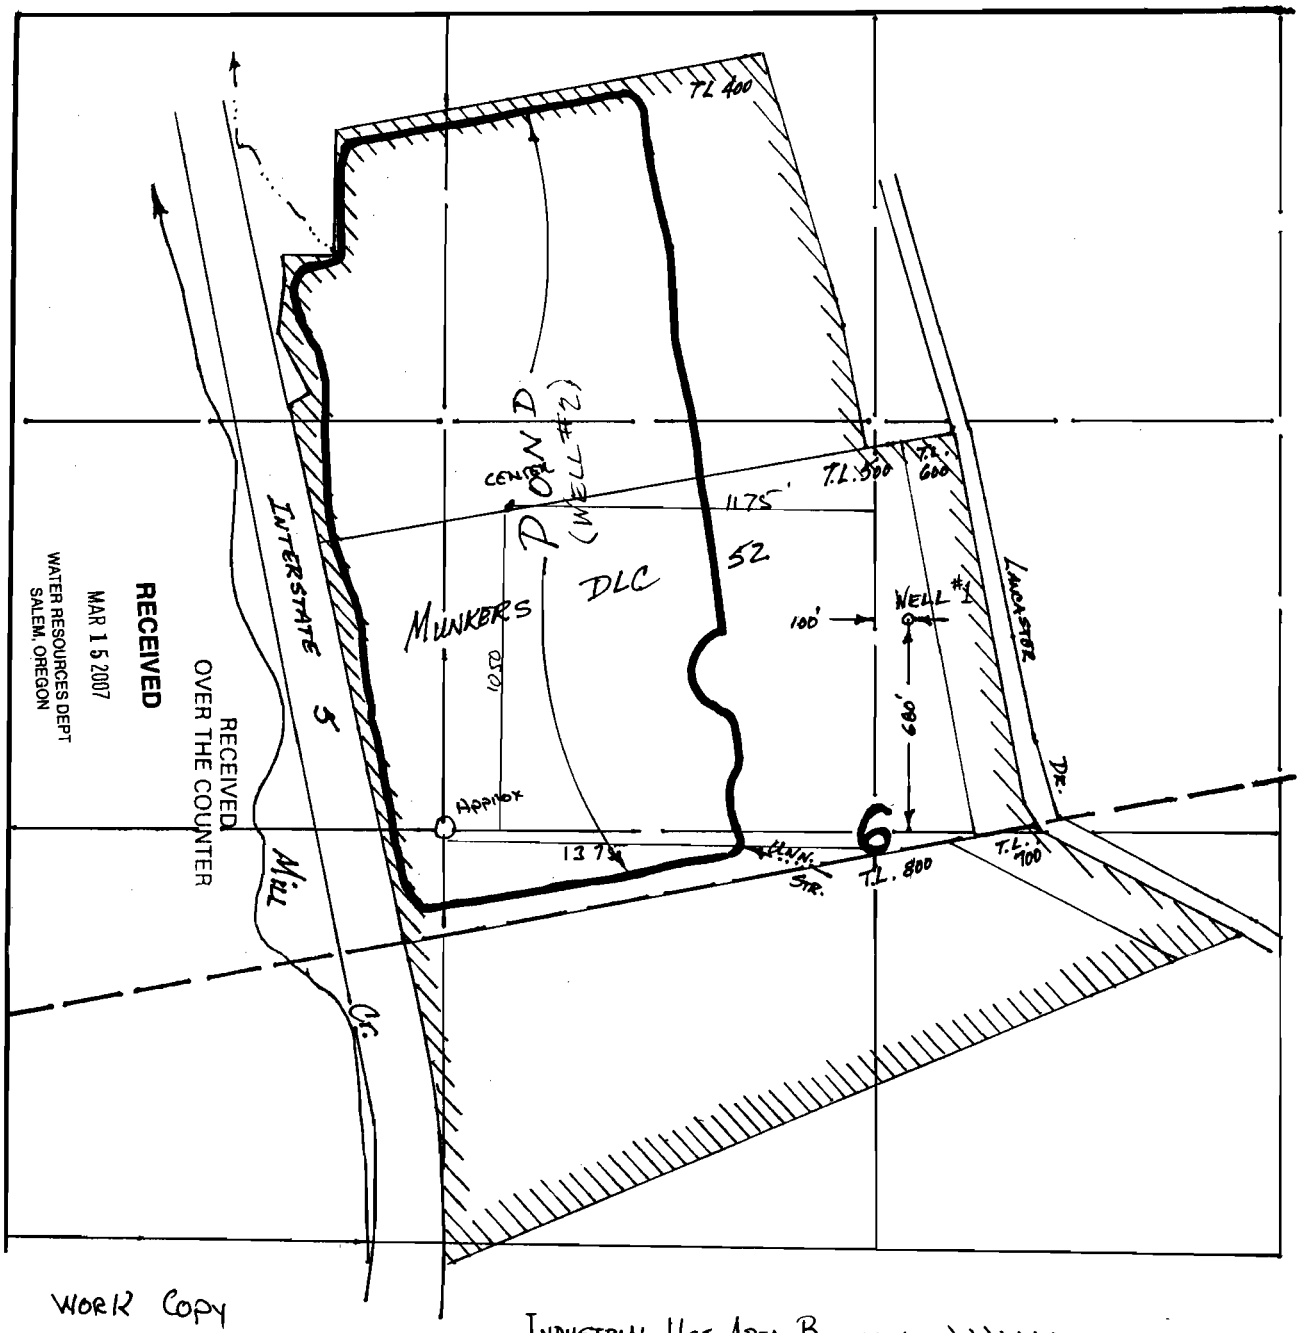

RECEIVED
MAR 15 2007
WATER RESOURCES DEPT
SALEM, OREGON

RECEIVED
OVER THE COUNTER

WORK COPY

INDUSTRIAL USE AREA BOUNDARY

Application Map for Walling Properties, LLC

N

FROM INFO PROVIDED BY STEVE APPLEGATE 3-21-2007

SCALE 1" = 400'

01/07