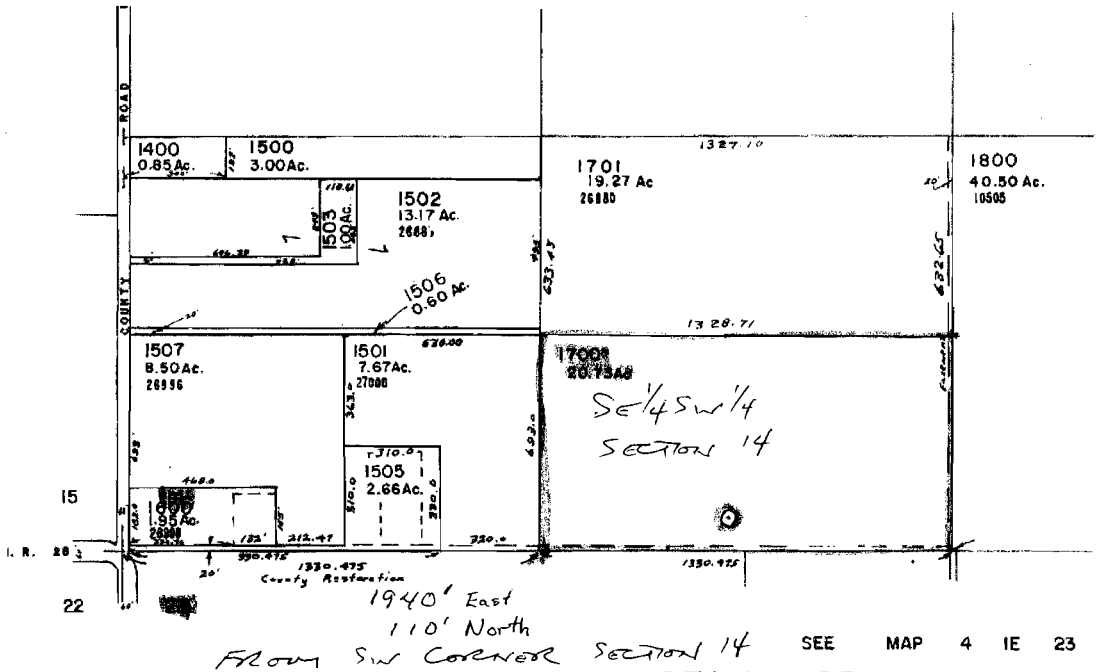



$$I'' = 400'$$


**This map was prepared for
assessment purpose only.**

CLACKAMAS COUNTY

$$l'' = 400'$$

RECEIVED

APR 02 2007

WATER RESOURCES DEPT
SALEM, OREGON

SEE MAP 4 IE 14

