


Township Range Section 14 14 Twp 14
14 14 34 0000 00

66 Acre Field for Irrigation

Tax Lot Intersection (34, 35, 3, 2)
POD is 75' North & Then 1,330' West

Scale 1" = 1,038' (8.5" x 11" Print)

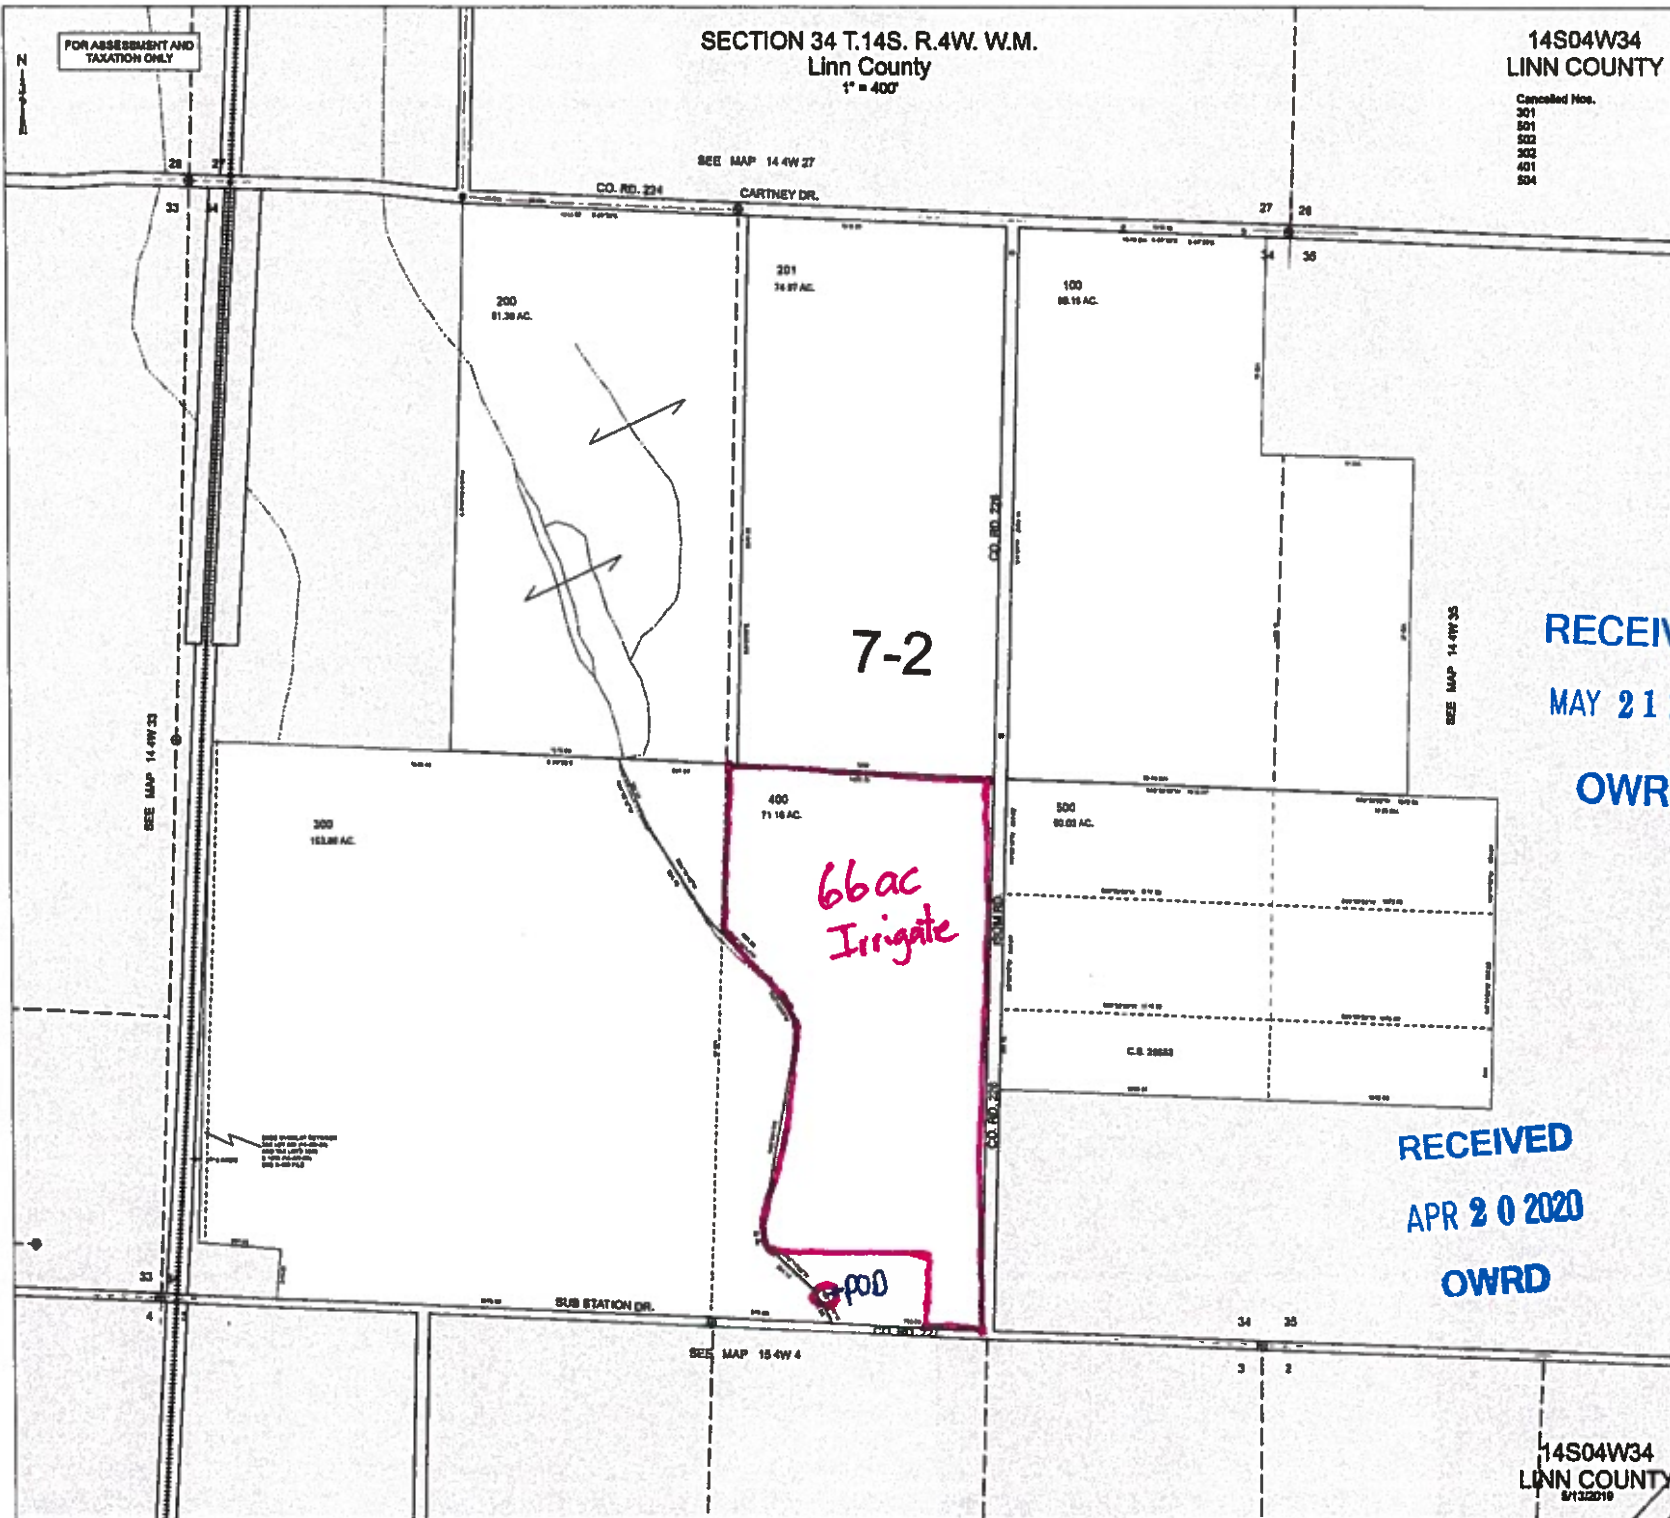

SECTION 34 T.14S. R.4W. W.M.
Linn County
1" = 400'

14S04W34
LINN COUNTY

Cancelled Nos.
301
302
303
401
504

SEE MAP 14-4W 27

CO. RD. 224

CARTNEY DR.

27 28

200
81.38 AC.

201
74.87 AC.

100
88.16 AC.

7-2

SEE MAP 14-4W 35

RECEIVED
MAY 21 2020
OWRD

SEE MAP 14-4W 33

300
153.88 AC.

400
71.16 AC.

500
88.03 AC.

66ac
Irrigate

C.S. 28853

RECEIVED
APR 20 2020
OWRD

SUB STATION DR.

SEE MAP 15-4W 4

34 35

3 2

14S04W34
LINN COUNTY
8/13/2010

FOR ASSESSMENT AND
TAXATION ONLY