


# Fruit Farms

138

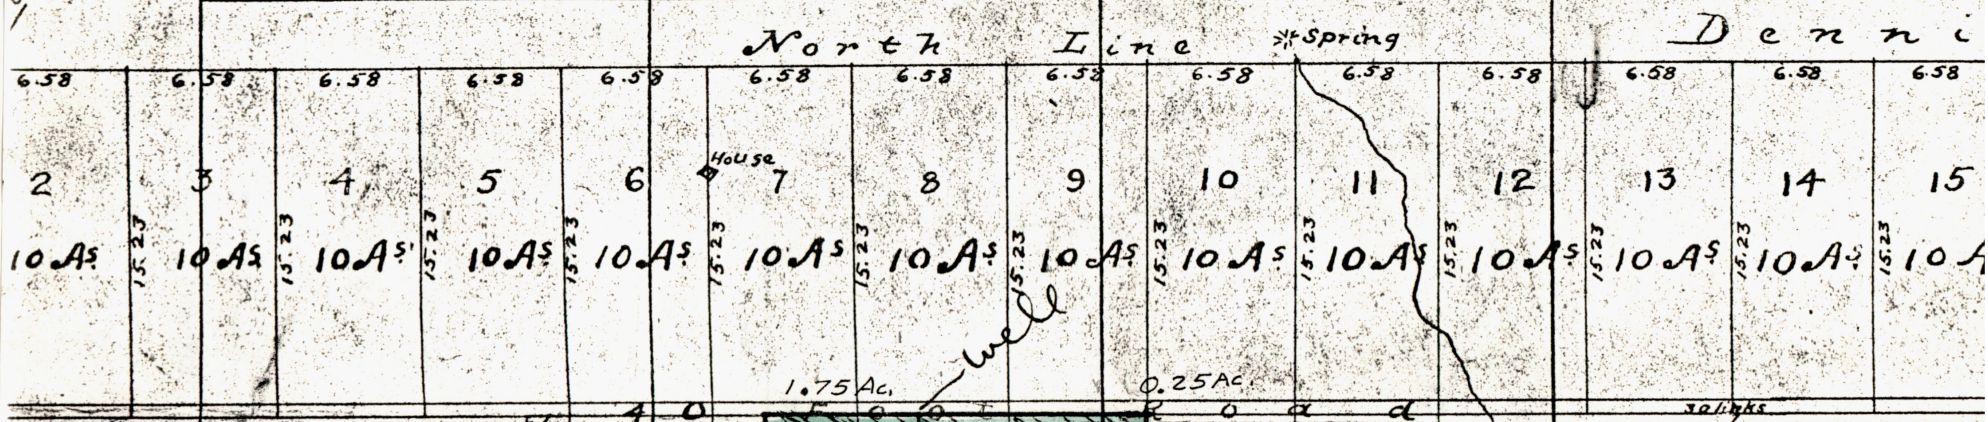


5.8 ac See G-9878

5.8 See G-9880

6.2

14.2

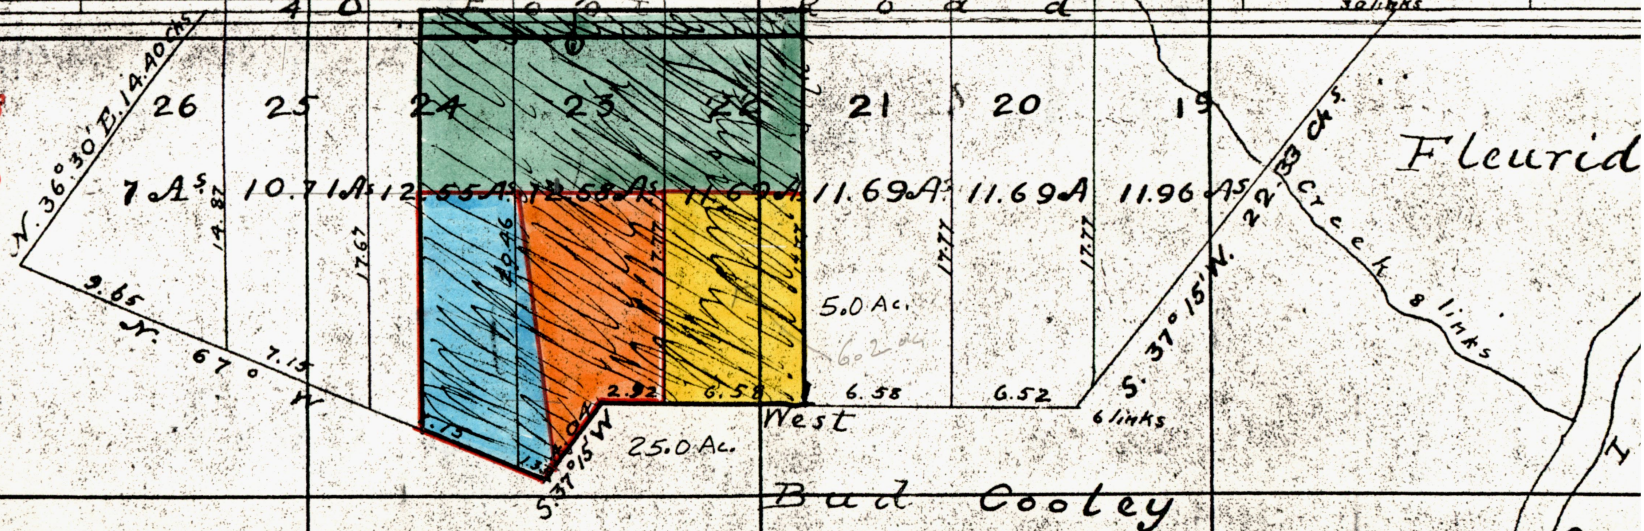

17  
14.2

11.6  
6.2  
17.8  
33  
17.8  
14.2