

RECEIVED

APR 24 2007

WATER RESOURCES DEPT
SALEM, OREGON



T. 4 S. R. 1 W. Section 2 D

Applicant: Brett Kacalek

POA Location:

132 North and 354 East from the South
1/4 Corner T. 4 S., R., 1 W., Section 2


Irrigated/Nursery Acres:

5.5 acres T. 4 S. R. 1 W. Section 2,
SW 1/4 of the SE 1/4


4.0 acres

T. 4 S. R. 1 W. Section 11,
NW 1/4 of the NE 1/4

All within Tax Lot 1400

 

SYMBOL TYPES

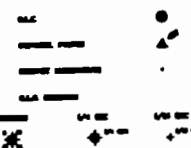

NUMBERS

000 00 00 0




NOTICE: This map was
created for Assessor's
Office use ONLY.



SCALE 1" = 200'
or 1:2000
Plot file created: March 31, 2006
Digitized by: [illegible]

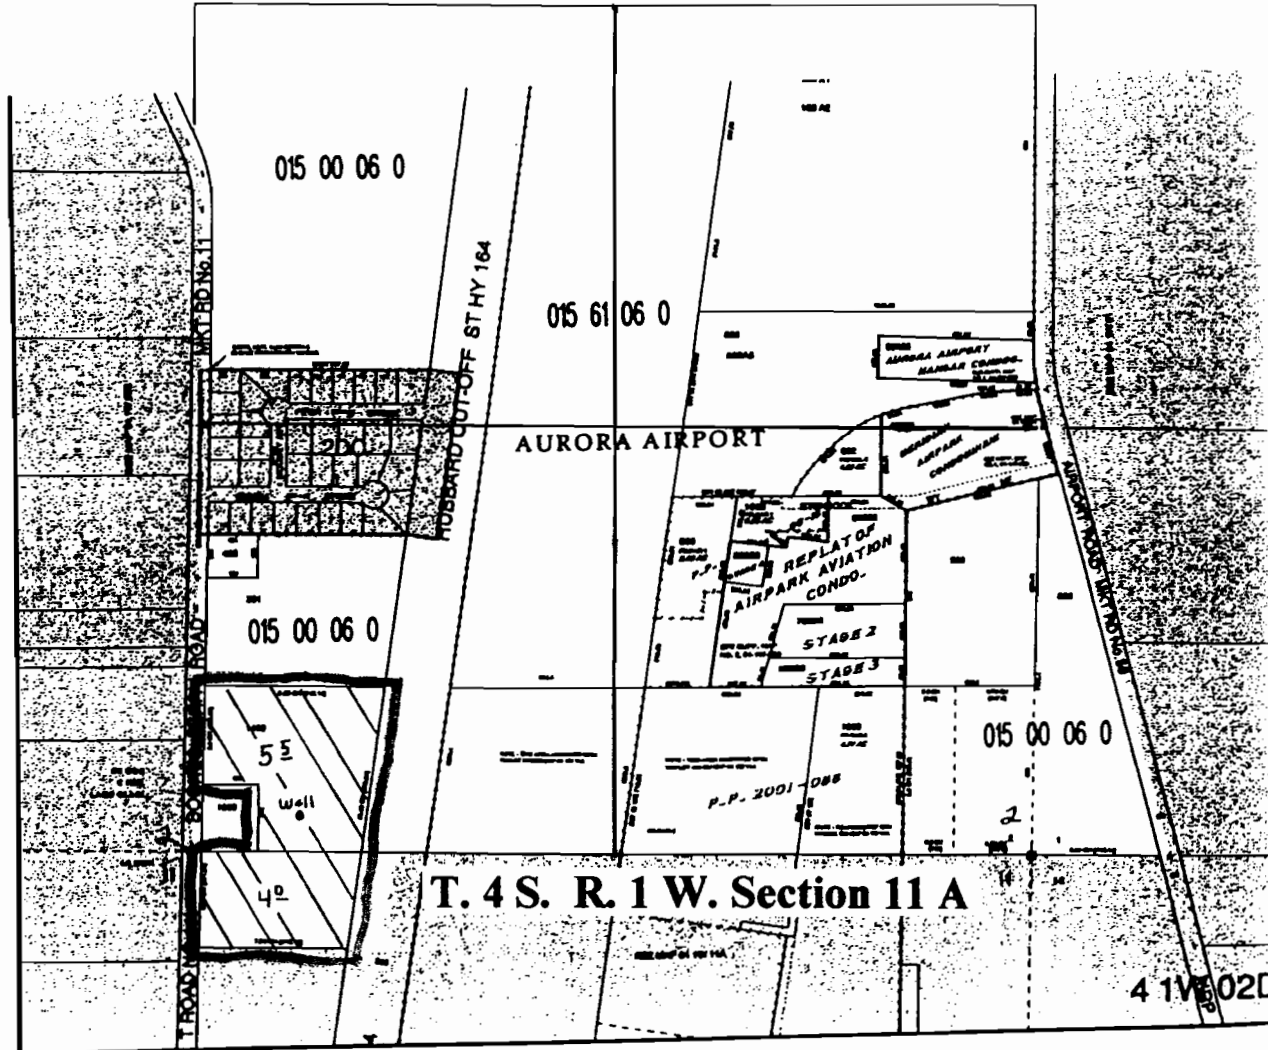

4 1V 02C

Scale: 1" = 600'