November 14, 1994

Oregon

JOYCE J STRINGER

180 SHETLAND DR GRANTS PASS, OR

97526

WATER
RESOURCES
DEPARTMENT

REFERENCE:

File # P-74765;

Notice of Exempt Reservoir (Pond)

Your exempt reservoir notice has been received by the Department and has been assigned the above-referenced file number. We would like to ask you to refer to this number if you should need to contact us about the notice, your pond, or ponds if you have more than one.

To avoid any misunderstanding, we feel it is important to tell you that although we have received and filed your notice, we have not yet determined whether you are exempt from water right requirements. The watermaster responsible for the area in which the pond(s) is (are) located will help us apply the Water Resources Commission's administrative rules to your situation. These rules set the standards that determine which ponds require water rights and which are exempt. We will let you know the results as soon as we are able to complete our review of your pond(s)'s nature.

Since the department must rely initially on the information you submit to us, it is very important that the information be complete and accurate. If inspections show that your pond(s) does (do) not qualify as exempt, you could be asked to drain the pond(s) or submit a water right application or both. If you submit your application after January 1, 1995, it will be processed like any other application, since that is the deadline for filing water rights under the pond amnesty program.

The department will process your information as quickly as possible. However, because water right processing staff members are working hard to reduce a backlog of applications, it may be some weeks before you hear from us.

If you have questions, you may contact your watermaster. The enclosed brochure lists watermaster names, telephone numbers and addresses by county.

Sincerely,

Mr. Cory C. Engel

Water Rights Research Assistant Water Rights/Adjudication Division

Enclosure: New Water Right Law for Pond Owners Brochure



### STATE OF OREGON

WATER RESOURCES DEPARTMENT

RECEIVED

OCT 2 0 1994

### NOTICE OF EXEMPT RESERVOIR

WATER RESOURCES DEMI. SALEM, OREGON

This notice is submitted pursuant to ORS 537.141, which provides that a water right is not needed for certain ponds/reservoirs which were in existence before January 1, 1993, are located off-channel and store less than 9.2 acre-feet of water or have a dam less than 10 feet in height.

Landowner: JOYCE J. STRINGER						
Authorized Agent: (if applicable)						
Address: 180 SHETLAND DR						
GRANTS PASS OREGON 97526 (503) 479-4670  City State Zip Telephone No.						
I/WE SUBMIT NOTICE OF THE FOLLOWING RESERVOIR(S):						
NOTE: Multiple reservoirs may be included in a single notification, provided the reservoirs are within the same ownership, on contiguous property and within the same drainage basin. For items 1-6 below, attach extra sheets for additional reservoir descriptions.						
The reservoir is located in Section 32, Township  36, Range 6, in JOSEPHINE  County. (Enclose a US Geological Survey topographical map or a tax lot map showing the location of the reservoir(s). Copies of portions of the maps are acceptable, provided information on the copy verifies the correct legal description.)						
description.)  Rain, irrigation, under ground seepage,  2. Source of water: and overflow from neighbor's pond  .						
3. Maximum height of the dam: S'						
4. Maximum water depth in the reservoir: 12'						
5. Maximum storage capacity of reservoir: 2,916 Cu. ft.						
6. Size, description and location of any outlet pipe: outlet ditch						
in speated on the yorth side and runs to a duck at the						
Good. Water runs in and out most of the year.						
7. Enclose evidence that the reservoir(s) existed before January 1, 1993, such as one or more of the following:						
7.1 A dated aerial photograph which shows the immediate area above, below and surrounding the reservoir(s);						
7.2 An affidavit signed by the landowner or other knowledgeable person (signature needs to be notarized);						
7.3 A dated map prepared by a local, state or federal agency showing the location of the reservoir; or						
7.4 Construction receipts or other forms of documentation.						

Declaration by Owner/Authorized Agent: Each of the reservoirs described herein was in existence before January 1, 1993, is located off-channel and stores less than 9.2 acre-feet of water or has a dam less than 10 feet in height.

I/We believe the reservoir(s) qualifies under ORS 537.141 and OAR 690-11-041 for exemption from Oregon's water right filing requirements.

Reservoirs that qualify for exemption under ORS 537.141 and OAR 690-11-041 shall be subject to the following conditions:

- The right to store or use water in the reservoir shall not have priority over any water right; and 1.
- The right to store and use water in the reservoir(s) shall be subordinate to all future permitted or certificated water 2. rights.

THE UNDERSIGNED VERIFIES THAT TO THE BEST OF HIS/HER KNOWLEDGE AND BELIEF THE INFORMATION CONTAINED IN THIS NOTICE IS TRUE, CORRECT AND COMPLETE.

Landowner/agent signature: \_\_\_\_\_

(Print Name and Title)	
Date:	
FOR WATER RESOURCES I	DEPARTMENT USE ONLY
The foregoing Notice and accompan	ying data have been examined by
authorized staff of the Water R	esources Department. Based on
is of the information submit	ted, this Notice is accepted
, 1994 and assi	gned FILE NUMBER
cc: Watermaster District # To Data Center (date)	

OCT 2 0 1994

P74765

EPT. Sept. 29, 1994

State of Oregon Water Resources Dept.

Dear Sirs,

The spond located at 3009 Helms Led, Grants Pass, Oregon, tax lat 2801, was constructed in the Spring of 1985. I have owned this property since 1960.


Jayer J. Stringer

P74765

## RECEIVED

OCT 2 0 1994

NATER RESOURCES DEPT.
SALEM, OREGON

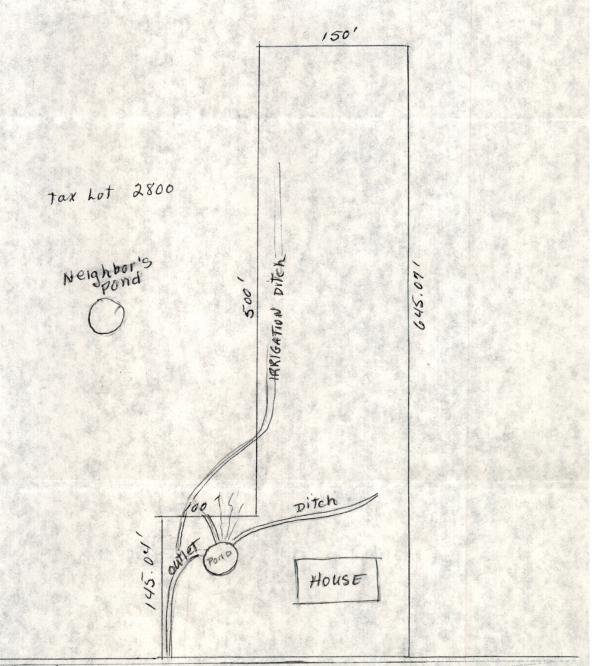

2501

DITCH


3009 HELMS RD

Tax Lot 2801

### BOOK 12

# SECTION 32 T36S R6W W.M.

1"=400'

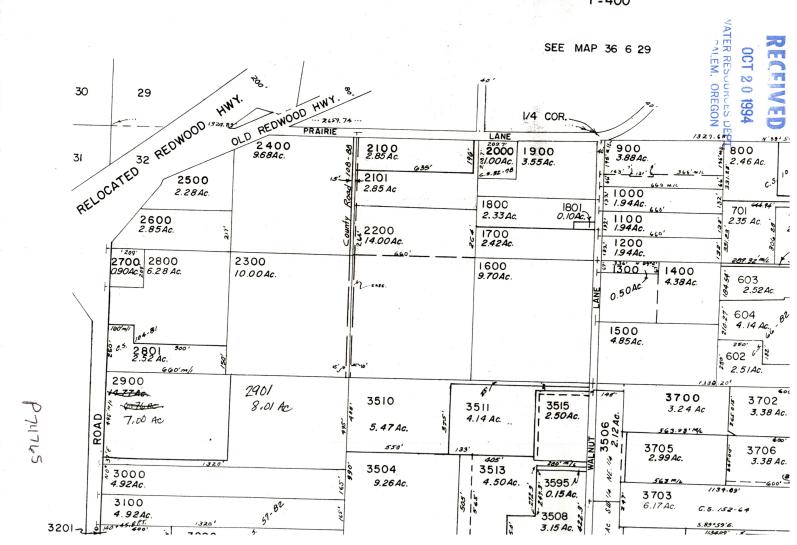

# PRE-TR APPLICATION PROCESSING OUTLINE Application File # 74765

	MINI	MUM REQUIREMENTS TO FILE		
<u>DATE</u>	INITIAL	Name and mailing address of applications of water	ant	
		Quantity of water		
		Map showing location of POD & POU		
		Use of water	_	
		Names and addresses of legal owners Signature of applicant Oath	5	
		Application date stamped per money r Land use approved pending	eceip	t date
		If reservoir < 5 AF \$, if > 5	AF \$	
		HB 2153/HB 2107 APPLICATION SEE	REVE	RSE
	-	Route to Data Center (Unless 2153/	2107)	
	DATA	CENTER		
		Stream Code Entered into WRIS		-   "
	SUPE	PORT SERVICES		
11/23/94 11/23/94	1 2 h	Stamp contents with application number Mail ack letter (provided by Data Contraction receipt to applicant, cc to CWRE at Place label on file and calender contractions.	enter nd fi	) with le
	APPI	LICATION SECTION		
	•	Stream Indexed Basin # Plat Carded and copy made If dam is over 10 feet or storage AC-FT, route file to Dam Safety Se		ds 9.2
	TR C	CASEWORKER		
		TR Checklist complete Within Irrigation District		NO_
		District Notified District excerpt received		
		TR Mailed DATE		
		Public Interest Checklist complete		
		Management Codes		_
REMARKS:				

### MINIMUM APPLICATION REQUIREMENTS TO FILE:

HB 2153 - exis	ting, sr	mall,	EXEM	PT po	nds
18/29/99 CB (date & initials)	NOTICE OF E	XEMPT B April 8	RESERVOIR 3, 1994).	form (	or letter
	Appropriate	map (s	see item :	1 on fo	rm).
January 1, 1993 (one photo, NOTARIZED affi receipts or other doc	davit, date	the fold	llowing:	dated a	aerial
	tems 2, 3,	4, 5,	and 6 are	comple	ted.
s	ignature (a	nd tit	le, if ap	plicabl	e)
HB 2153 - non-exer	npt existing	g ponds	(large,	on-char	nel)
Complete Minimum Requesting to Data Center confirm the following	r, change p	File oriorit	on revers y date to	e, exce 1/1/19	pt <u>before</u> 93. Also
before January 1, 199 aerial photo, NOTARIZ construction receipts	ED affidavi	ore of .t, dat	the foll ed map fr	owing:	dated
HB 2107 - wetla	and, stream	restor	ation and	storm	water
Complete Minimum Requestrate TO DATA CENTER, following:					
	Name/addres	ss of a	djacent p	roperty	owner
within 1/4 mile	Map with so CWRE map if Description Condition a Resulting b	f > 10 n of pr address	feet dam oposed us ed	or $> 9$ .	
	Public noti	ices (c	eircle)	#1	#2