

122°42.000' W

122°41.000' W


122°40.000' W

WGS84 122°39.000' W

RECEIVED

APR 24 2007

WATER RESOURCES DIV
SALEM, OREGON

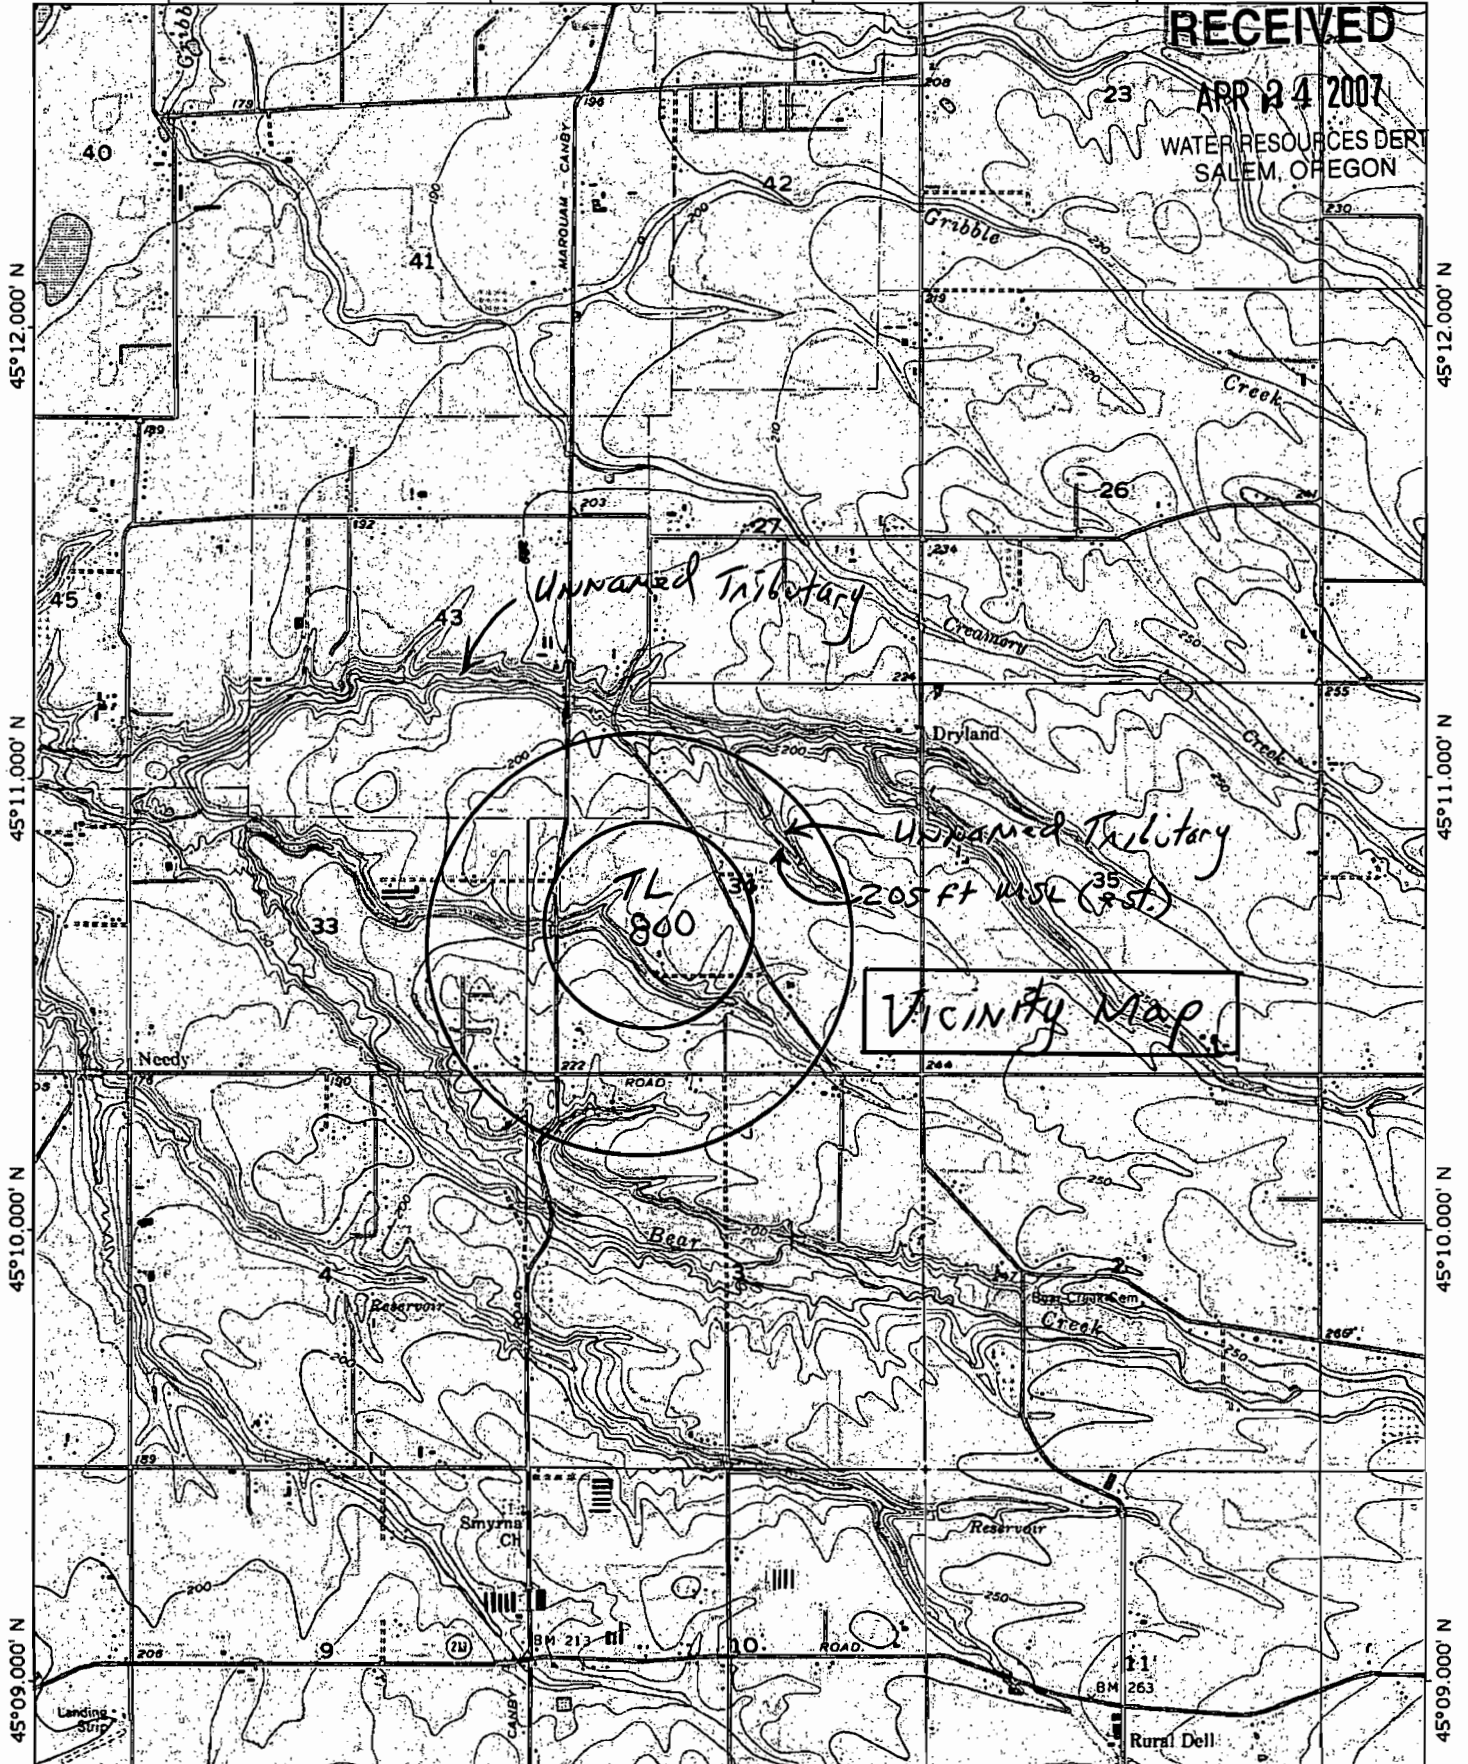

TN 17

122°41.000' W


122°40.000' W

WGS84 122°39.000' W

0 1000 FEET 0 500 1000 METERS

Map created with TOPOI © 2002 National Geographic (www.nationalgeographic.com/topo)


map printed on 04/24/07 from "OREGON.TPO" and "Untitled
122°41.000' W WGS84 122°40.000' W

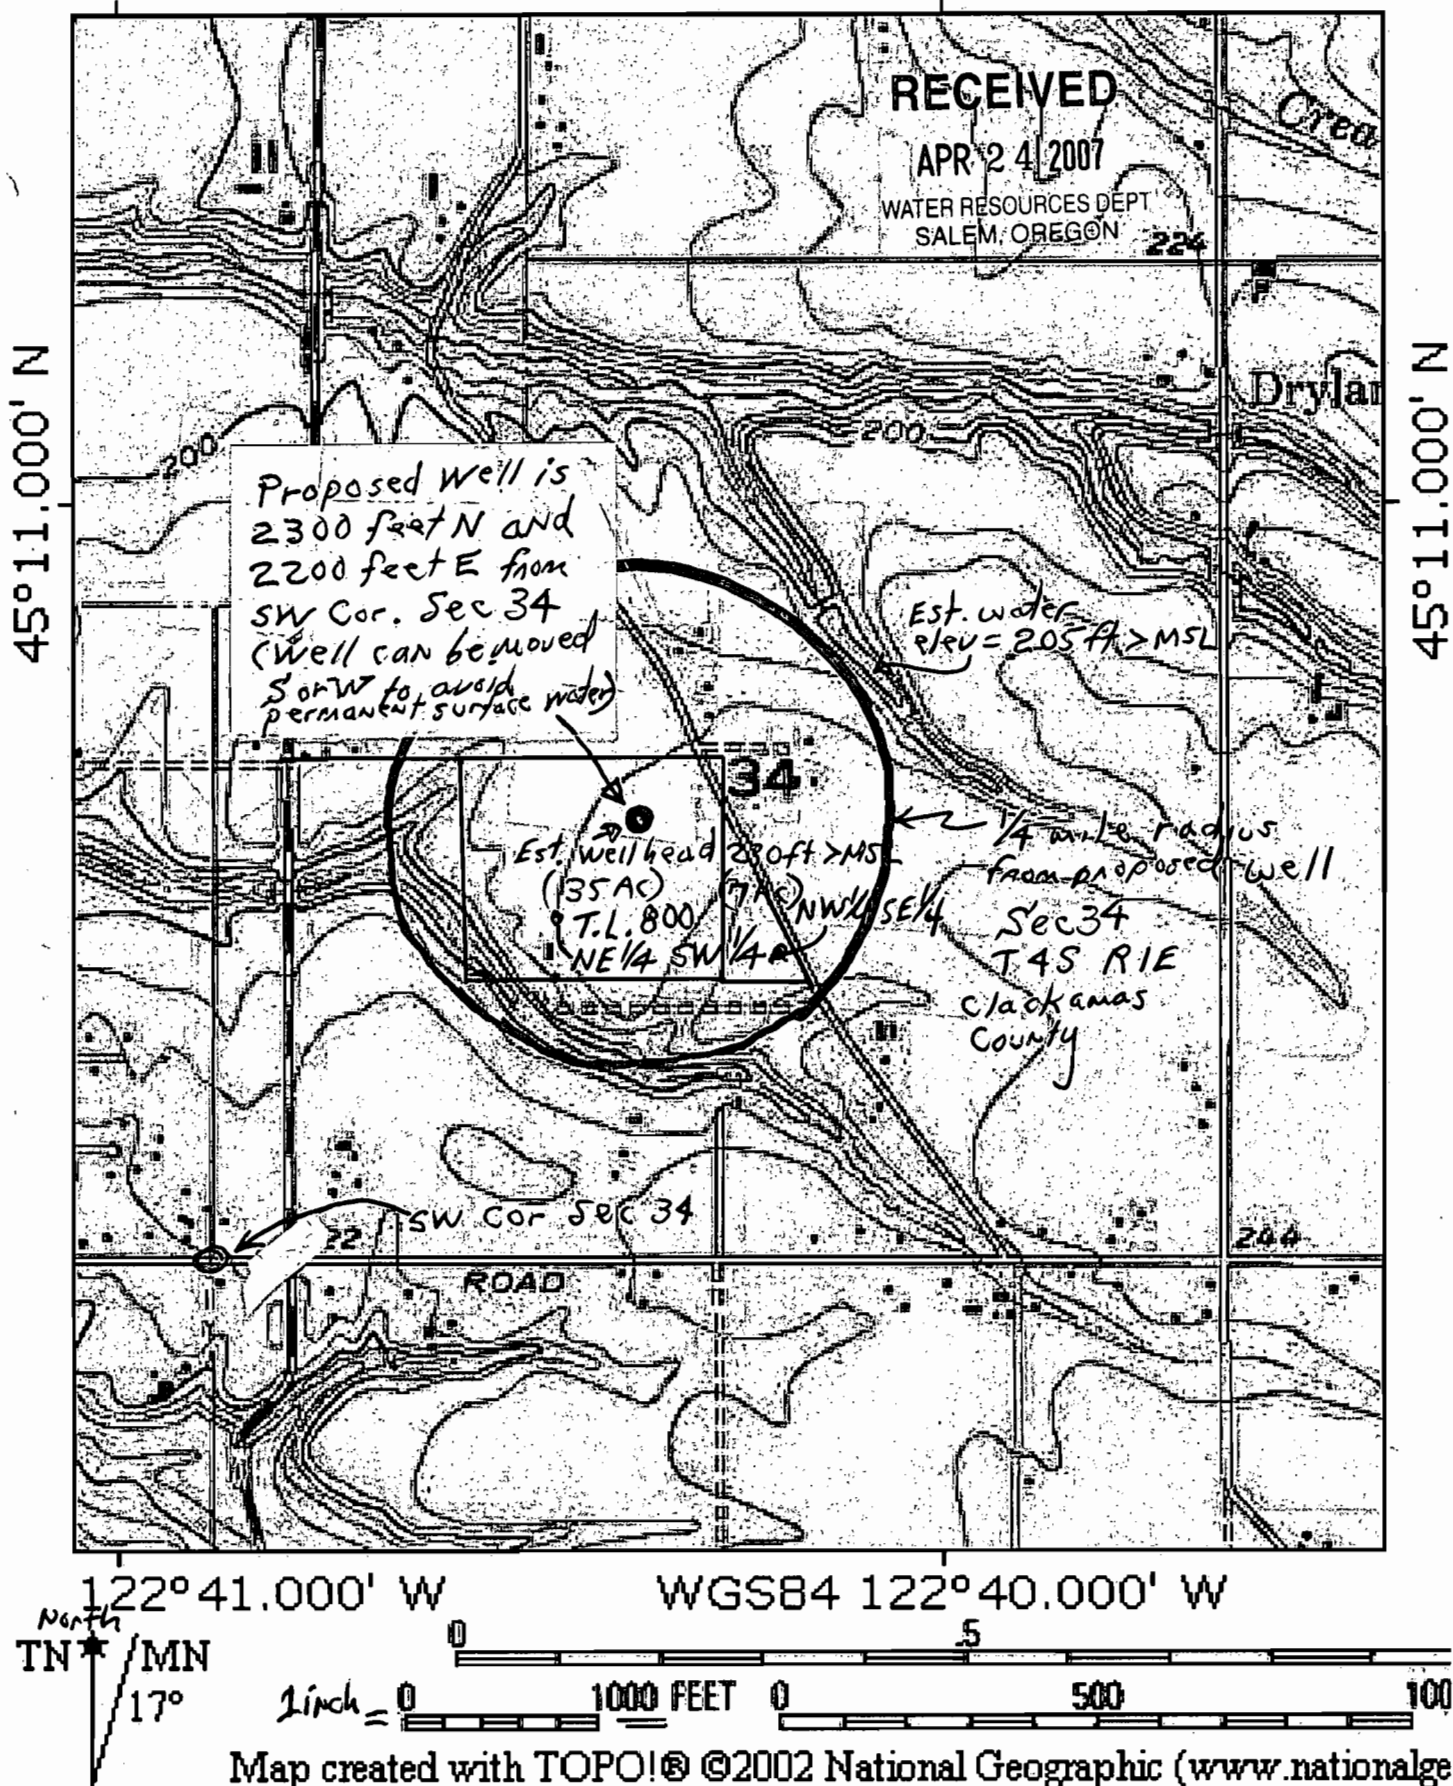

RECEIVED

APR 24 2007

WATER RESOURCES DEPT
SALEM, OREGON

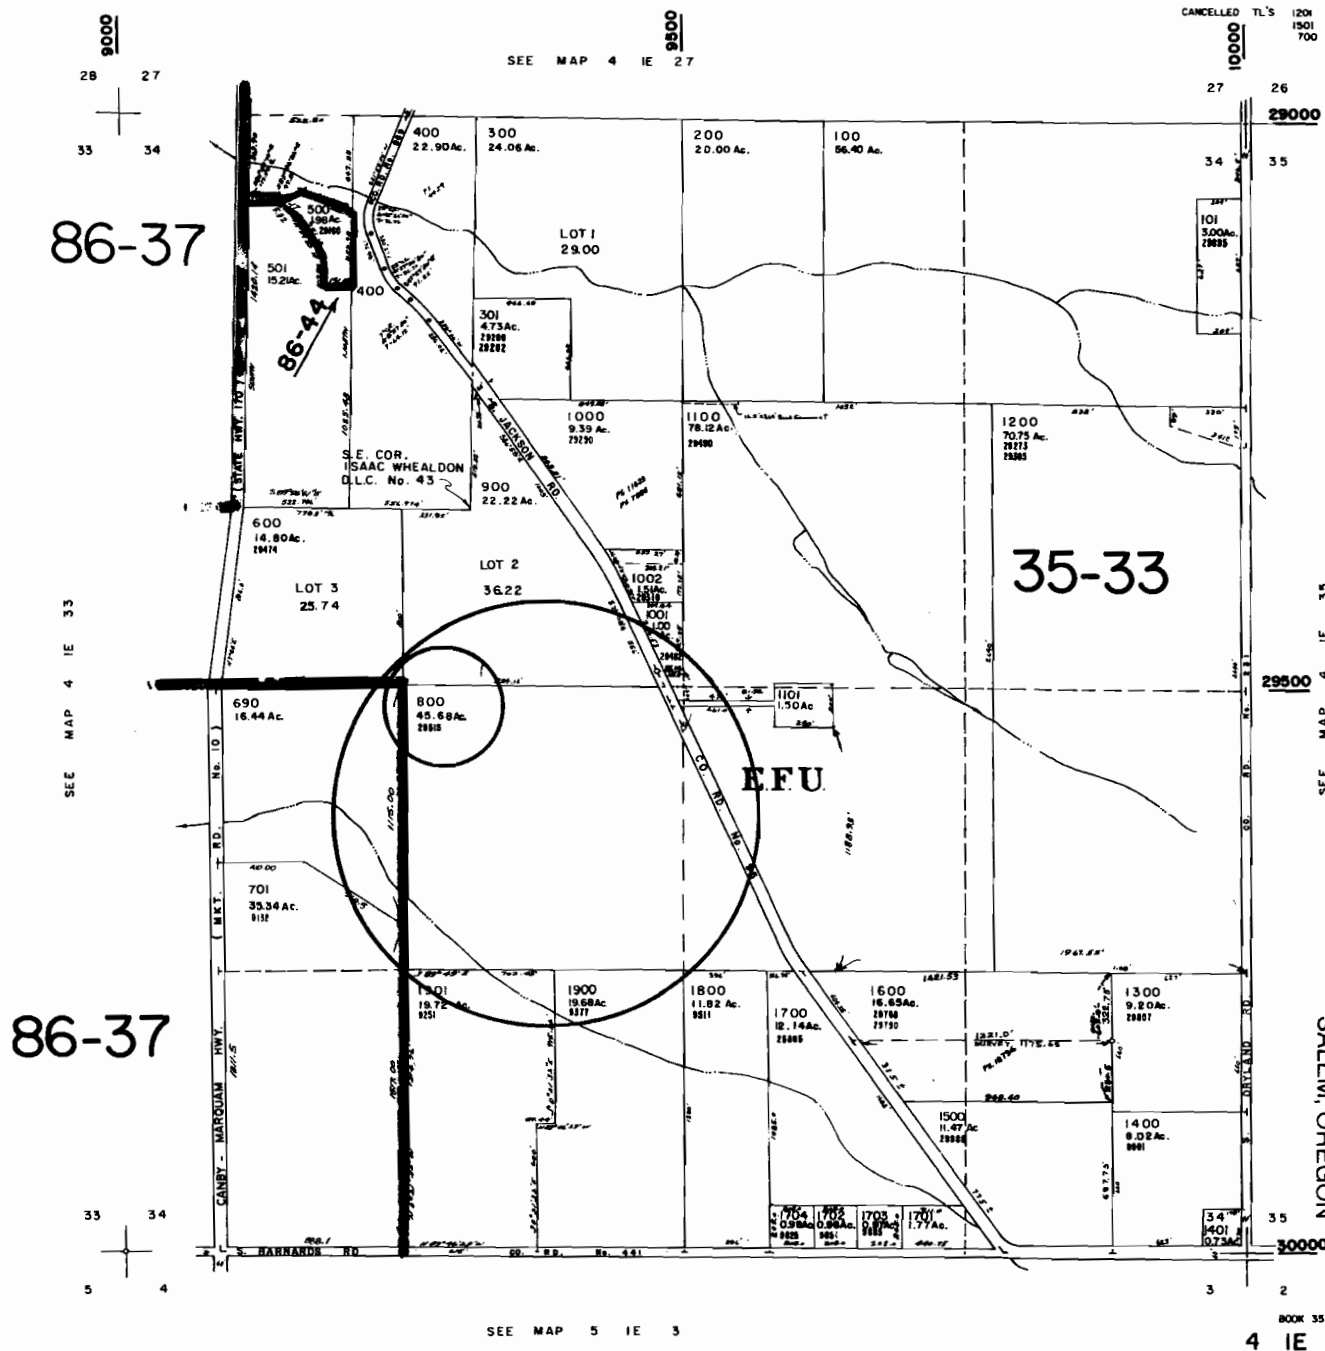

APR 24 2007

WATER RESOURCES DEPT
SALEM, OREGON

SEE MAP 4 IE 33

LOT 3
25.74

3622

690
16.44 Ac.

800
45.68Ac.
29615

1101
1.50Ac

E.F.U

Tax Lot
800

NE $\frac{1}{4}$ SW $\frac{1}{4}$

NW 1/4
SE 1/4

701
35.34 Ac.
9/32

1901
19.72 Ac.
9251

1900
19.68Ac.
9377

1800
11.82 Ac.
9511

1600
16.65Ac.
29788
29790

1700
12.14Ac.

21.53

1221.0'
SURVEY, 1175.65

968.40

1500
11.47 Ac
29988

1704
0.98
9625

1702
0.98A
965i

c.	1703 0.97 9683
----	----------------------

1701
1.77A

33 34

5 4

CANBY - MARQUAM HWY.

S. BARNARDS RD

CO + R.D. No. 441

86-37