


REVISED 1-11-11
THIS MAP WAS PREPARED FOR ASSESSMENT PURPOSE ONLY

SECTION 04 T.40S. R.09E. W.M.
KLAMATH COUNTY

1"=400'

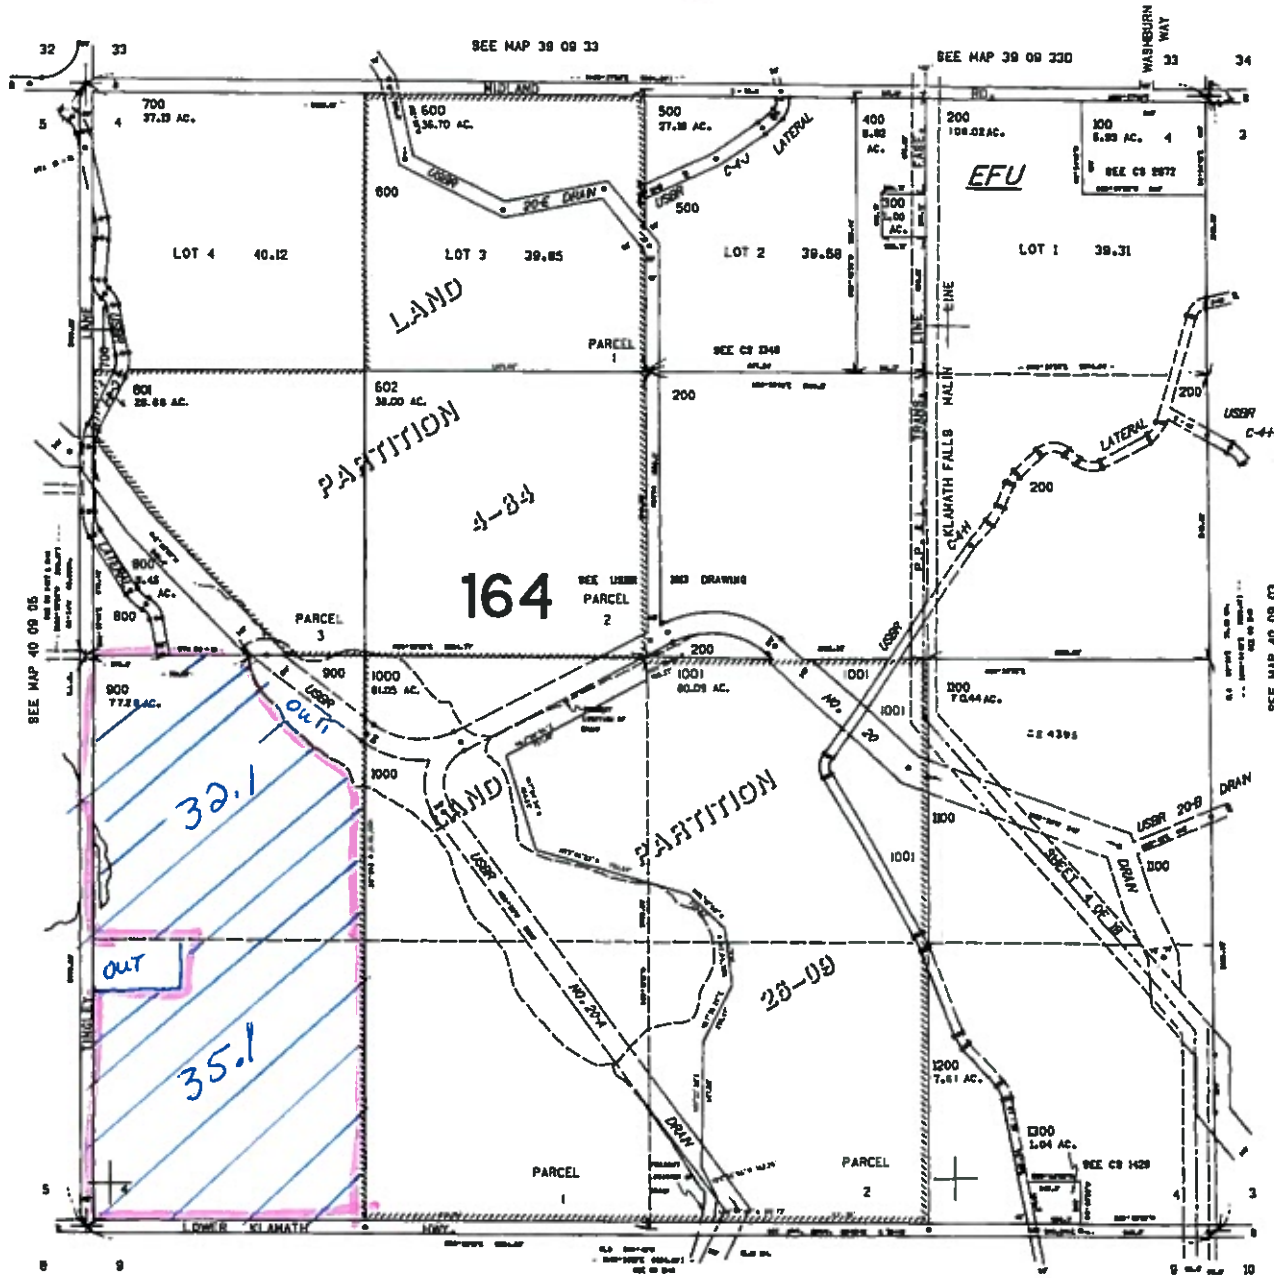

↑
NORTH
T40S R9E
Sec 4
Tax lot
900

Scale
1" = 400'

RECEIVED
JUL 06 2020
OWRD

1854,000

SEE MAP 40 08 09

Map 1 of 2

REVISED 09-26-14


THIS MAP WAS PREPARED FOR
ASSESSMENT PURPOSE ONLY

SECTION 28 T.39S. R.09E. W.M.
KLAMATH COUNTY

39 09 28

1"=400'

SEE MAP 39 09 21

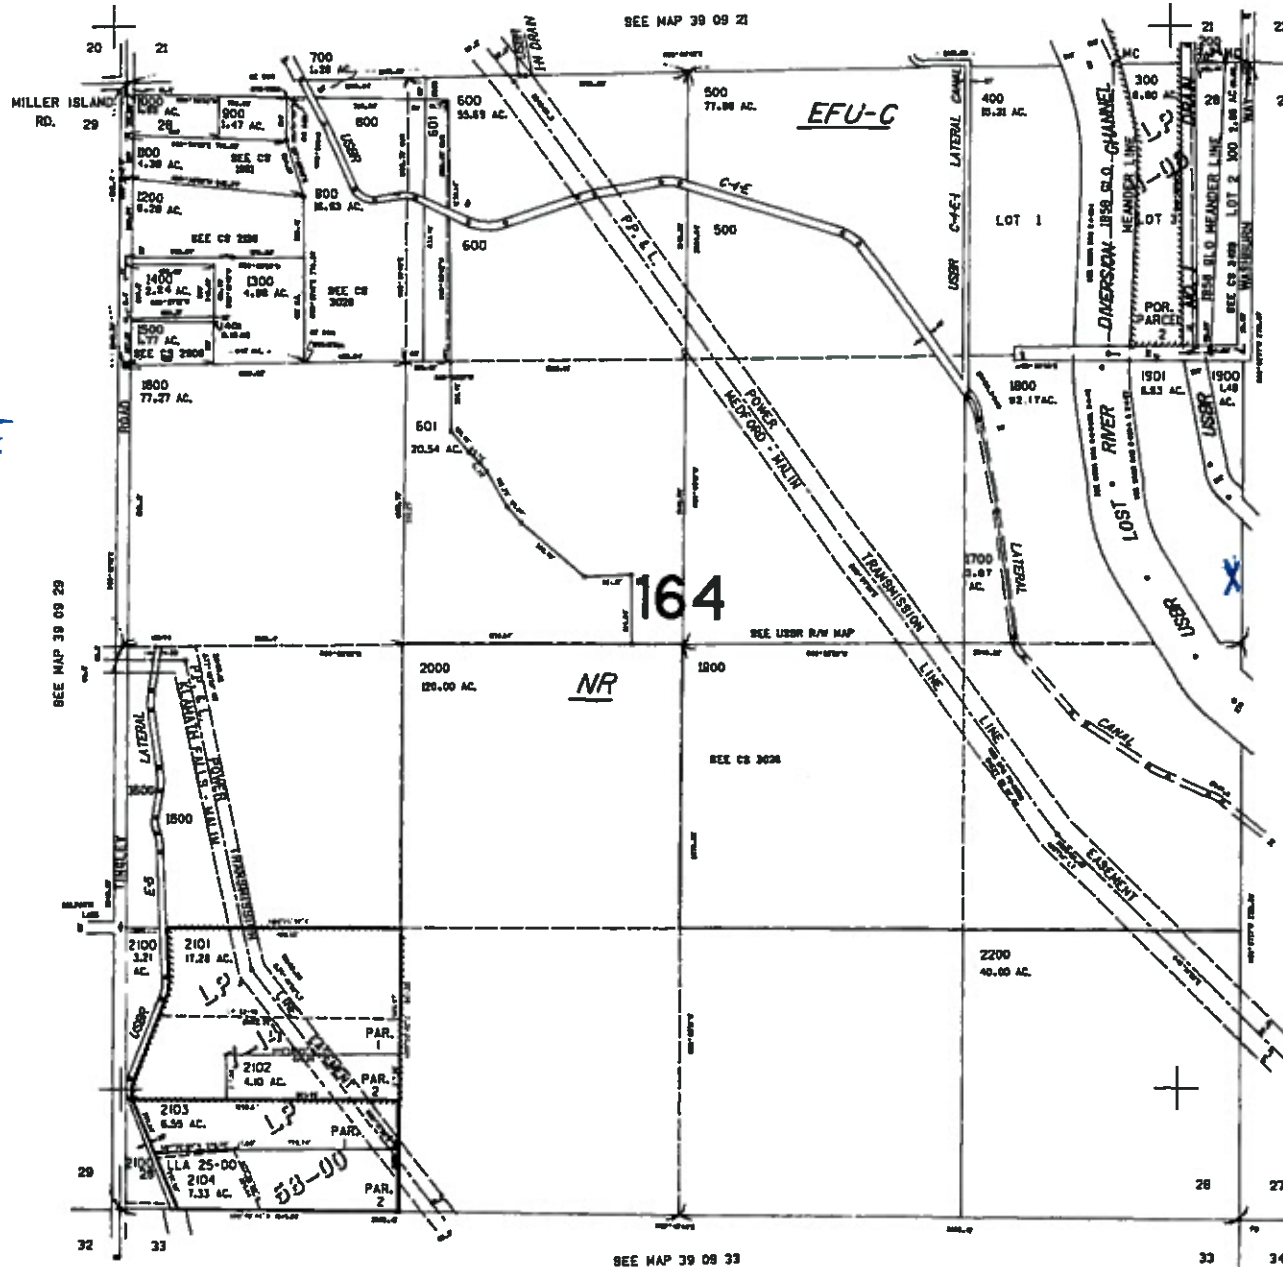

↑
NORTH

T39S R9E
Sec 28

KLAM 53 732
Well Location

52.4' West
202.9' NORTH
of 1/4 corner
of sec. 27 + 28

Scale
1" = 400'

RECEIVED
JUL 06 2020
OWRD

39 09 28