

Graff Property - 13610 NW Skyline Blvd Portland 97231

RECEIVED
AUG 10 2020
OWRD

↑
N

tax lot 3500
township 2 N
range 2 W

woodland pond approx 3/4 acre

25

30

975' W of SE corner
900' N of SE corner

SE/SE of section 25

reference corner

PLC-1107

PLC-1108

36

31

Legend

- Public Land Corner (BT)
- ☑ HB3067
- ☐ Section
- ☐ Taxlots

Notes

1" = 400'



This map is provided for informational purposes only. Information used to develop this map has been obtained from many sources, and is not guaranteed to be accurate. Multnomah County assumes no responsibility for the accuracy of information appearing on this map.

Scale: 1:4,800
Printed: 7/9/2020

Graff Property - 13610 NW Skyline Blvd Portland 97231

RECEIVED

AUG 10 2020

OWRD



tax lot 3500
township 2 N
range 2 W

woodland pond approx 3/4 acre



975' W of SE corner
900' N of SE corner

PLC-1107

PLC-1108

Legend

- Public Land Corner (BT)
- ☑ HB3067
- Section
- Taxlots

SE / SE of section 25

reference corner

Notes
1" = 400'




This map is provided for informational purposes only. Information used to develop this map has been obtained from many sources, and is not guaranteed to be accurate. Multnomah County assumes no responsibility for the accuracy of information appearing on this map.

Scale: 1:4,800
Printed: 7/9/2020

Graff Property - 13610 NW Skyline Blvd Portland 97231

Legend

- Public Land Corner (BT)
- ☑ HB3067
- ☐ Section
- Taxlots

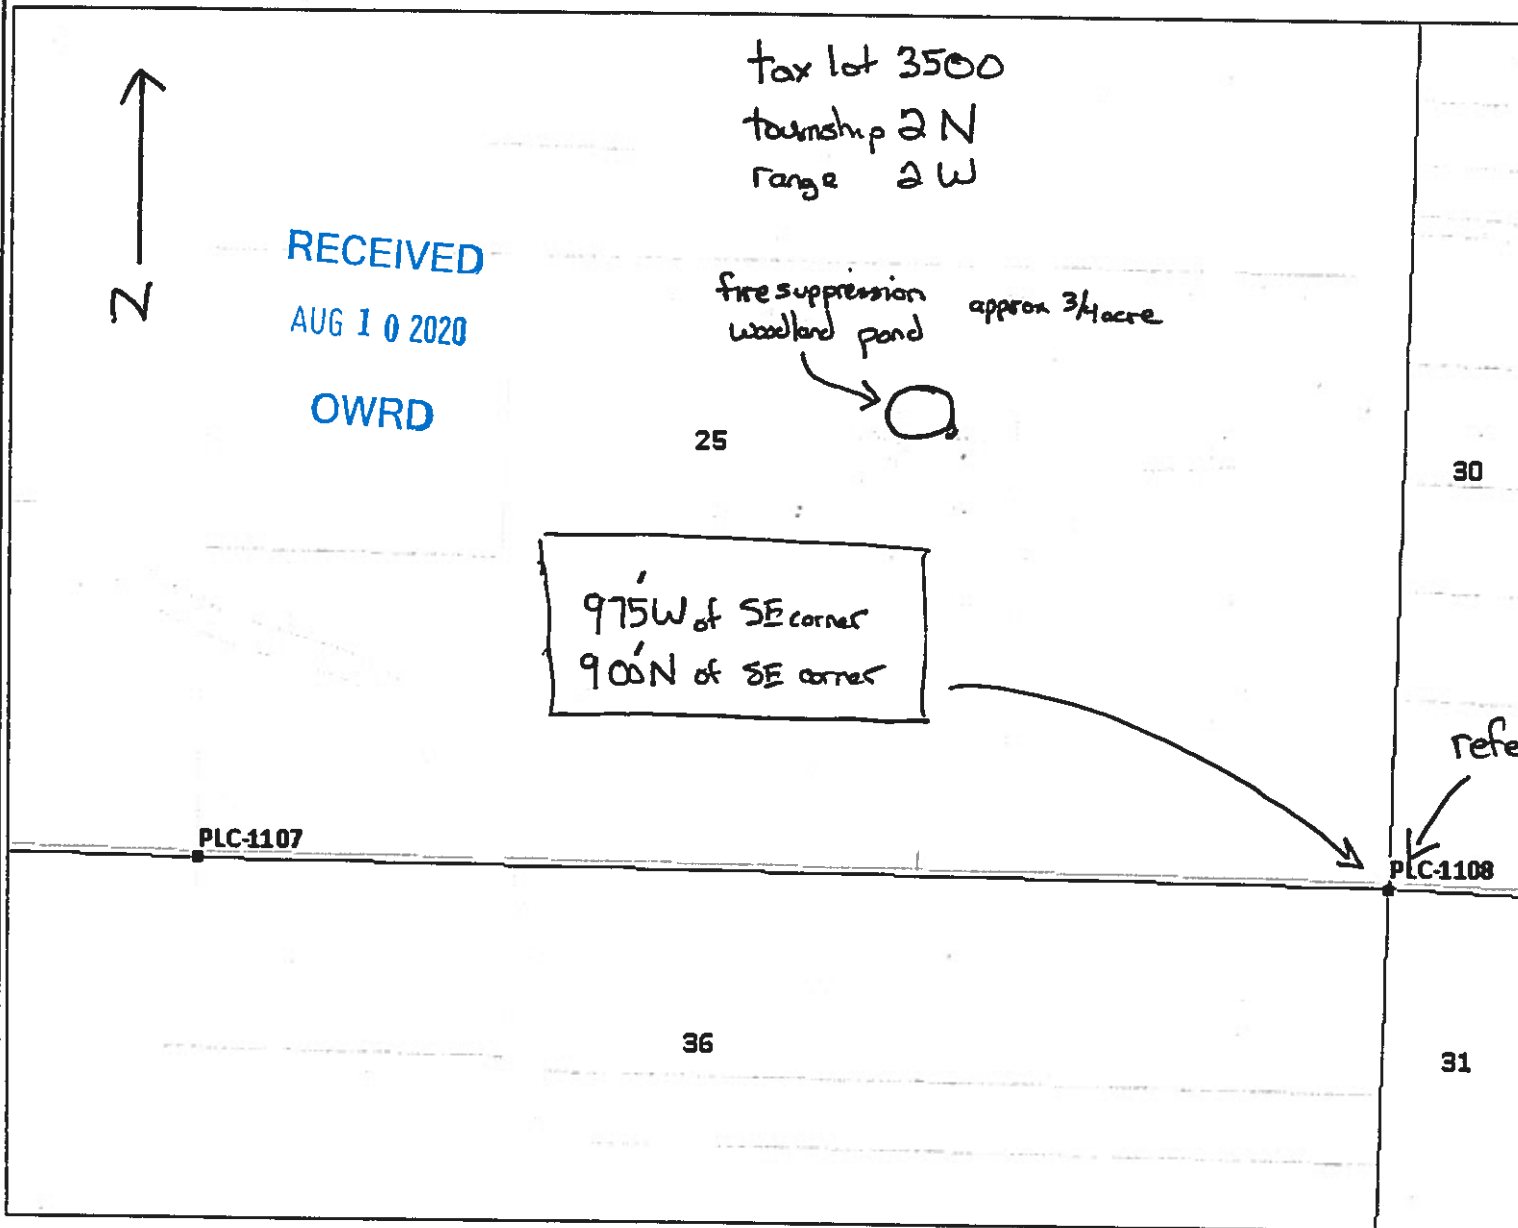

Notes

1" = 400'



This map is provided for informational purposes only. Information used to develop this map has been obtained from many sources, and is not guaranteed to be accurate. Multnomah County assumes no responsibility for the accuracy of information appearing on this map.

Scale: 1: 4,800

Printed: 7/9/2020