

RECEIVED 12/23/20

430 ft south
843 ft west



Township 17 South
Range 2 West
Section 8

R-88864
Bamford, Toni



Property Line

Proposed Pond

17-02-08-00-00600-000

17-02-08-00-00900-000

Property Line

RECEIVED

AUG 31 2020

OWRD

Proposed Shop

Barn

Garage

House

Septic

Driveway

Creek

Creek

Property Line


Apron/Access

Power Pole

0.01

89749 Hill Rd
Springfield, OR 97478
Scale: 1"=60'

MySitePlan

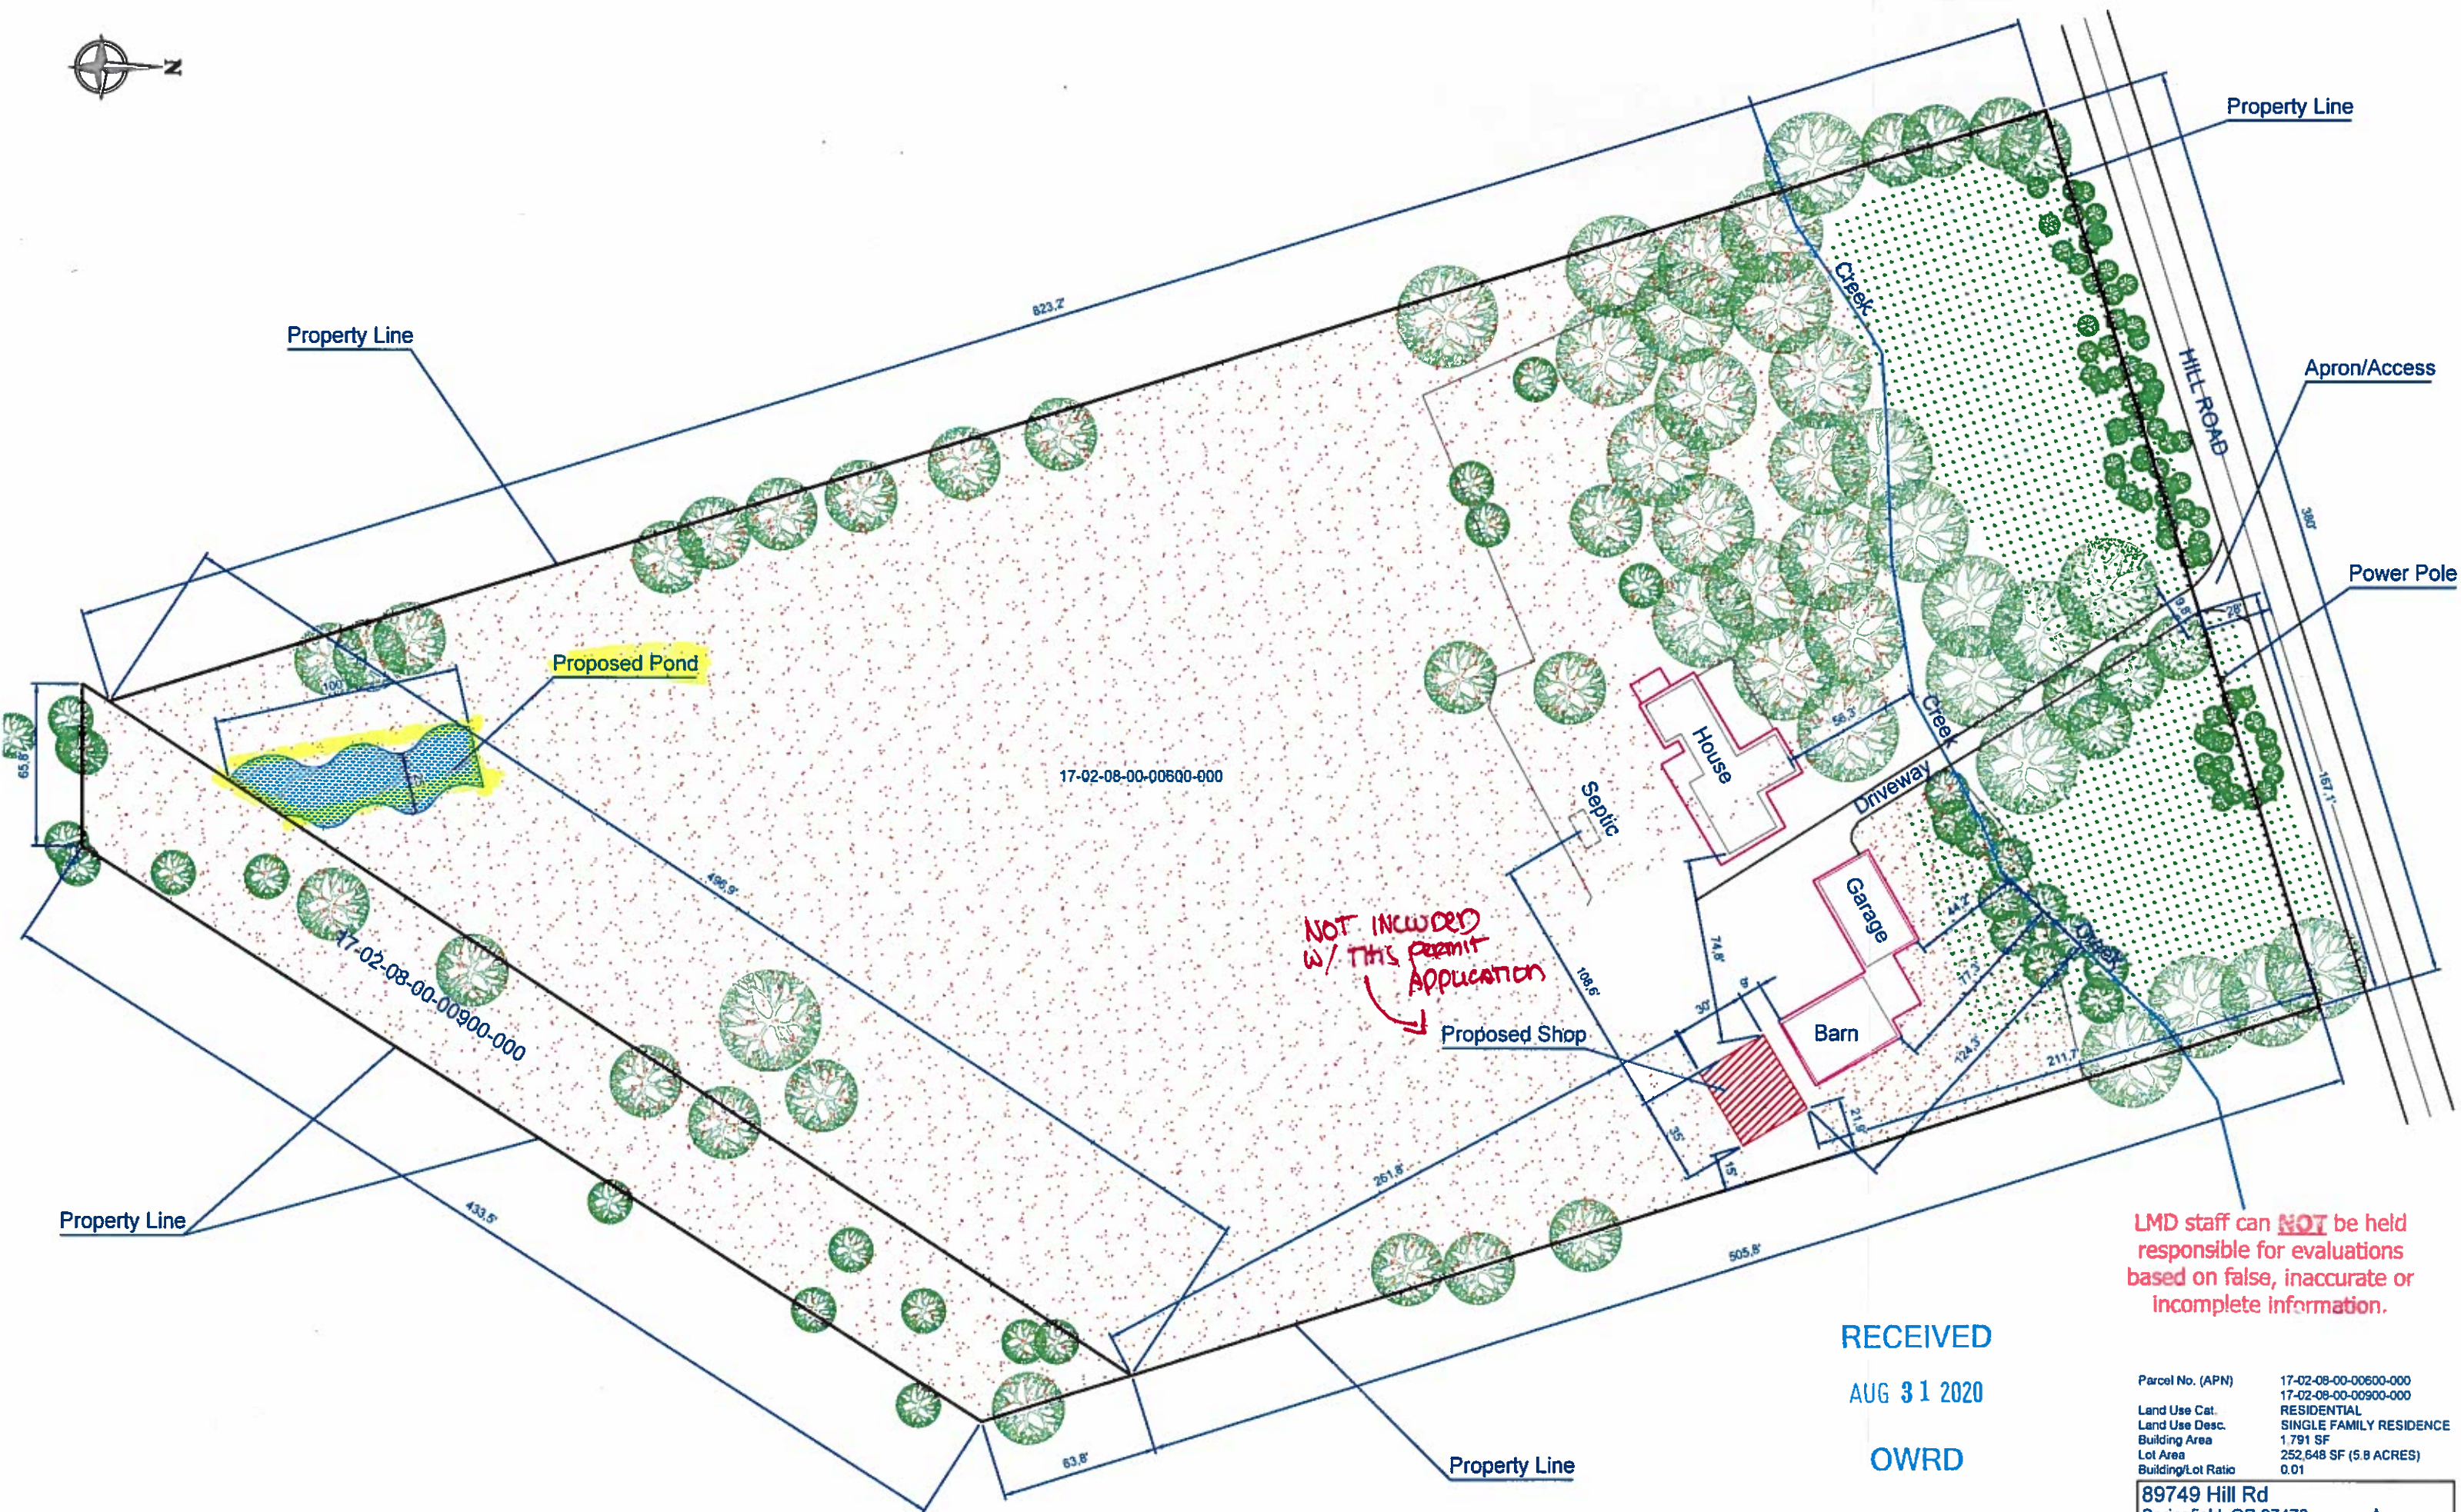

LMD staff can **NOT** be held responsible for evaluations based on false, inaccurate or incomplete information.

RECEIVED
AUG 31 2020
OWRD

Parcel No. (APN)	17-02-08-00-00600-000
Land Use Cat.	17-02-08-00-00900-000
Land Use Desc.	RESIDENTIAL
Building Area	SINGLE FAMILY RESIDENCE
Lot Area	1.791 SF
Building/Lot Ratio	252,648 SF (5.8 ACRES)
	0.01

89749 Hill Rd
Springfield, OR 97478
Scale: 1"=60'

