


Graff Property - 13610 NW Skyline Blvd Portland 97231

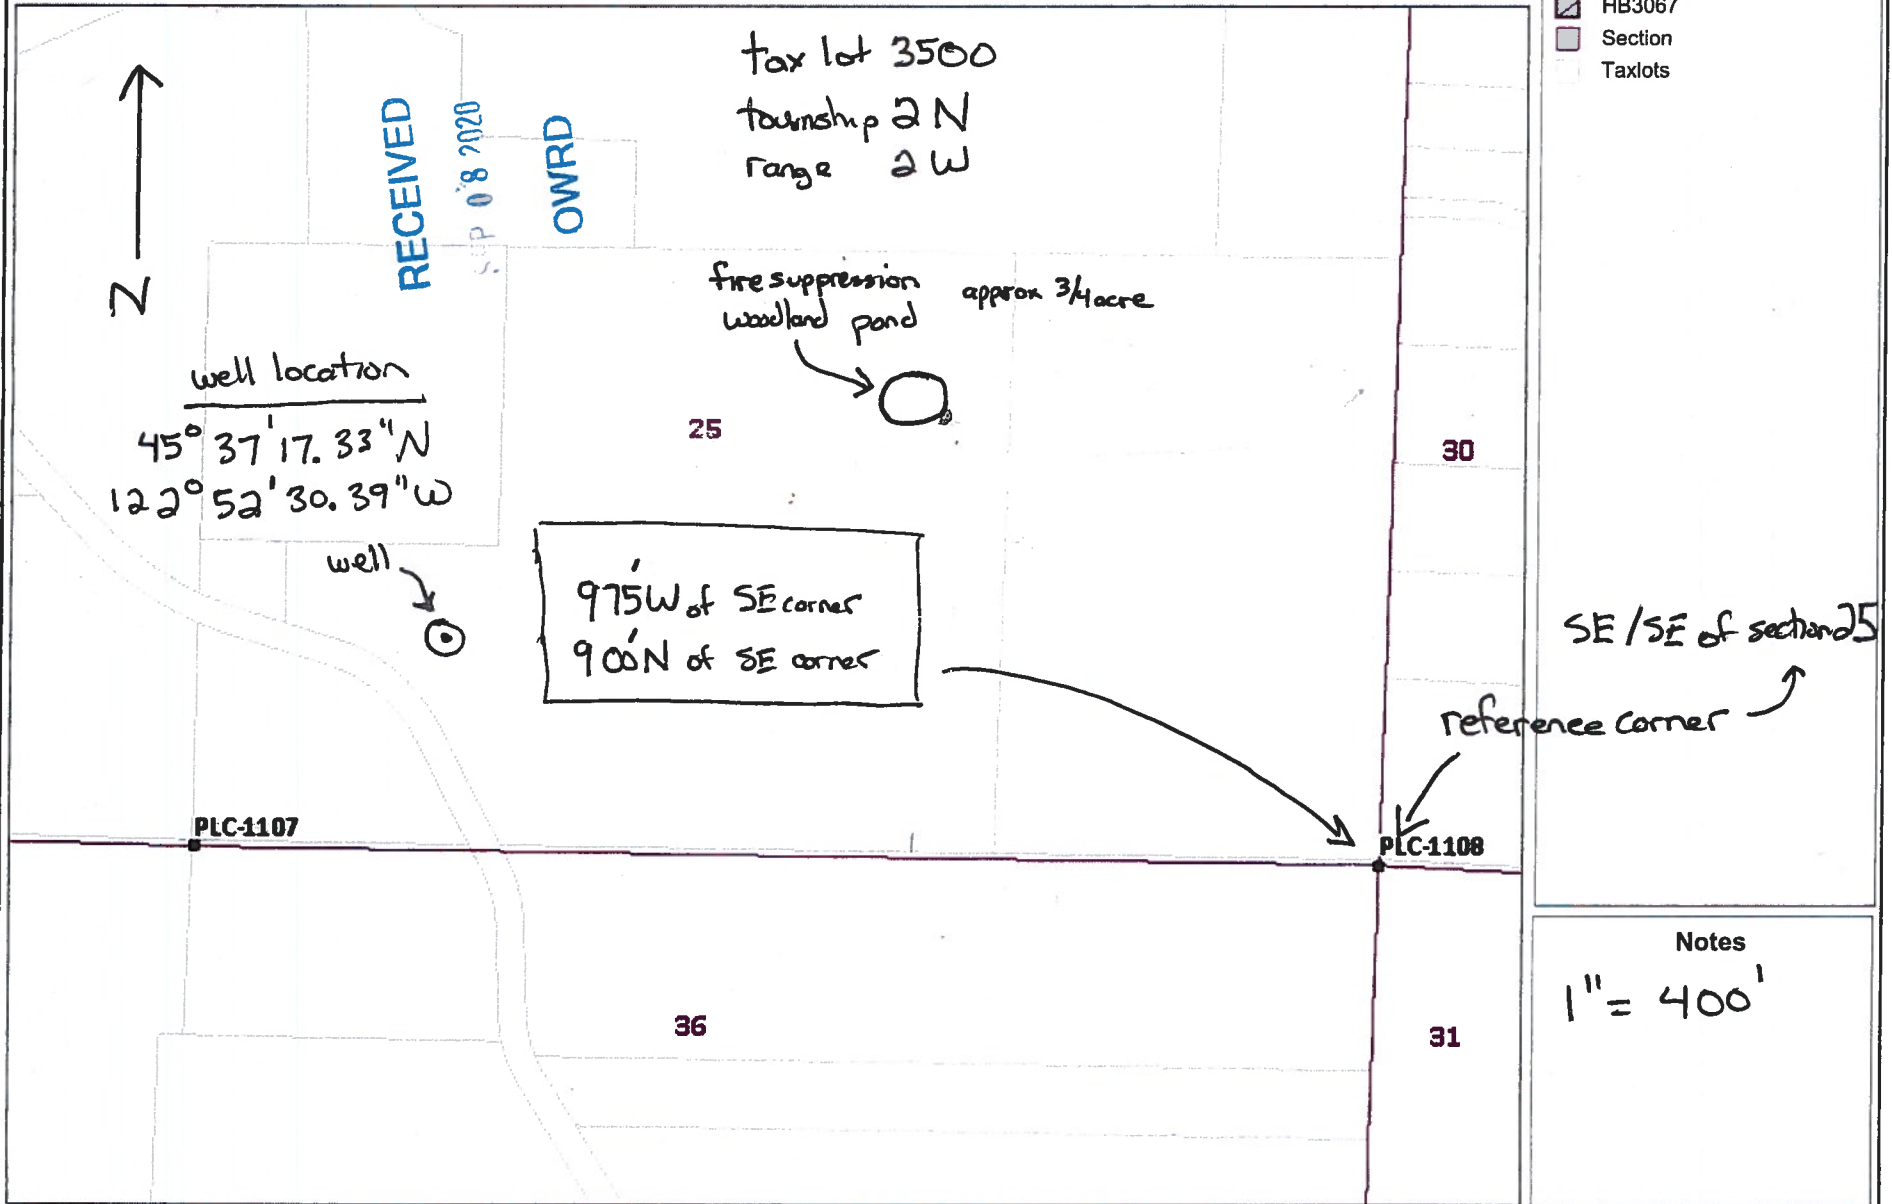

This map is provided for informational purposes only. Information used to develop this map has been obtained from many sources, and is not guaranteed to be accurate. Multnomah County assumes no responsibility for the accuracy of information appearing on this map.

Scale: 1: 4,800
Printed: 7/9/2020