


RECEIVED

AUG 26 2020

OWRD PROJECT AN SUBMITTAL CURSIV

1106.82

OWNER ADDRESS:	APPLICANT NAME:	APPLICANT ADDRESS:
	KEVIN & TONYA RAJIC	
	APPLICANT PHONE #:	
	541-895-2408	

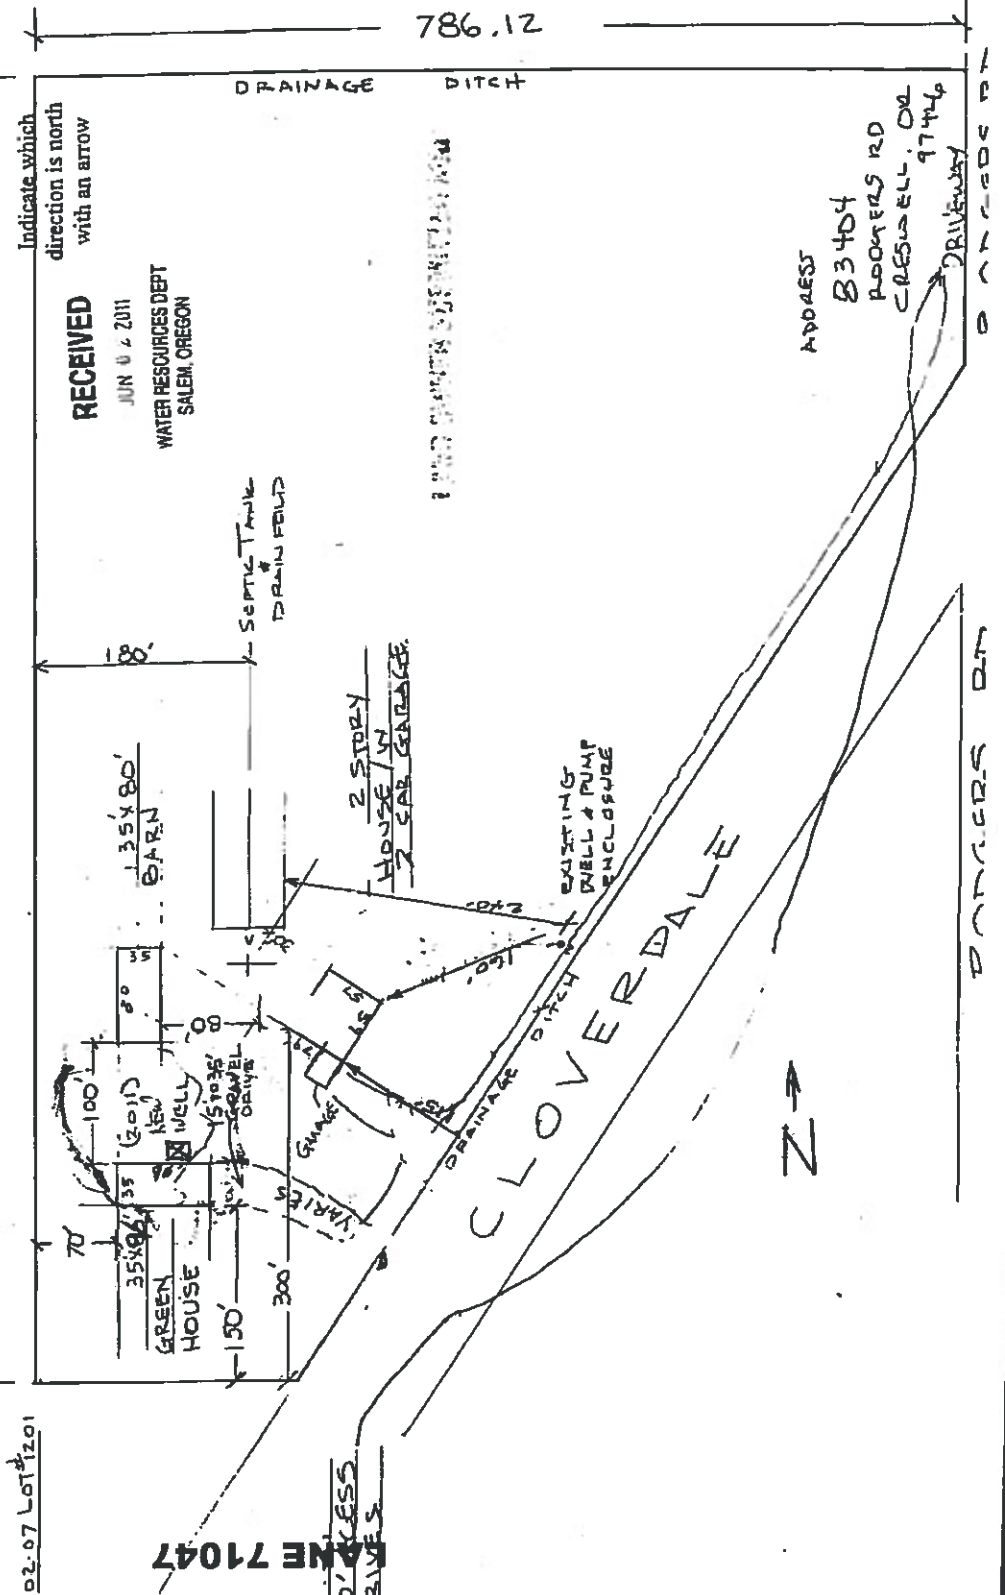

NE SE and SE SE, Section 7
 NW SW, Section 8
 T.19S. R.2W. W.M.
 Lane County, Oregon



1" = 400'

RECEIVED

AUG 26 2020

OWRD

