


RECEIVED

SEP 11 2020

OWRD

Dennis and Pamala Amsbaugh
T. 40S R. 20E

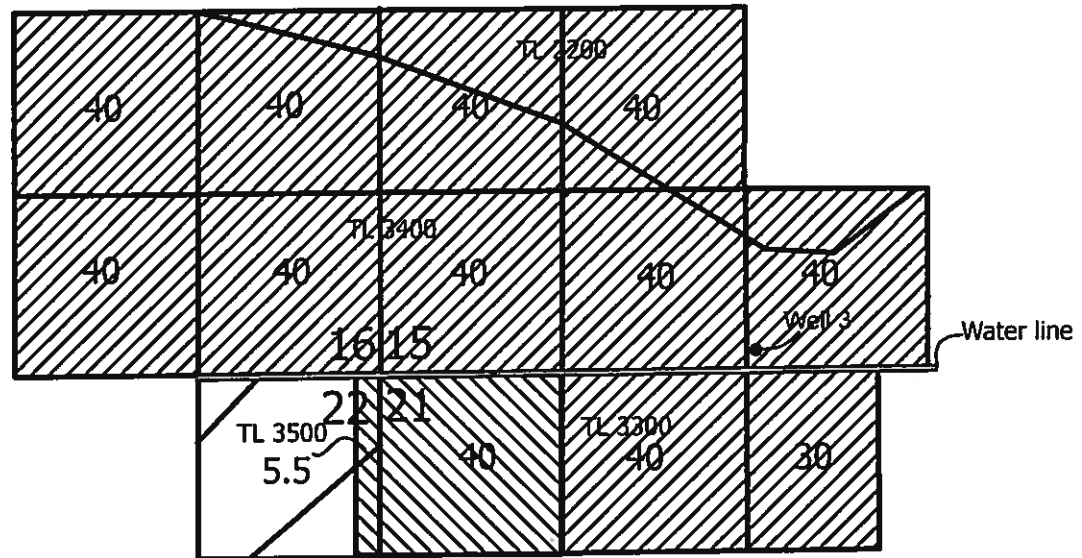

Well 3 is located 2712 ft. East and 155 ft. North of the SW corner of Section 15 T 40 S. R 20 E. WM.

Primary
Supplemental



1 inch = 1,320 feet