



Oregon Water Resources Department  
725 Summer Street NE, Suite A  
Salem, Oregon 97301  
(503) 986-0900  
www.wrd.state.or.us

# Request for Assignment By Proof of Ownership (If Water Right Holder is Not Available)

If the Department determines that the application is incomplete, fees have not been paid, or the required documents are not acceptable, the application and all fees submitted will be returned to the applicant.

If for multiple rights, a separate form and fee for each right will be required.

I, Danny L. + Laurita L. Cron  
(Name of Party Requesting Assignment)  
Box 386 Bonanza OR 97623 541-887-7270  
(Mailing Address) (City) (State) (Zip) (Phone #)

- hereby request assignment of an entire application/permit/transfer order /limited license/groundwater statement;
- hereby request assignment of a portion of application/permit/transfer order/limited license/groundwater statement; (You must include a map showing the portion of the application/permit/ transfer order /limited license/groundwater statement to be assigned.)

Application # 12955 ; Permit # 12457 ; Transfer Order # \_\_\_\_\_;

Limited License # \_\_\_\_\_ ; Groundwater Statement # \_\_\_\_\_;

Penny J Pickett  
(Name of Current Holder of Record)  
27650 YONNA WOODS Rd Bonanza OR 97623 541-892-3915  
(Mailing Address) (City) (State) (Zip) (Phone #)

Note: Write the initials (first letters) of your first and last names at the spots indicated below \_\_\_\_\_.

- 1) \_\_\_\_\_ I certify that I am the current owner of the property described in this application, permit, transfer order, limited license, or groundwater statement. I have attached proof of ownership that may include but not be limited to: a copy of the deed to the land, a copy of a land sales contract, a court order or decree, documentation of survivorship of property held jointly. The Department cannot accept a copy of a tax statement.
- 2) DL I have the legal right to request assignment under OAR 690-310-0280 and 690-320-0060.
- 3) \_\_\_\_\_ I have not been able to contact the owner(s) of record for the above referenced transaction. I have attached proof acceptable to the Department that notice of the assignment has been given or attempted for each identified property owner not a party to the assignment. ORS 537.220(2) Failure to submit this proof will result in the return of your request. (Proof may include but not be limited to: a copy of returned certified mailing, copy of a Death Certificate, or a court order.)
- 4) DL I further certify that the information provided herein is true and correct to the best of my knowledge.

Witness my hand this 9 day of Sept, 2020.  
(Day) (Month) (Year)

Signature of Party Requesting Assignment Danny L. Cron

Failure to provide any of the required information will result in the return of your application.

This certifies assignment and record change at Oregon Water Resources Department effective 8:00 a.m. on date of receipt at Salem, Oregon.

Fee receipt # 132571  
For Director by Mary F. Bjork, Program Analyst in Water Rights Division. MFB

The completed "Request for Assignment" form must be submitted to the Department along with the recording fee of \$100.

part. assign by Proof - Approve  
MFB 9-22-2020



Oregon Water Resources Department  
725 Summer Street NE, Suite A  
Salem, Oregon 97301  
(503) 986-0900  
www.wrd.state.or.us

# Request for Assignment

RECEIVED

MAY 21 2020

OWRD

If the Department determines that the application is incomplete, fees have not been paid, or the required documents are not acceptable, the application and all fees submitted will be returned to the applicant.

If for multiple rights, a separate form and fee for each right will be required.

I, Penny J. Pickett  
(Name of Current Holder of Record)

27650 YONNA WOOD ROAD BONANZA OR 97623 541-892-3915  
(Mailing Address) (City) (State) (Zip) (Phone #)

- hereby assign all my interest in and to the entire application/permit/transfer/limited license/groundwater statement; (example, sold all the land authorized under the right)
- hereby assign all my interest in and to a portion of application/permit/transfer/limited license/groundwater statement; (You must include a map showing the portion of the application/permit/transfer order/limited license/groundwater statement to be assigned. Example, sold a portion of the land authorized under the right)
- hereby assign a portion of my interest in and to the entire application/permit/transfer/limited license/groundwater statement; (example, adding an additional person)

Application # G-12955 ; Permit # G-12457 ; Transfer # \_\_\_\_\_ ;

Limited License # \_\_\_\_\_ ; Groundwater Statement # \_\_\_\_\_ ;

as filed in the office of the Water Resources Director, to:

Danny L. Cron & Laurita L. Cron  
(Name of New Owner)

Box 386 Bonanza OR 97623 541-887-7270  
(Mailing Address) (City) (State) (Zip) (Phone #)

Note: If there are other owners of the property described in the application, permit, transfer order, limited license, or groundwater statement, you must provide a list of all other owners' names and mailing addresses and attach it to this form. Write the initials (first letters) of your first and last names at the spot indicated below \_\_\_\_\_.

I hereby certify that I have notified all other owners of the property described in this application, permit, transfer order, limited license, or groundwater statement of this Request of Assignment.

Witness my hand this 18<sup>th</sup> day of MAY, 2020.  
(Day) (Month) (Year)

Signature of Current Holder of Record Penny J. Pickett

**Failure to provide any of the required information will result in the return of your application.**

This certifies assignment and record change at Oregon Water Resources Department effective 8:00 a.m. on date of receipt at Salem, Oregon.  
Fee receipt # 132571  
For Director by Mary F. Bjork, Program Analyst in Water Rights Division. MFB

The completed "Request for Assignment" form *must* be submitted to the Department along with the recording fee of \$100.

part. assign by proof - approve  
MFB 9-22-2020





Oregon Water Resources Department  
725 Summer Street NE, Suite A  
Salem, Oregon 97301  
(503) 986-0900  
www.wrd.state.or.us

# Request for Assignment By Proof of Ownership (If Water Right Holder is Not Available)

If the Department determines that the application is incomplete, fees have not been paid, or the required documents are not acceptable, the application and all fees submitted will be returned to the applicant.

If for multiple rights, a separate form and fee for each right will be required.

I, Walter P and Nancy L Hammerich  
(Name of Party Requesting Assignment)  
28989 Casebear Rd Bonanza OR 97623 541-274-0002  
(Mailing Address) (City) (State) (Zip) (Phone #)

- hereby request assignment of an entire application/permit/transfer order /limited license/groundwater statement;
- hereby request assignment of a portion of application/permit/transfer order/limited license/groundwater statement; (You must include a map showing the portion of the application/permit/transfer order /limited license/groundwater statement to be assigned.)

Application # 12955 ; Permit # 12457 ; Transfer Order # \_\_\_\_\_ ;

Limited License # \_\_\_\_\_ ; Groundwater Statement # \_\_\_\_\_ ;

William E. Brock  
(Name of Current Holder of Record)  
P.O. Box 212 Bonanza OR 97623 541-892-8855  
(Mailing Address) (City) (State) (Zip) (Phone #)

Note: Write the initials (first letters) of your first and last names at the spots indicated below nh wh

- nh wh I certify that I am the current owner of the property described in this application, permit, transfer order, limited license, or groundwater statement. I have attached proof of ownership that may include but not be limited to: a copy of the deed to the land, a copy of a land sales contract, a court order or decree, documentation of survivorship of property held jointly. The Department cannot accept a copy of a tax statement.
- nh wh I have the legal right to request assignment under OAR 690-310-0280 and 690-320-0060.
- nh wh I have not been able to contact the owner(s) of record for the above referenced transaction. I have attached proof acceptable to the Department that notice of the assignment has been given or attempted for each identified property owner not a party to the assignment. ORS 537.220(2) Failure to submit this proof will result in the return of your request. (Proof may include but not be limited to: a copy of returned certified mailing, copy of a Death Certificate, or a court order.)
- nh wh I further certify that the information provided herein is true and correct to the best of my knowledge.

Witness my hand this 8 day of Sept, 2020.  
(Day) (Month) (Year)

Signature of Party Requesting Assignment Nancy Hammerich  
Failure to provide any of the required information will result in the return of your application.

This certifies assignment and record change at Oregon Water Resources Department effective 8:00 a.m. on date of receipt at Salem, Oregon.

Fee receipt # 132571  
For Director by Mary F. Bjork, Program Analyst in Water Rights Division. MFB

The completed "Request for Assignment" form must be submitted to the Department along with the recording fee of \$100.

part. assign by proof - Approve  
HOB 9-22-2020



MAY 21 2020

OWRD



Oregon Water Resources Department
725 Summer Street NE, Suite A
Salem, Oregon 97301
(503) 986-0900
www.wrd.state.or.us

Request for Assignment

If the Department determines that the application is incomplete, fees have not been paid, or the required documents are not acceptable, the application and all fees submitted will be returned to the applicant.

If for multiple rights, a separate form and fee for each right will be required.

I, William E. Brock
(Name of Current Holder of Record)
P.O. Box 212 Bondzga OR 97623 5-28
(Mailing Address) (City) (State) (Zip) (Phone #) 541-892-8855

- hereby assign all my interest in and to the entire application/permit/transfer/limited license/groundwater statement;
hereby assign all my interest in and to a portion of application/permit/transfer/limited license/groundwater statement;
hereby assign a portion of my interest in and to the entire application/permit/transfer/limited license/groundwater statement;

Application # G-12955 ; Permit # G-12457 ; Transfer # ;
Limited License # ; Groundwater Statement #

as filed in the office of the Water Resources Director, to:

Walter + Nancy Hammerich
(Name of New Owner)
28989 casebeer rd Bonanza OR 97623 541-274-0002
(Mailing Address) (City) (State) (Zip) (Phone #)

Note: If there are other owners of the property described in the application, permit, transfer order, limited license, or groundwater statement, you must provide a list of all other owners' names and mailing addresses and attach it to this form.

I hereby certify that I have notified all other owners of the property described in this application, permit, transfer order, limited license, or groundwater statement of this Request of Assignment.

Witness my hand this 18 day of May, 2020.
(Day) (Month) (Year)

Signature of Current Holder of Record William E Brock

Failure to provide any of the required information will result in the return of your application.

This certifies assignment and record change at Oregon Water Resources Department effective 8:00 a.m. on date of receipt at Salem, Oregon. Fee receipt # 132571 For Director by Mary F. Bjork. Program Analyst in Water Rights Division.

The completed "Request for Assignment" form must be submitted to the Department along with the recording fee of \$100.

part assign by proof- Approve HOB 9-22-2020



Oregon Water Resources Department  
725 Summer Street NE, Suite A  
Salem, Oregon 97301  
(503) 986-0900  
www.wrd.state.or.us

# Request for Assignment

If the Department determines that the application is incomplete, fees have not been paid, or the required documents are not acceptable, the application and all fees submitted will be returned to the applicant.

If for multiple rights, a separate form and fee for each right will be required.

I, Northwest Farm Credit Services, FLCA

(Name of Current Holder of Record)

300 Klamath Ave, Ste 200,

(Mailing Address)

Klamath Falls, OR 97601

(City) (State) (Zip) (Phone #)

541-850-7500

hereby assign all my interest in and to the entire application/permit/transfer/limited license/groundwater statement; (example, sold all the land authorized under the right)

hereby assign all my interest in and to a portion of application/permit/transfer/limited license/groundwater statement; (*You must include a map showing the portion of the application permit/transfer order/limited license/groundwater statement to be assigned.* Example, sold a portion of the land authorized under the right)

hereby assign a portion of my interest in and to the entire application/permit/transfer/limited license/groundwater statement; (example, adding an additional person)

Application # G-12955; Permit # G-12457; Transfer # \_\_\_\_\_;

Limited License # \_\_\_\_\_; Groundwater Statement # \_\_\_\_\_;

as filed in the office of the Water Resources Director, to:

William Brock & Melyn Brock

(Name of New Owner)

PO Box 212

(Mailing Address)

Bonanza, OR 97623

(City) (State) (Zip) (Phone #)

541-892-8855

Notes: If there are other owners of the property described in the application, permit, transfer order, limited license, or groundwater statement, you must provide a list of all other owners' names and mailing addresses and attach it to this form. Write the initials (first letters) of your first and last names at the spot indicated below \_\_\_\_\_.

I hereby certify that I have notified all other owners of the property described in this application, permit, transfer order, limited license, or groundwater statement of this Request of Assignment.

Witness my hand this 15th day of September, 2020.  
(Day) (Month) (Year)

Signature of Current Holder of Record

DocuSigned by:  
Kari Delaney

**Failure to provide any of the required information will result in the return of your application.**

This certifies assignment and record change at Oregon Water Resources Department effective 8:00 a.m. on date of receipt at Salem, Oregon.  
Fee receipt # 132571  
For Director by Mary F. Bjork, Program Analyst in Water Rights Division. MOBI

The completed "Request for Assignment" form *must* be submitted to the Department along with the recording fee of \$100.

RECEIVED  
SEP 15 2020  
OWRD

part. assign. by proof-  
Approve  
H&B 9-22-2020




# CLAIM OF BENEFICIAL

FOR



# WILLIAM & MEL TERRY & PENN

SECTIONS 3, 4, & 10, TOWNSHIP 3  
KLAMATH COUNTY,

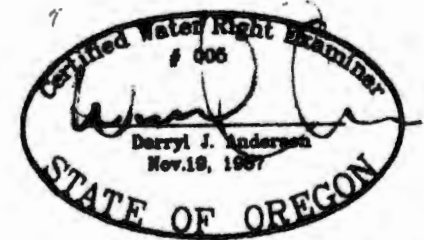

RENEWAL 12/31/07

**LEGEND**

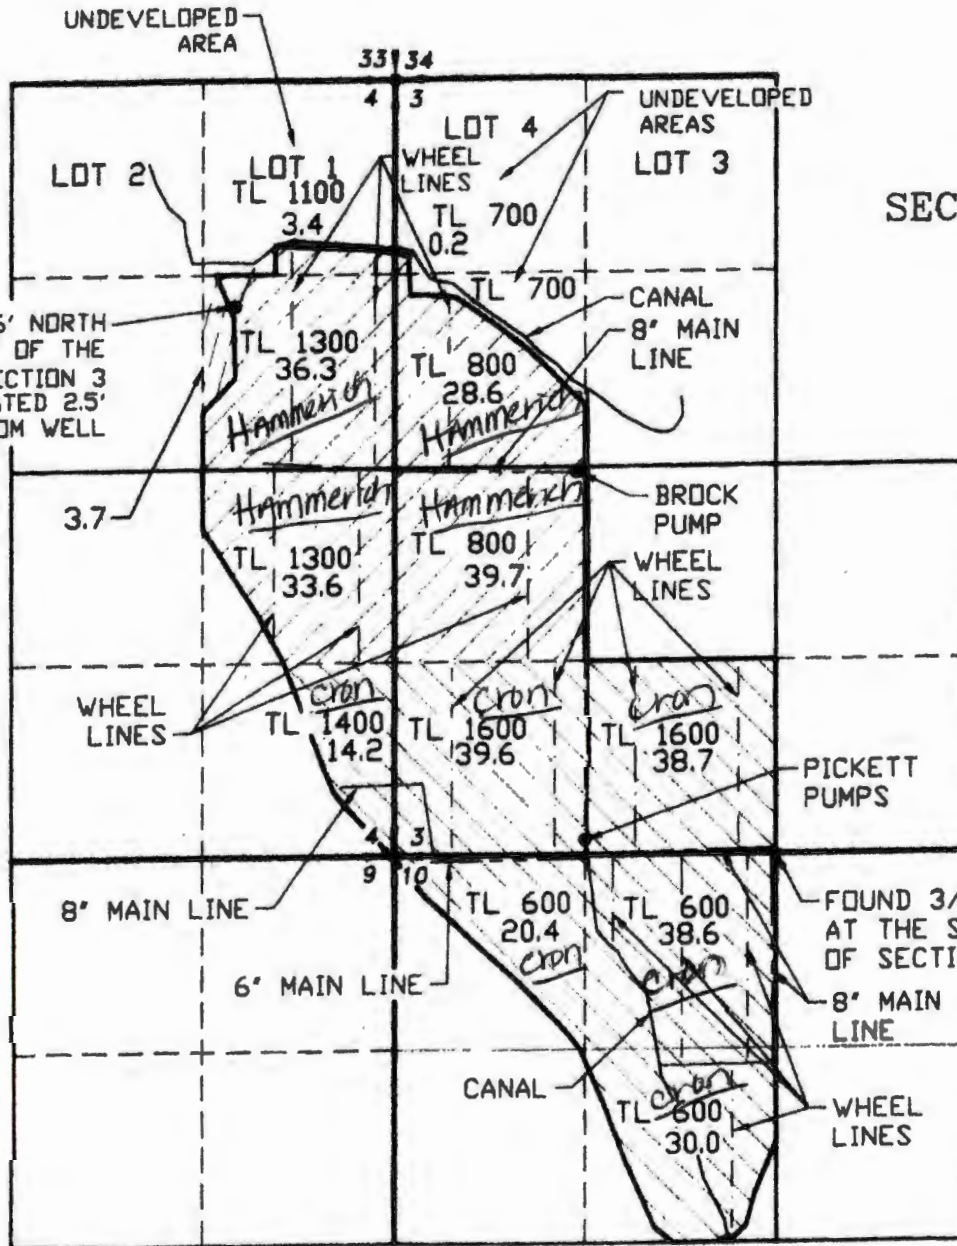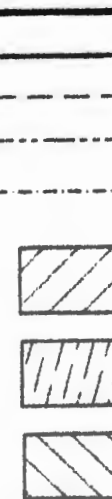

WELL LOCATED 3745.86' NORTH  
AND 3730.39' WEST OF THE  
SOUTH 1/4 CORNER OF SECTION 3  
FLOWMETER IS LOCATED 2.5'  
FROM WELL

FOUND 3/4" IRON PIN  
AT THE SOUTH 1/4 CORNER  
OF SECTION 3



APPLICATION NO  
PERMIT NO

RECEIVED  
SEP 15 2020  
OWRD