

GR-2931

June 30, 1959

Mrs. LaVerne W. Stevens
955 Ferguson Road
Junction City, Oregon

Dear Mrs. Stevens:

GR-2931

GR-2757

GR-2931

August 8, 1958

LaVerne Stevens
955 Ferguson Road
Junction City, Oregon

Dear Mr. Stevens:

15.00


18644

2931

14 13
23 24

North

RECORDED

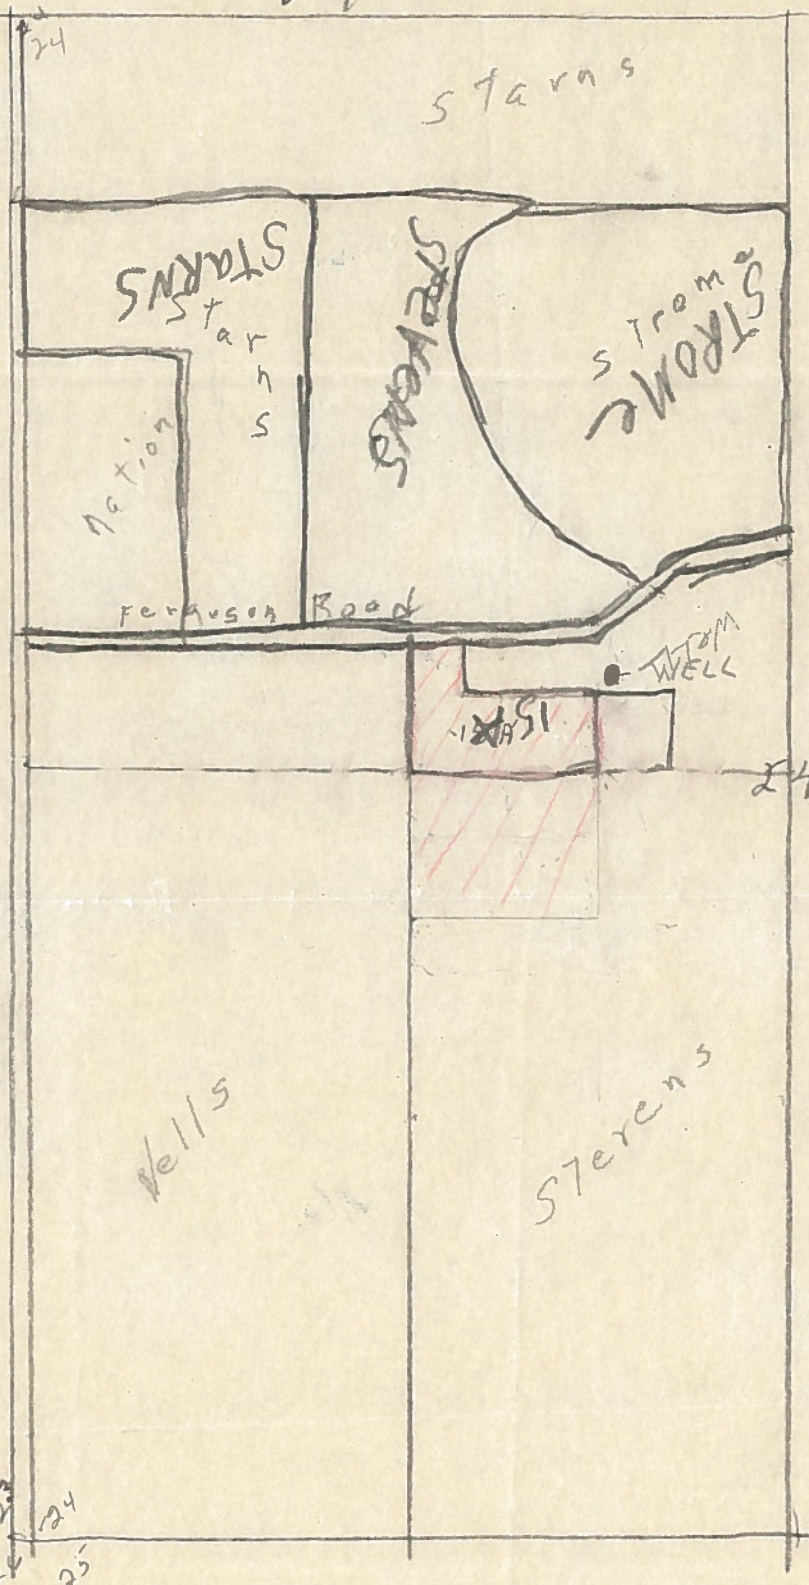

1" = 660'