

**CLAIM OF
BENEFICIAL USE
for Reservoirs**
storing less than



Oregon Water Resources Department
725 Summer Street NE, Suite A
Salem, Oregon 97301-1266
(503) 986-0900
www.oregon.gov/OWRD

A fee of \$200 must accompany this form.
The Claim will be returned if the fee is not included.

RECEIVED
OCT 30 2020
OWRD

This form may be completed by the permit holder of record if:

- 1) The permit was issued under the authority of ORS 537.409; and
- 2) No secondary permit exists for the use of water stored in the reservoir; and
- 3) The developed capacity of the reservoir is less than 9.2 acre-feet; and
- 4) The water was stored by the date required in the permit; and

A separate form shall be completed for each permit.

This form must be submitted to the Water Resources Department within

7

**SECTION 1
GENERAL INFORMATION**

File Information:

APPLICATION # R- 87224	PERMIT # R- 14684
---------------------------	----------------------

Applicant Information:

APPLICANT NAME Alex & Leticia Schumacher	PHONE NO. 541-459-2390	ADDITIONAL CONTACT NO. 541-580-3011
ADDRESS 1636 Schneider's Rd		
CITY Sutherlin	STATE OR	ZIP 97479
E-MAIL racinstormvance@yahoo		

SECTION 2
RESERVOIR INFORMATION

RECEIVED

OCT 30 2020

OWRD

Reservoir Dimensions and Capacity:

AVERAGE LENGTH	AVERAGE WIDTH	AVERAGE DEPTH	MAXIMUM CAPACITY IN ACRE-FEET
70'	30'	4'	.19

To determine capacity in acre-feet use for the above table, use the following calculation:

$$\text{Acre-feet} = \frac{(\text{Average Length})(\text{Average Width})(\text{Average Depth})}{43,560}$$

SECTION 3

MAP

Attach a map identifying the reservoir location. If the water right application map accurately reflects the location of the reservoir, you may attach a copy of it. Otherwise, you must submit a map meeting the standards of OAR 690-310-0050, which are attached.


Preparation of the map by a Certified Water Rights Examiner is not required for this type of permit, but may be submitted.

SECTION 4

SIGNATURE

This Claim of Beneficial Use must be signed by each permit holder of record.

By my signature, I certify that the information contained herein is true and correct to the best of my knowledge.

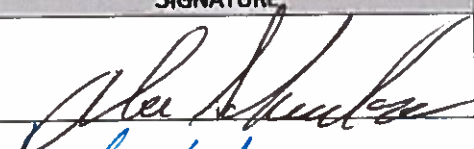SIGNATURE	PRINT OR TYPE NAME	TITLE	DATE
	ALEX SCHUMACHER	owner	10/26/20
	Leslie Schumacher	owner	10/26/20

RECEIVED


OCT 30 2020 RECEIVED

OWRD OCT 30 2020

OWRD

T. 25 S., R. 6 W., W. M.

Scale: 1" = 1000'

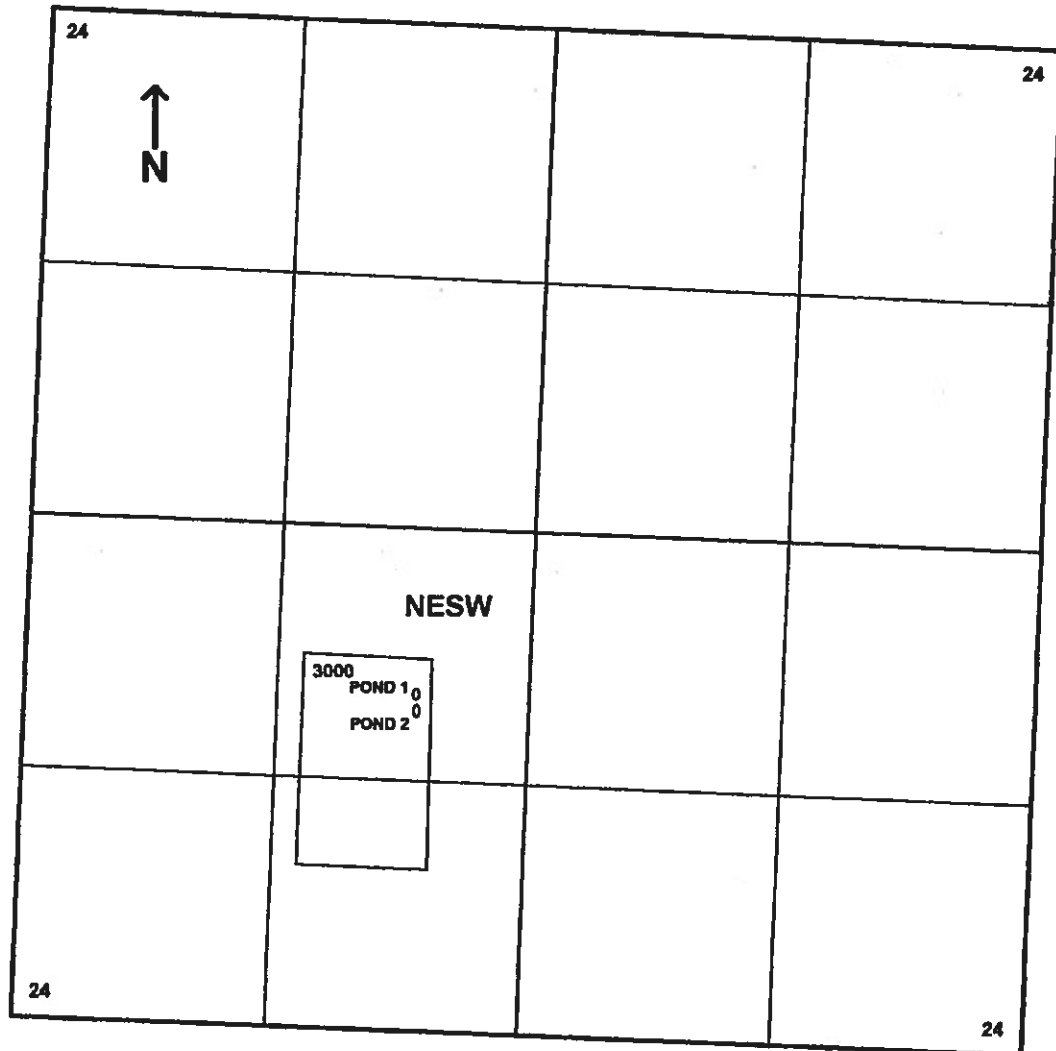

POND 1 - 860 ft. S. and 580 ft. W.

} from the center of Sec. 24

POND 2 - 950 ft. S. and 580 ft. W.