

**CLAIM OF
BENEFICIAL USE
for Reservoirs
storing less than**



Oregon Water Resources Department
725 Summer Street NE, Suite A
Salem, Oregon 97301-1266
(503) 986-0900
www.oregon.gov/OWRD

**A fee of \$200 must accompany this form.
The Claim will be returned if the fee is not included.**

This form may be completed by the permit holder of record if:

- 1) The permit was issued under the authority of ORS 537.409; and
- 2) No secondary permit exists for the use of water stored in the reservoir; and
- 3) The developed capacity of the reservoir is less than 9.2 acre-feet; and
- 4) The water was stored by the date required in the permit; and

A separate form shall be completed for each permit.

This form must be submitted to the Water Resources Department within

RECEIVED

OCT 30 2020

OWRD

SECTION 1

GENERAL INFORMATION

File Information:

APPLICATION # R- 87223	PERMIT # R-14685
---------------------------	---------------------

Applicant Information:

APPLICANT NAME ALEY & LESLIE SCHUMACHER		PHONE NO. 541-459-2390	ADDITIONAL CONTACT NO. 541-580-3011
ADDRESS 1636 Schuderske Rd			
CITY Sutherlin	STATE OR	ZIP 97479	E-MAIL rainstormranch@yahoo.

SECTION 2

RESERVOIR INFORMATION

Reservoir Dimensions and Capacity:

AVERAGE LENGTH	AVERAGE WIDTH	AVERAGE DEPTH	MAXIMUM CAPACITY IN ACRE-FEET
124'	30'	4'	.34

To determine capacity in acre-feet use for the above table, use the following calculation:

$$\text{Acre-feet} = \frac{(\text{Average Length})(\text{Average Width})(\text{Average Depth})}{43,560}$$

SECTION 3

MAP

Attach a map identifying the reservoir location. If the water right application map accurately reflects the location of the reservoir, you may attach a copy of it. Otherwise, you must submit a map meeting the standards of OAR 690-310-0050, which are attached.

Preparation of the map by a Certified Water Rights Examiner is **not** required for this type of permit, but may be submitted.

SECTION 4

SIGNATURE


RECEIVED

OCT 30 2020

OWRD


This Claim of Beneficial Use must be signed by each permit holder of record.

By my signature, I certify that the information contained herein is true and correct to the best of my knowledge.

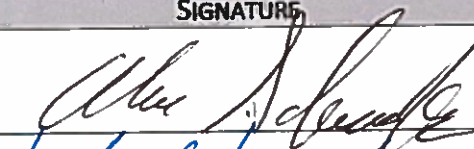SIGNATURE	PRINT OR TYPE NAME	TITLE	DATE
	ALEX SCHUMACHER	owner	10-15-2020
	LESLIE SCHUMACHER	owner	10-15-2020

T. 25 S., R. 6 W., W. M.

Scale: 1" = 1000'

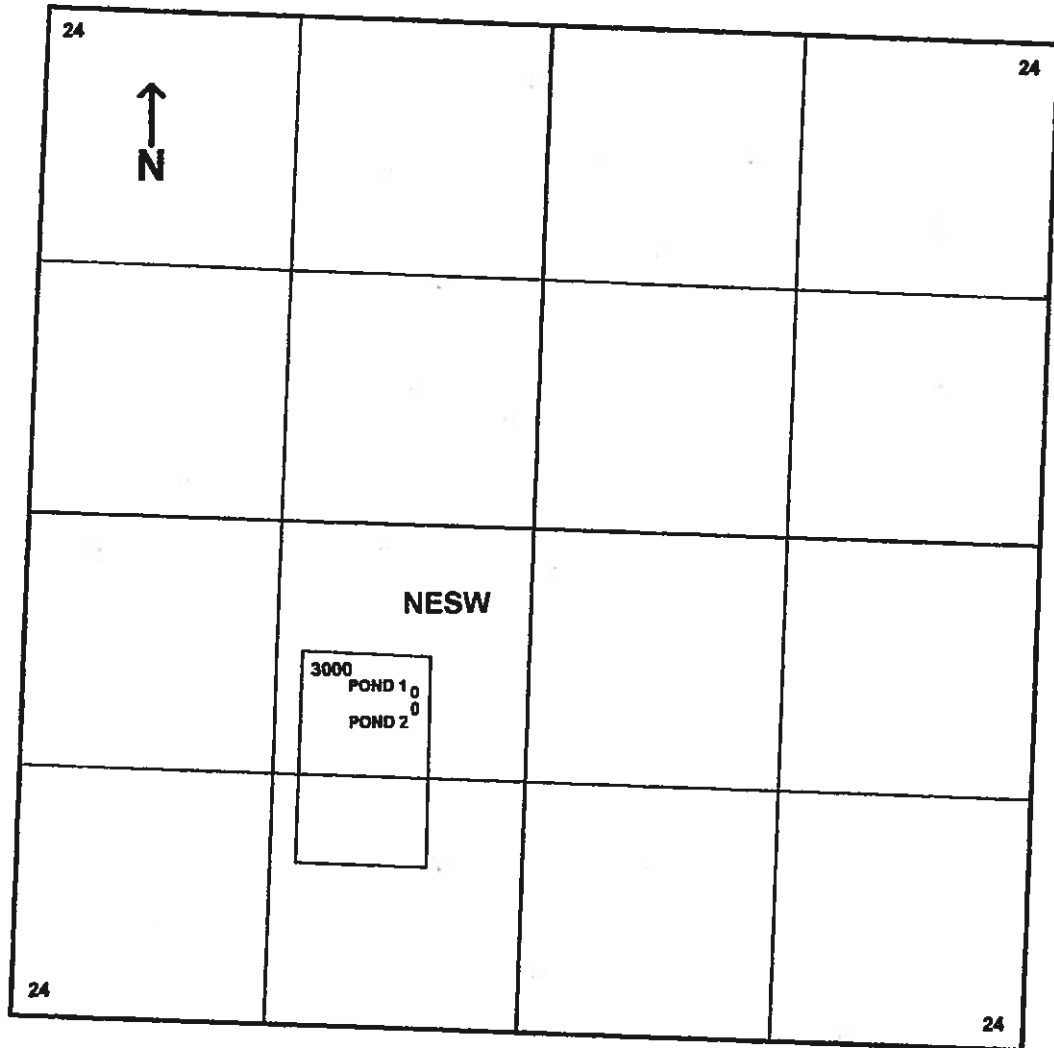

POND 1 - 860 ft. S. and 580 ft. W.

} from the center of Sec. 24

POND 2 - 950 ft. S. and 580 ft. W.

RECEIVED

OCT 30 2020

OWRD

RECEIVED


JUL 14 2008

**WATER RESOURCES DEPT
SALEM, OREGON**

App No B87223 Permit No R14685

T. 25 S., R. 6 W., W. M.

Scale: 1" = 1000'

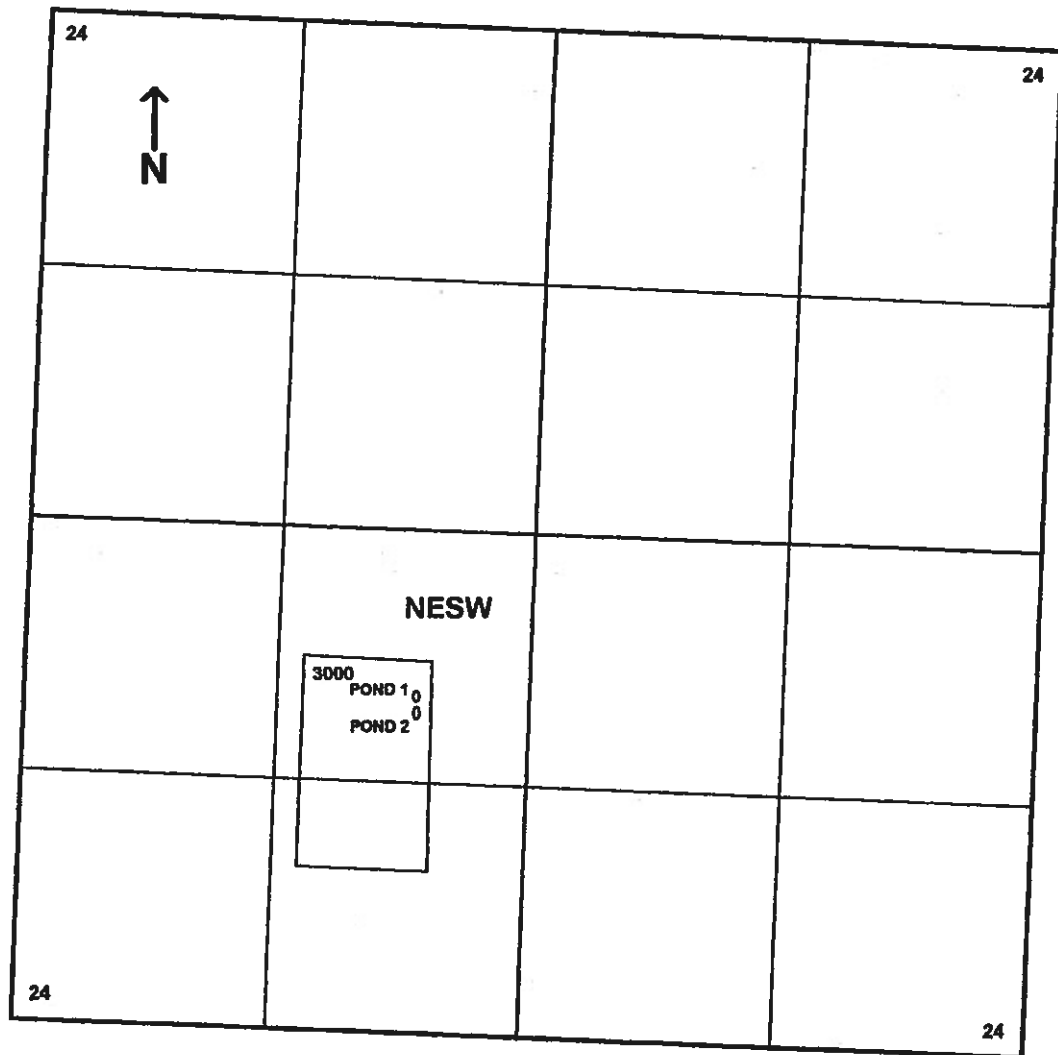

POND 1 - 860 ft. S. and 580 ft. W.

} from the center of Sec. 24

POND 2 - 950 ft. S. and 580 ft. W.

RECEIVED

OCT 30 2020

OWRD