



Public GIS 2019

Public ArcGIS Application

LOCATION MAP



Find address or place




RECEIVED

FEB 13 2020

OWRD

Reservoir Location:
220 feet East and 63 feet South from the N1/4 Corner, Section 31

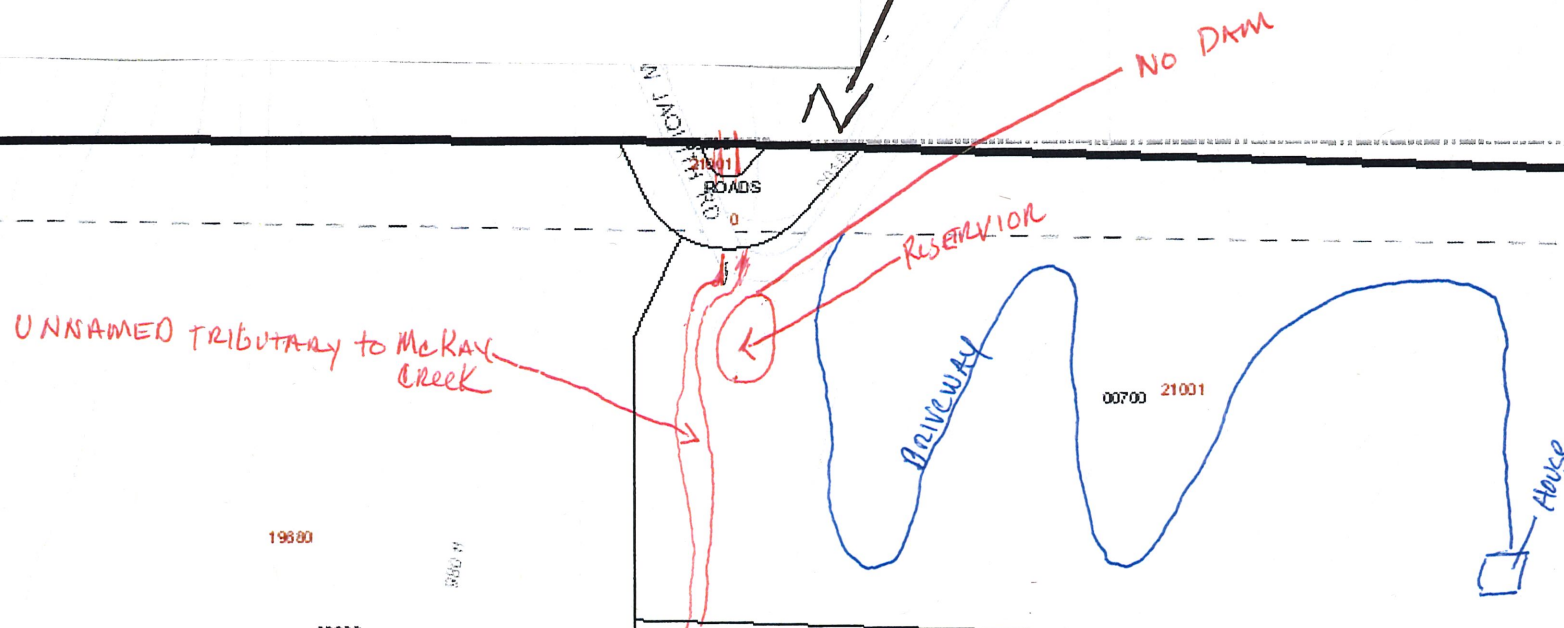

100ft

-122.979 45.361 Degrees

SCALE 1" = 130' FT

TOWNSHIP
2S

RANGE
2W

SECTION
31

1/4
N 1/4

TAX LOT #
R22310700