


# HERMISTON MUNICIPAL WELLS 5-MILE RADIUS

**DRAFT**

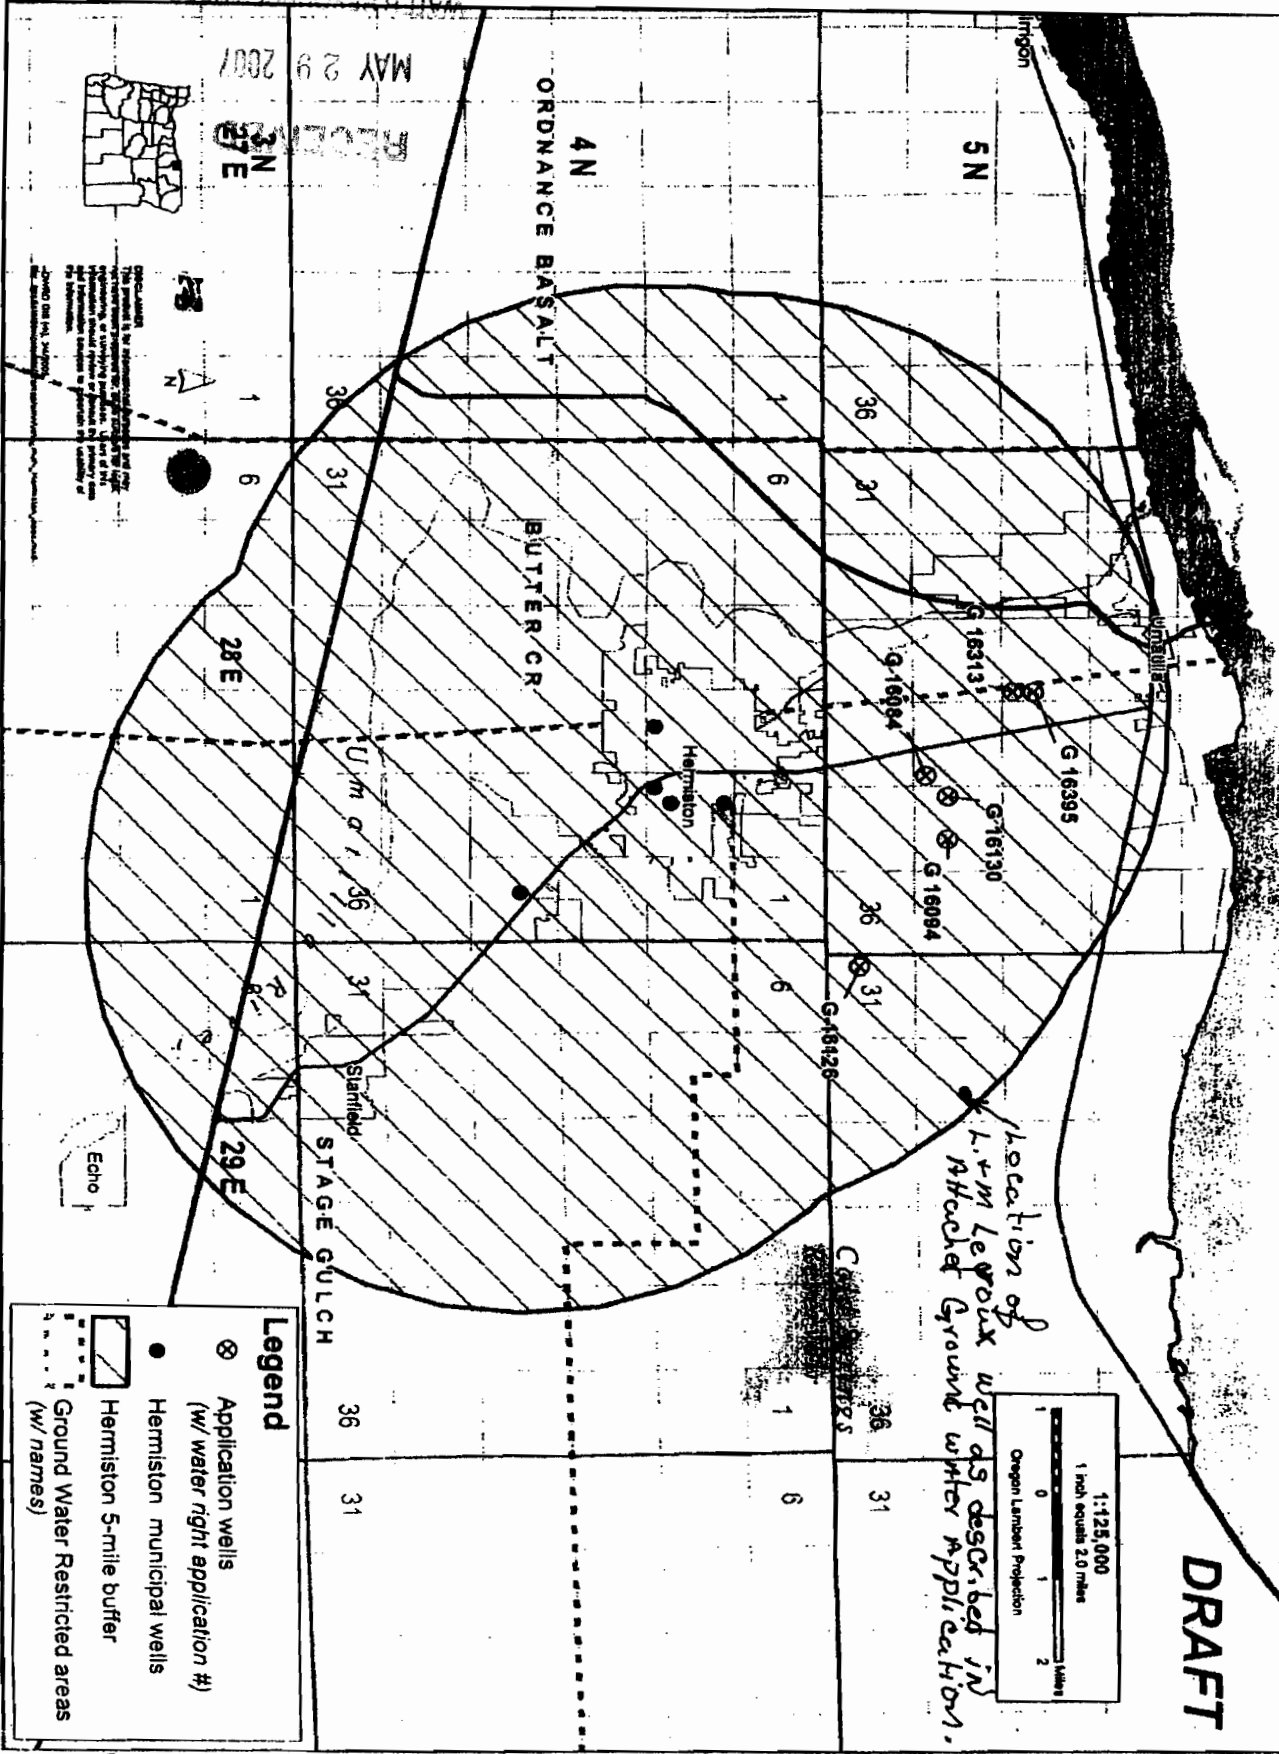

**Legend**

- ⊗ Application wells (w/ water right application #)
- Hermiston municipal wells
- ▨ Hermiston 5-mile buffer
- ▤ Ground Water Restricted areas (w/ names)

 DATE: MAY 29 2007

