




# Oregon Water Resources Department Notice of Exempt Reservoir

For reservoirs built before January 1, 1995, that:

- Store less than 9.2 acre-feet of water, or
- Have a dam less than 10 feet high.

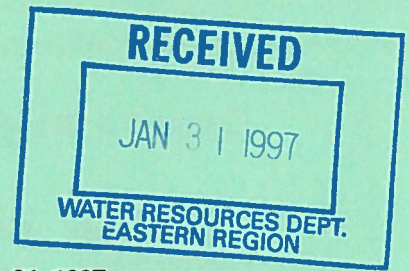

The deadline for submitting a Notice of Exempt Reservoir is January 31, 1997.

Landowner: Niezen, Gerald L  
Last name First name MI

Authorized Agent: \_\_\_\_\_, \_\_\_\_\_ MI  
Last name First name MI

Address: 61608 Tucker Down Rd  
Joseph Oregon 97846  
City State Zip

Phone: (415) 432-0791 \_\_\_\_\_  
Home Work

FAX: \_\_\_\_\_ E-Mail Address: \_\_\_\_\_

A. County of use: Wallowa . B. River basin (see reverse): 8

C. Legal description of reservoir location:

Township	Range	Section	Quarter/Quarter	Tax Lot #
T2S	R45E	26	<del>Q1NE</del> <del>Q2SE</del>	7900

1991

D. Name, if any, of reservoir: Trudys Pond . E. Reservoir in existence since: 1/1/91  
wallowa River MM DD YY

F. Source of water: Spring, Wallowa Lk which flows into Wallowa  
Name of river or creek Name of river or creek

G. Maximum height of dam: 10 feet.

H. Quantity of water stored in reservoir at maximum capacity (see reverse): 2 acre-feet.

I. Water stored in reservoir is used for (see reverse): LIVESTOCK

J. Rate and area of use—Refer to chart on the back of this form. For each type of water use listed in Item I., show the quantity of water used and, if applicable, the number of acres on which water is used.

**BEFORE YOU SIGN AND SUBMIT THIS APPLICATION . . . HAVE YOU:**

Answered each question on this form as completely as possible?

Attached a legible map showing township, section, range, quarter-quarter & tax lot number?

By my signature below, I swear that all statements made and information provided in this application are true to the best of my knowledge.

[Signature] Gerald Niezen 1-31-97  
(Signature of Landowner/Agent) (Printed name and title) (Date)

For Department Use P-83273 \_\_\_\_\_ 10-95  
File # Date received

RECEIVED

JAN 31 1997

WATER RESOURCES DEPT.  
EASTERN REGION


6-4

T 2 S

R 45 E

Permit No.

6-3

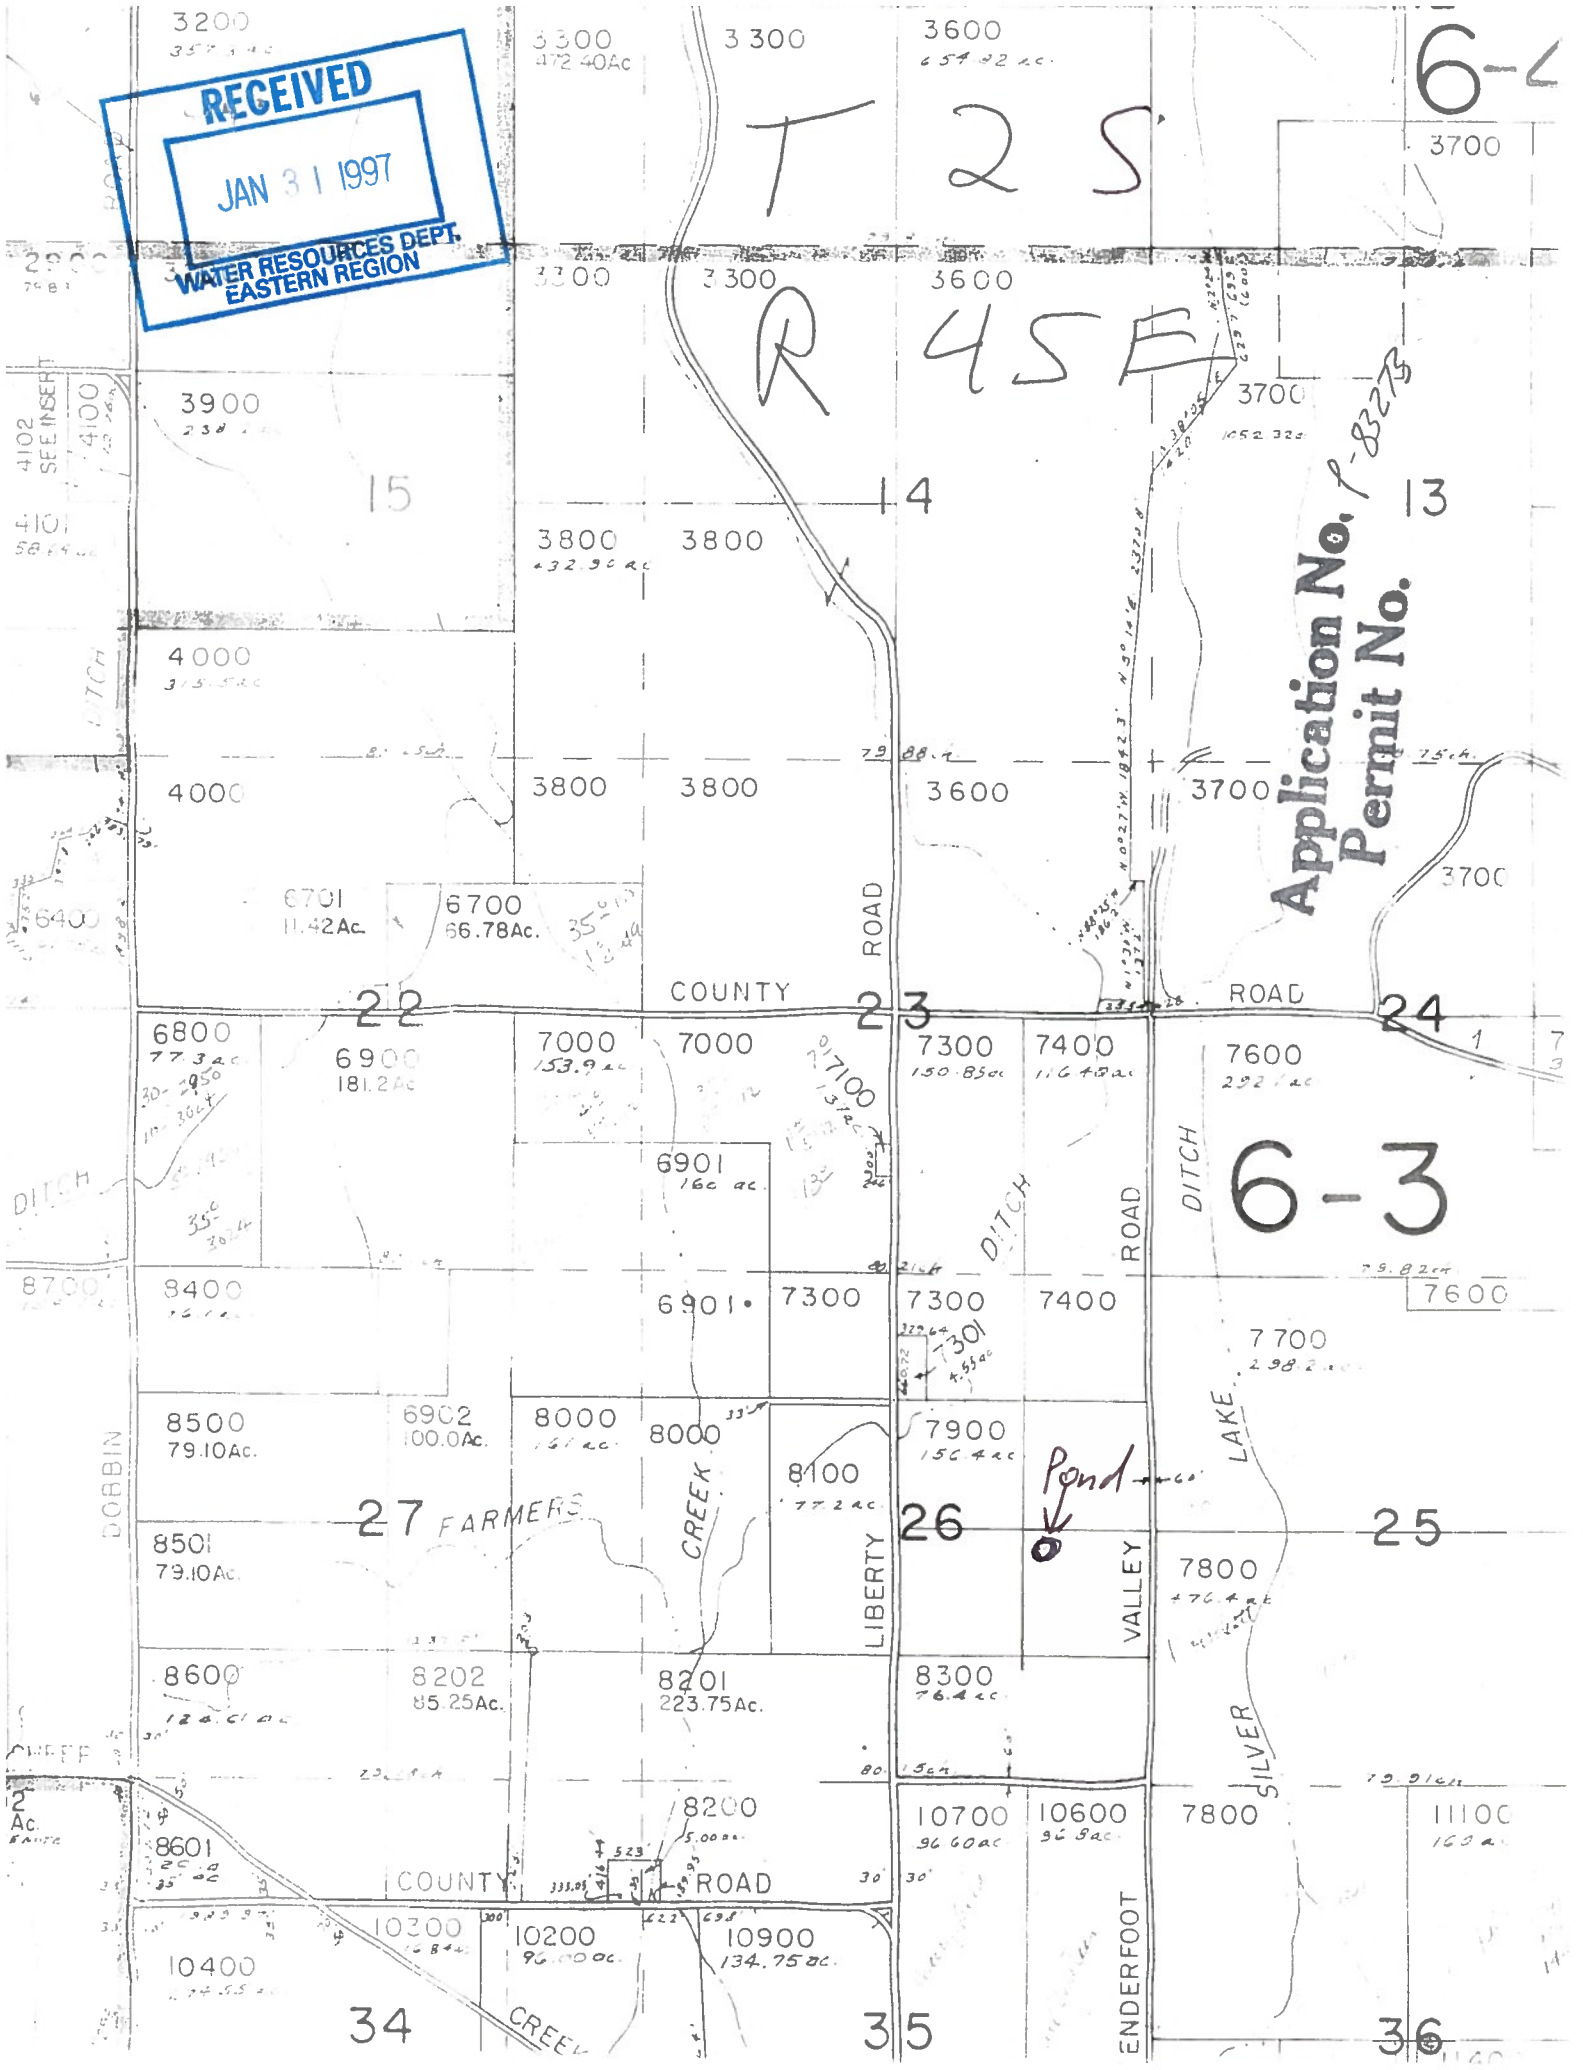



HB 2376 EXEMPT NOTICE  
COMPLETENESS CHECKLIST

- Landowner name and address\*
- A. County of use
- B. River basin
- C. Legal description of reservoir location\*  
(Includes quarter-quarter section and tax lot)
- D. Reservoir name
- E. Date of construction
- F. Source of water and tributary\*
- G. Dam height
- H. Quantity of water stored\*
- I. Use of water
- J. Rate and area of use (if any)
- Signature of Landowner/agent
- Map showing Township, Range, Section, Quarter-quarter section and Tax Lot\* and general location of pond.

Date Received 1-31-97

Received By Richard M. Kurb

\* MINIMUM REQUIREMENT TO FILE

C:\wp51\pondchk