



Oregon Water Resources Department
 725 Summer Street NE, Suite A
 Salem, Oregon 97301
 (503) 986-0900
 www.wrd.state.or.us

Ownership Update For Certificated Rights Only

NO FEES ARE REQUIRED TO SUBMIT THIS FORM

NOTICE: A certificate of water right typically stays with the land. In order to track water right ownership, the Department requests that this form be submitted to the Department. **To update multiple rights, a separate form is required for each right.**

If you have any questions about this form, please contact your local watermaster, or call the Water Resources Department at (503) 986-0900.

This form is not for Applications, Permits, Transfers, Groundwater Registrations, or Limited Licenses. To notify the Department of changes in ownership to these types of authorizations, an Assignment is required.

RECEIVED

AUG 31 2020

Current Landowner Information

Name: PAULA L. GERMOND
 Mailing Address: P.O. Bx 1437
 City: Sutherlin State: OR Zip: 97479
 Phone (Home): 541-459-6542 Work: — Other: —

Property Description


County: Douglas Township: 25S. Range: 7W Section: 29, 30
 Taxlot Number(s): 00900
 Street Address of water right property: 6894 Hubbard Ck. Rd., Umpqua OR
 Water Right Information: Application: — Permit: S³-48060 Certificate #: 64409-66412

Are all the lands associated with this water right owned by the requester? Yes No If No, include a map showing the portion of the right involved.

Name of individual completing this form: Paula Germond Phone: 541-459-6542
 Signature of requestor: [Signature] Date: 8-18-2020

The Department does not change names on certificates. This form will be placed in the file for future reference only. The Department does not provide acknowledgement that this form has been received.

T. 25 S., R. 7 W., W.M.
SECTIONS 29 AND 30.

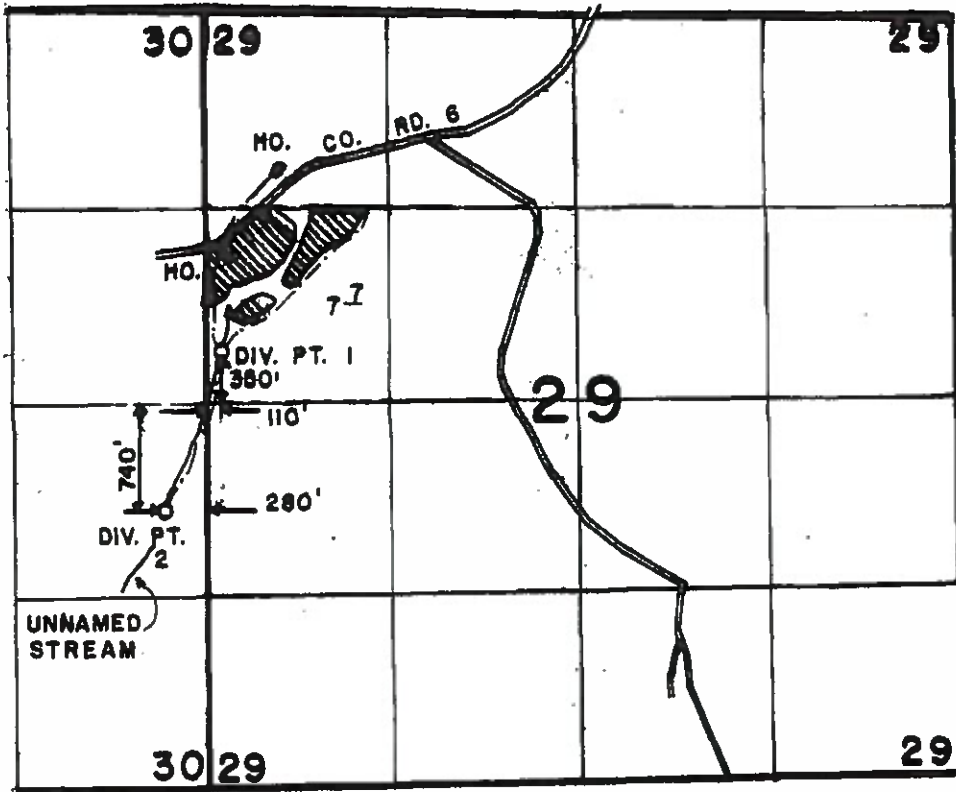

RECEIVED
AUG 31 2020
OWRD

SCALE: 4" = 1 MILE

FINAL PROOF SURVEY
UNDER

Application No. 66412... Permit No. 48060...
IN NAME OF

H.B. AND MELBA L. GERMOND

Surveyed OCT. 13. 1987, by J.M. SCHMORDE