


Application for a Permit to Store Water in a Reservoir Points of Diversion and Reservoir Location

Yamhill County

Township 2 South, Range 4 West (W.M.)

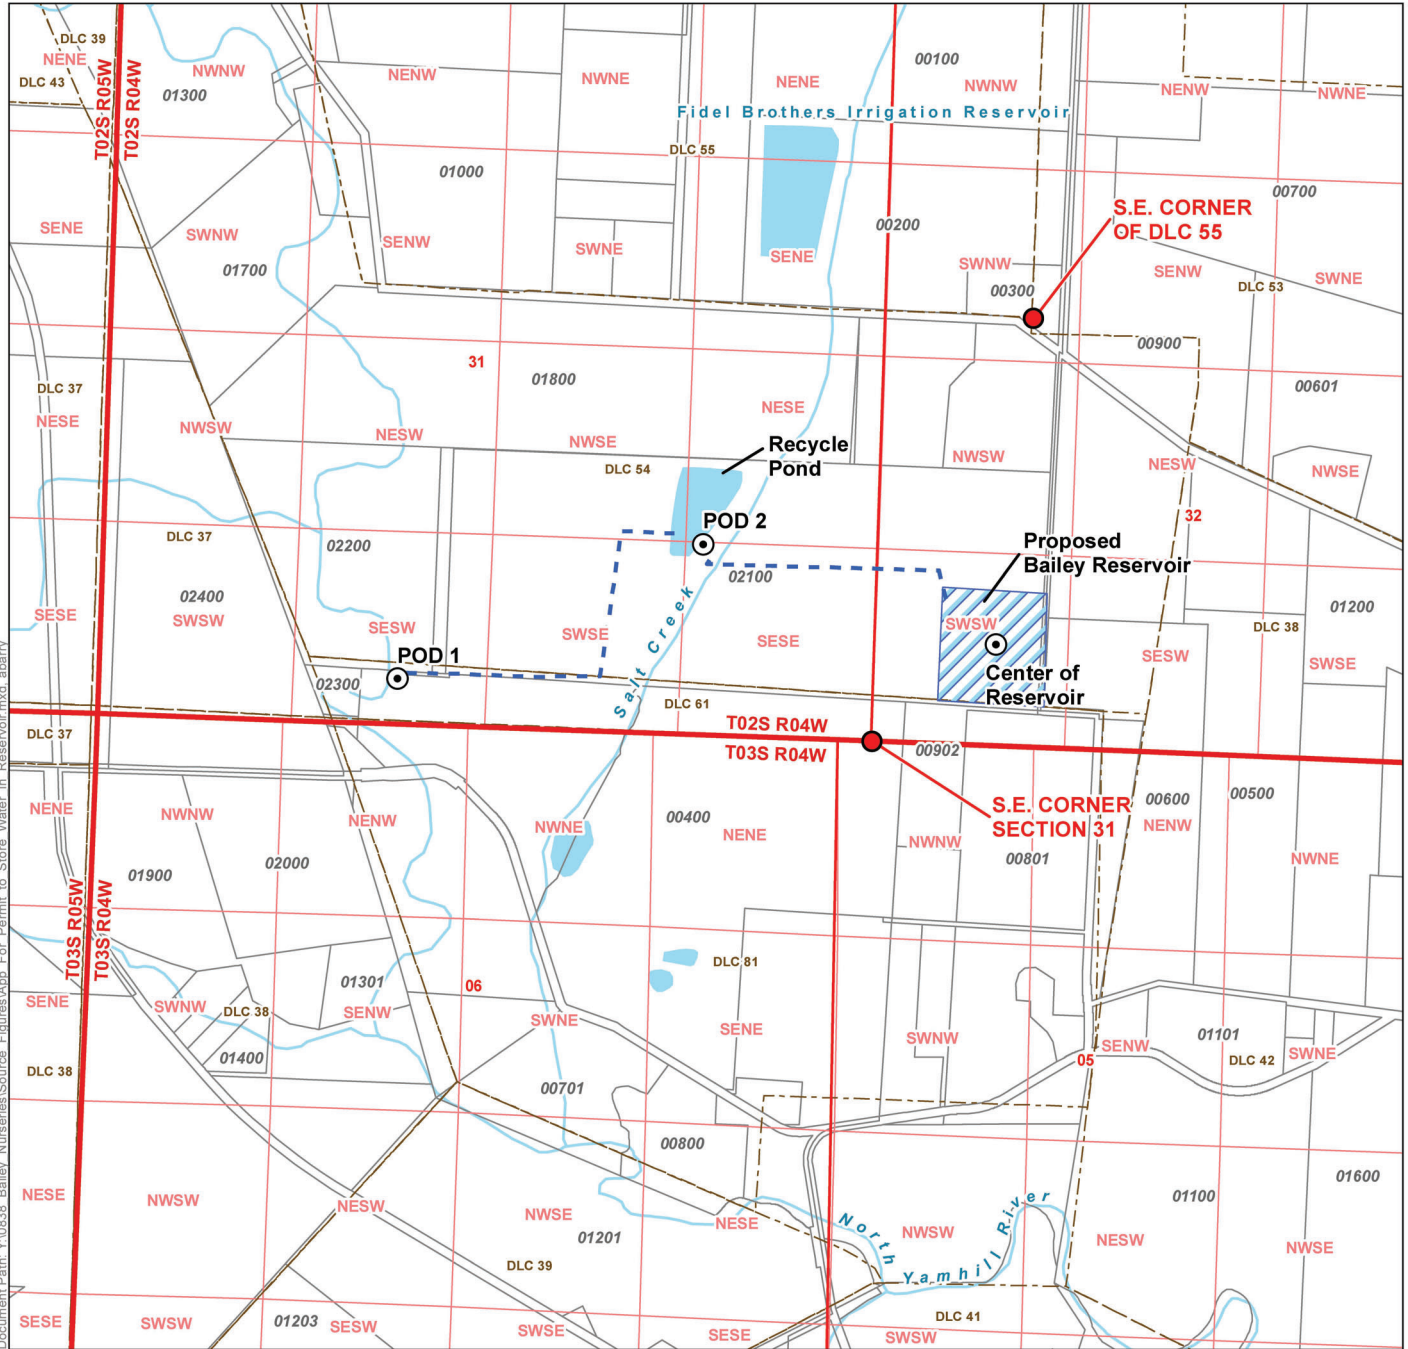


LEGEND

- Point of Diversion (POD)
- Proposed Bailey Reservoir
- Mainline
- Government Lot (GL)
- Donation Land Claim (DLC)
- Tax Lot
- Major Road
- Railroad
- Watercourse
- Waterbody

POD LOCATION DESCRIPTION

POD 1: Located 2,180 feet South and 4,280 feet West from the SE corner of DLC 55, Township 2 South, Range 4 West (W.M.)
POD 2: Located 1,305 feet North and 1,195 feet West from the SE corner of Section 31, Township 2 South, Range 4 West (W.M.)
Center of Reservoir: Located 700 feet North and 830 feet East from the SE corner of Section 31, Township 2 South, Range 4 West (W.M.)

Certified Water Rights Examiner Stamp

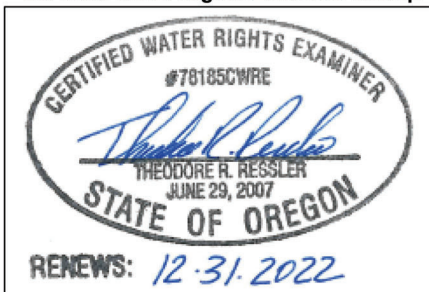

DISCLAIMER

This map was prepared for the purpose of identifying the location of a water right only and it is not intended to provide legal dimensions or location of property ownership lines.

MAP NOTES

Date: January 12, 2021
 Data Sources: BLM, Yamhill Co.

0 660 1,320

1 inch = 1,320 feet

RECORD OF SURVEY









LEGEND
 * MARKERS FOUND ADJACENT AS SHOWN
 * MARKERS SET 1/4" x 30" I.E. AS SHOWN

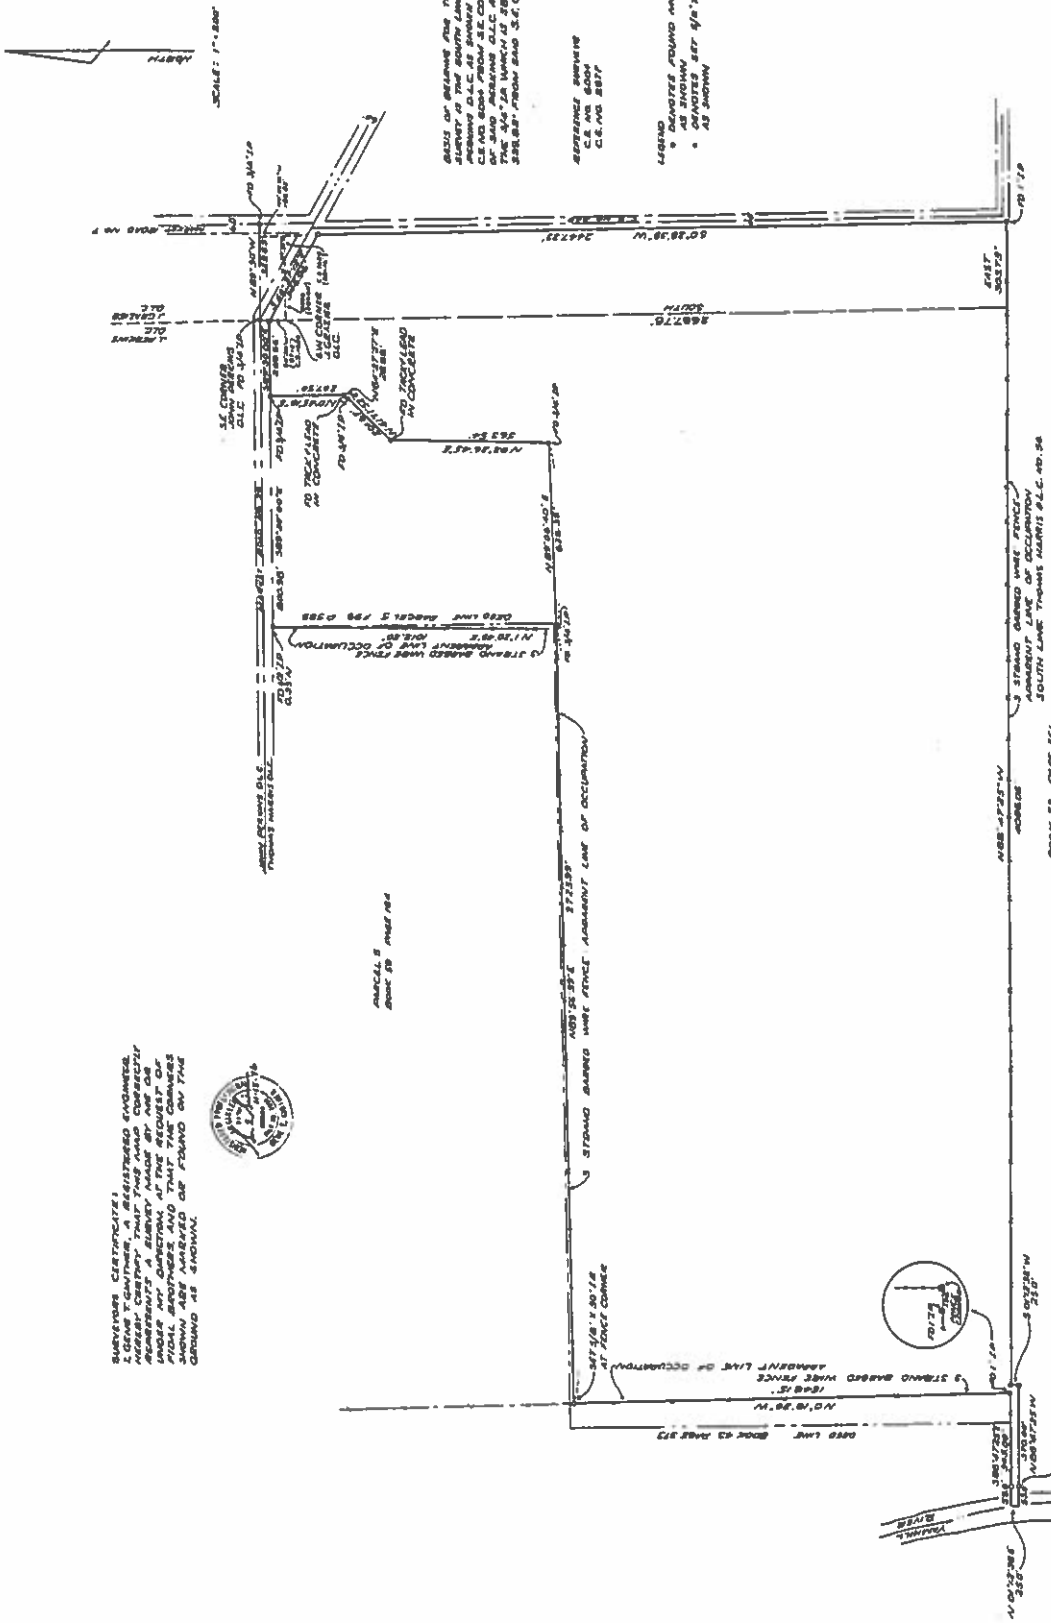

RECEIVED

DEC 21 2020

OWRD