


POLK COUNTY  
T. 65., R. 3 W., W. M.

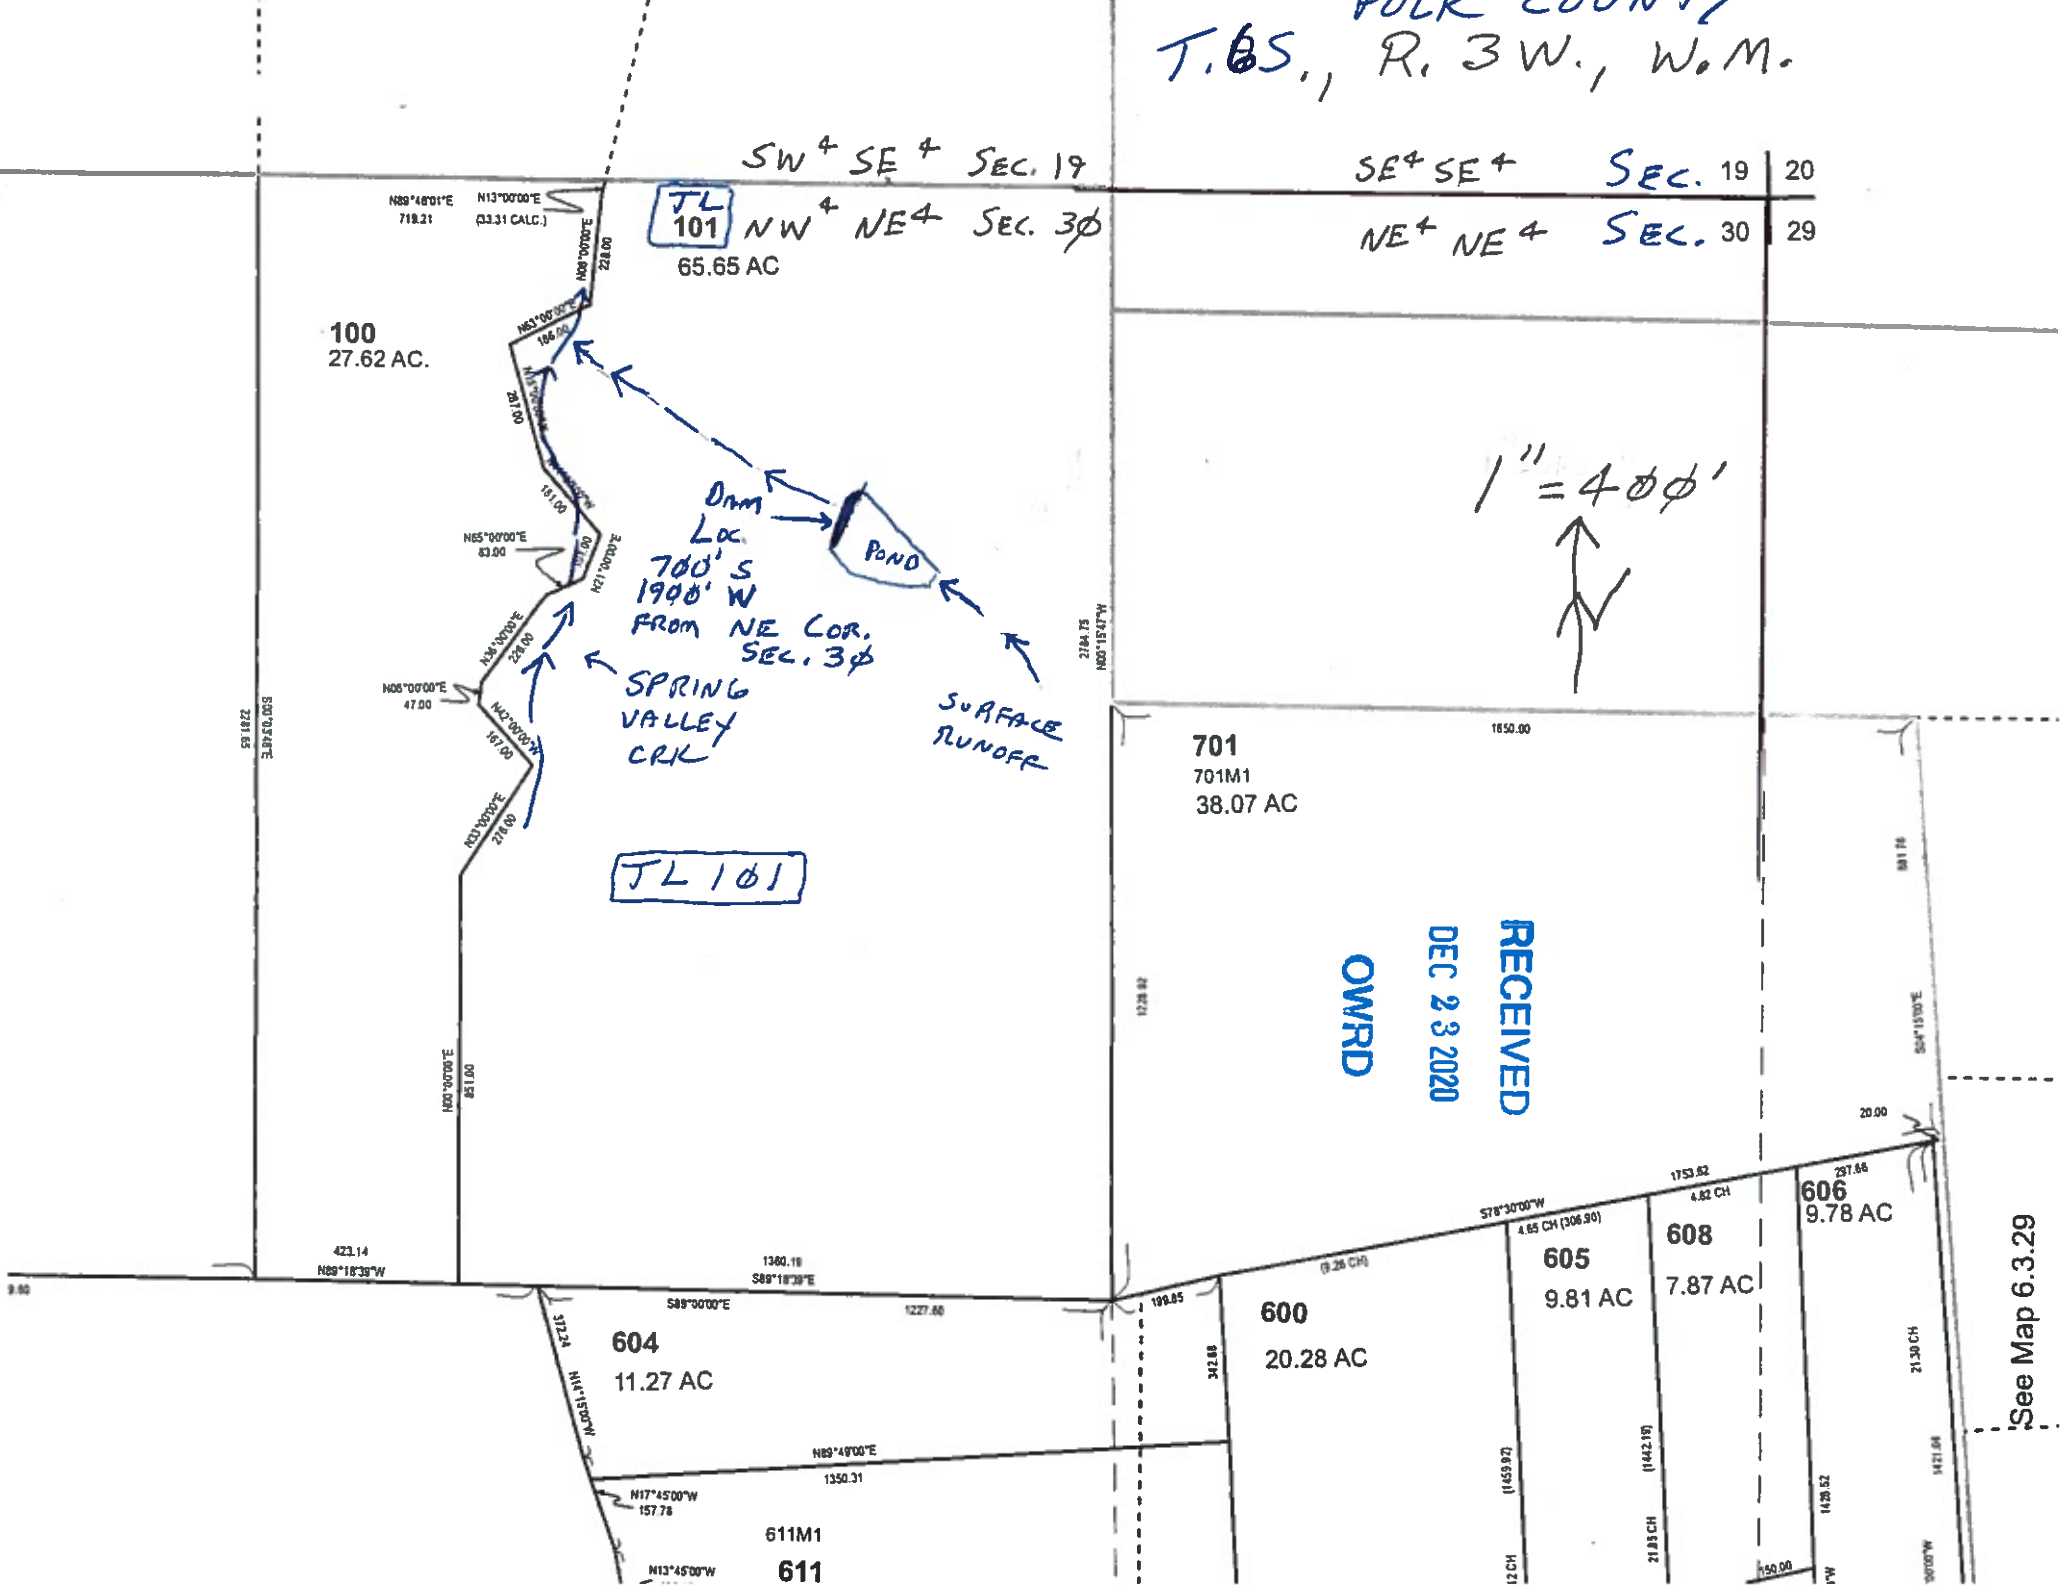

See Map 6.3.29