



Oregon Water Resources Department
 725 Summer Street NE, Suite A
 Salem, Oregon 97301
 (503) 986-0900
 www.wrd.state.or.us

Ownership Update For Certificated Rights Only

RECEIVED
 NOV 15 2019

NO FEES ARE REQUIRED TO SUBMIT THIS FORM

OWRD

NOTICE: A certificate of water right typically stays with the land. In order to track water right ownership, the Department requests that this form be submitted to the Department. To update multiple rights, a separate form is required for each right.

If you have any questions about this form, please contact your local watermaster, or call the Water Resources Department at (503) 986-0900.

This form is not for Applications, Permits, Transfers, Groundwater Registrations, or Limited Licenses. To notify the Department of changes in ownership to these types of authorizations, an Assignment is required.

Current Landowner Information

Name: Amber and Francisco Nieves
 Mailing Address: 46240 NW Hillside Rd
 City: Forest Grove State: OR Zip: 97116
 Phone (Home) (503) 201-1263 Work: (503) 605-0059 Other: (503) 888-6450

Property Description

County: Washington Township: 1N Range: 4W Section: 15
 Taxlot Number(s): 100

Street Address of water right property: 46240 NW Hillside Rd. Forest Grove OR 97116

Water Right Information: Application: S - 58193 Permit: S - 44144 Certificate #: 58707

Are all the lands associated with this water right owned by the requester? Yes No If No, include a map showing the portion of the right involved Tax lot 200 is POD

Name of individual completing this form: Amber Nieves Phone: (503) 201-1263

Signature of requestor: [Signature] Date: 11.12.2019

The Department does not change names on certificates. This form will be placed in the file for future reference only. The Department does not provide acknowledgement that this form has been received.


mailed 11.12.19
 agm

RECEIVED

NOV 15 2019

OWRD

T. 1N., R. 4W., W.M.

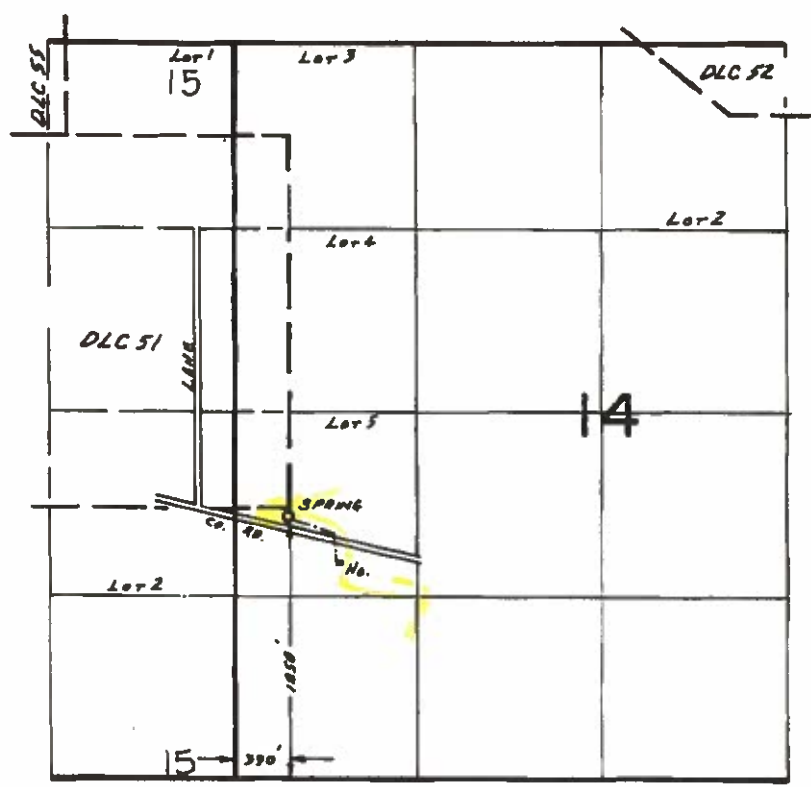

FINAL PROOF SURVEY UNDER

Application No. 58193..... Permit No. 44144.....
IN NAME OF

JAMES LARRY GIBSON.....

Surveyed JULY 17, 1980, by R.G. MUCKEN.....