



Oregon Water Resources Department
 725 Summer Street NE, Suite A
 Salem, Oregon 97301
 (503) 986-0900
 www.wrd.state.or.us

Ownership Update For Certificated Rights Only

RECEIVED
 SEP 08 2020
 OWRD

NO FEES ARE REQUIRED TO SUBMIT THIS FORM

NOTICE: A certificate of water right typically stays with the land. In order to track water right ownership, the Department requests that this form be submitted to the Department. **To update multiple rights, a separate form is required for each right.**

If you have any questions about this form, please contact your local watermaster, or call the Water Resources Department at (503) 986-0900.

This form is not for Applications, Permits, Transfers, Groundwater Registrations, or Limited Licenses. To notify the Department of changes in ownership to these types of authorizations, an Assignment is required.

Current Landowner Information

Name: Bruce W. Ernst
 Mailing Address: PO Box 460
 City: St Paul State: OR Zip: 97137
 Phone (Home): 503-510-4444 Work: 503-633-8366 Other: _____

Property Description

County: Marion Township: 4 South Range: 3 West Section: 13 + 24
 Taxlot Number(s): 043W240000100
 Street Address of water right property: 20503 Riverside Pr. NE St Paul OR 97137
 Water Right Information: Application: ___ - ___ Permit: ___ - 16866 Certificate #: 21159

Are all the lands associated with this water right owned by the requester? Yes No _____ If No, include a map showing the portion of the right involved.

Name of individual completing this form: Kim Stone Phone: 503-633-8366
 Signature of requestor: Bruce Ernst Date: 9/2/2020


The Department does not change names on certificates. This form will be placed in the file for future reference only. The Department does not provide acknowledgement that this form has been received.

RECEIVED


SEP 08 2020

OWRD

T. 4 S. R. 3 W. W. M.

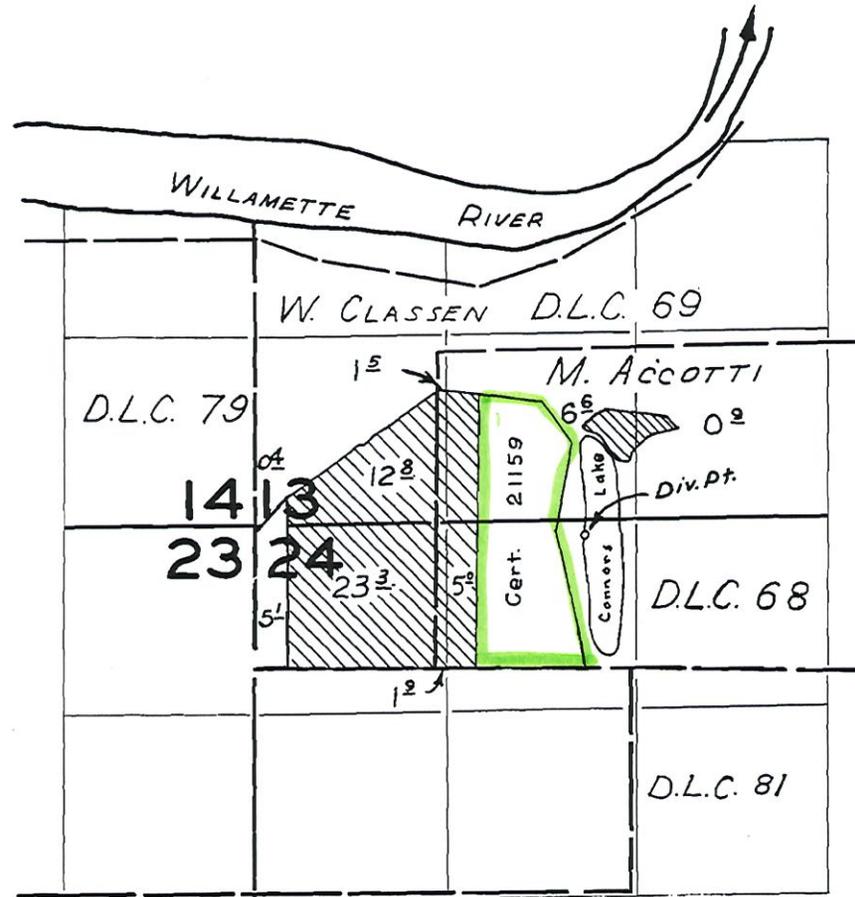

T. 4 S., R. 3 W., W.M.

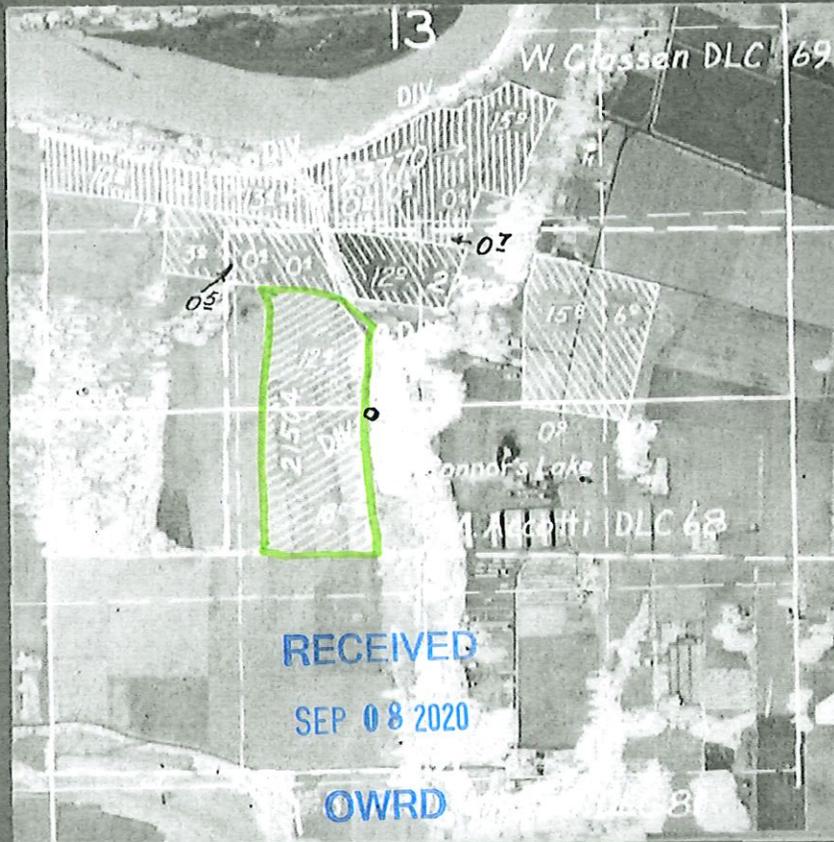

FINAL PROOF SURVEY


UNDER

Application No. 23770..... Permit No. 18757.....
27020 21265
21504 16866

IN NAME OF

G. P. & John S. Connor
A. B. Connor
Elmer Ernst

Surveyed April 14 1954, by H. L. Goffman..

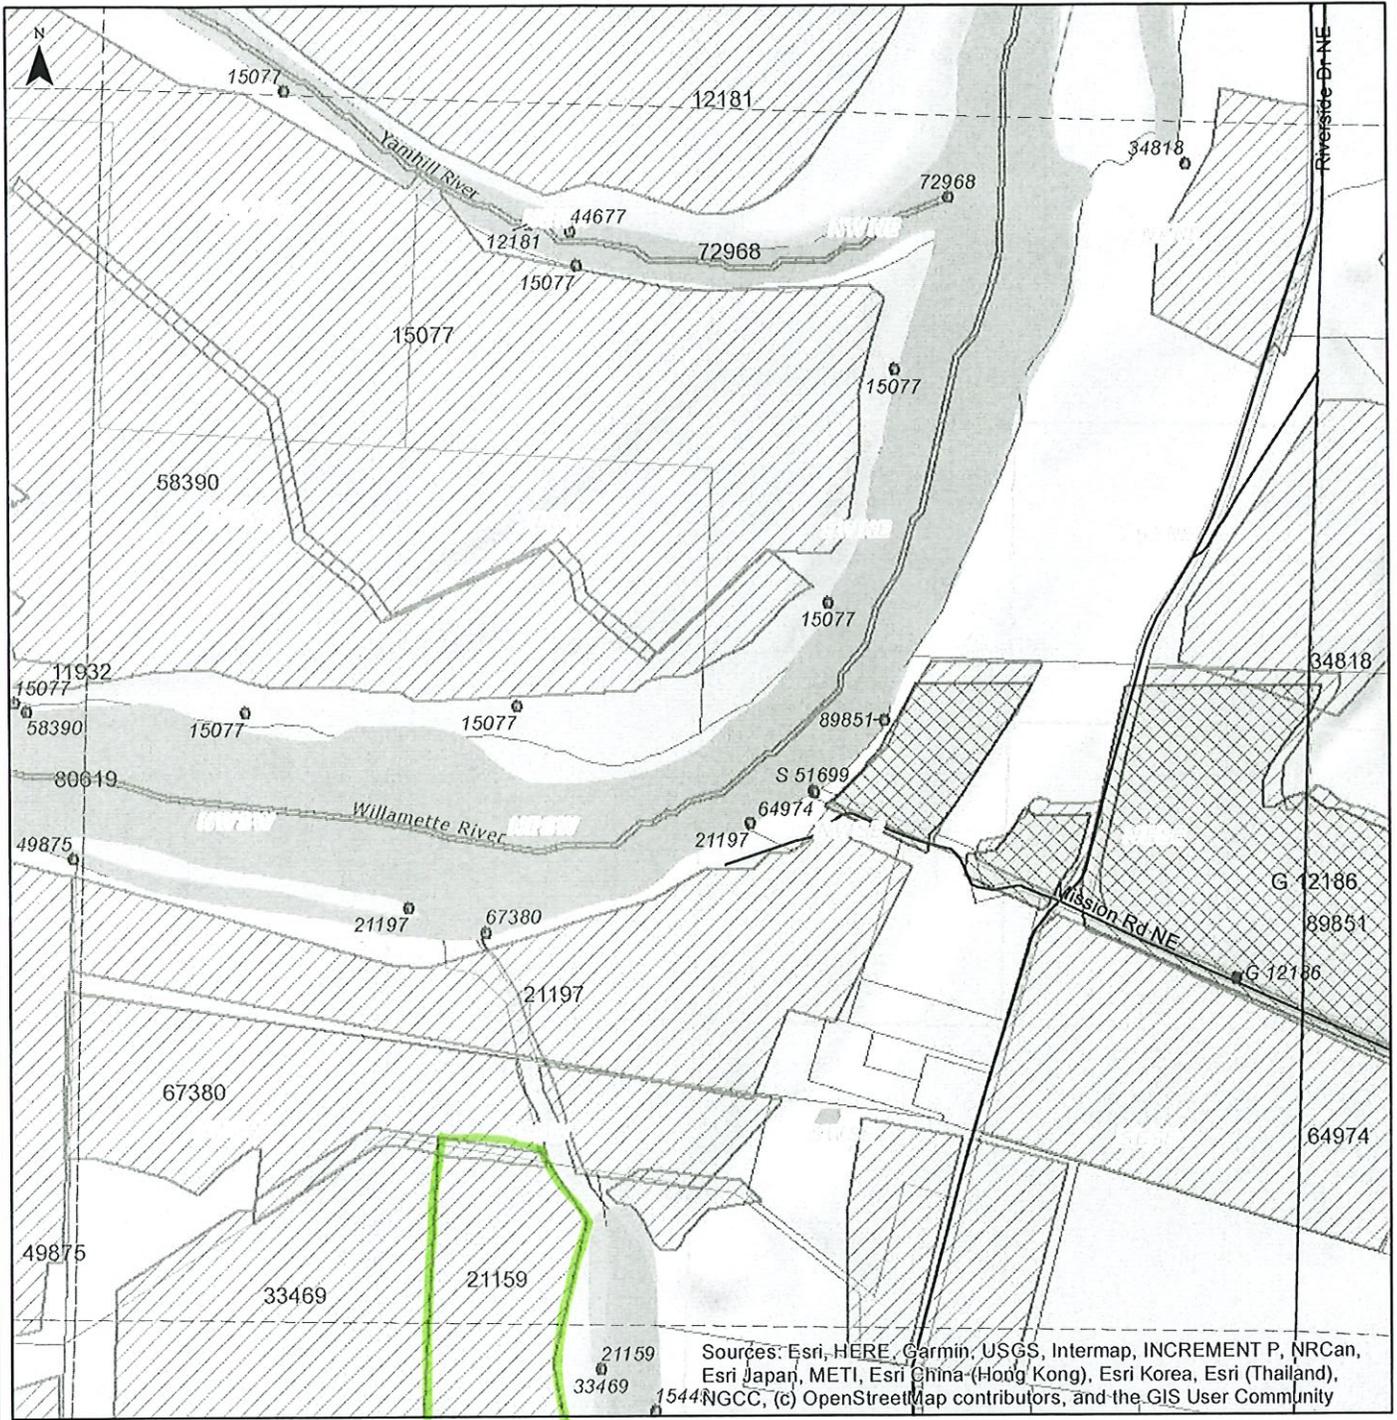

Sources: Esri, HERE, Garmin, USGS, Intermap, INCREMENT P, NRCan, Esri Japan, METI, Esri China (Hong Kong), Esri Korea, Esri (Thailand), NGCC, (c) OpenStreetMap contributors, and the GIS User Community



Legend

Points of Diversion Places of Use


◇ Water Rights - Outline to be determined. (Applies to all colors)


Water right labels indicate certificate number or permit letter(s) and number. Municipal uses excluded.

For more information:
<http://www.wrd.state.or.us> and
<http://apps.wrd.state.or.us/apps/wri/wriinfo/>

This map is for informational purposes only. It is not intended for legal, engineering or surveying purposes. Municipal rights are not included on this map.

Index Map



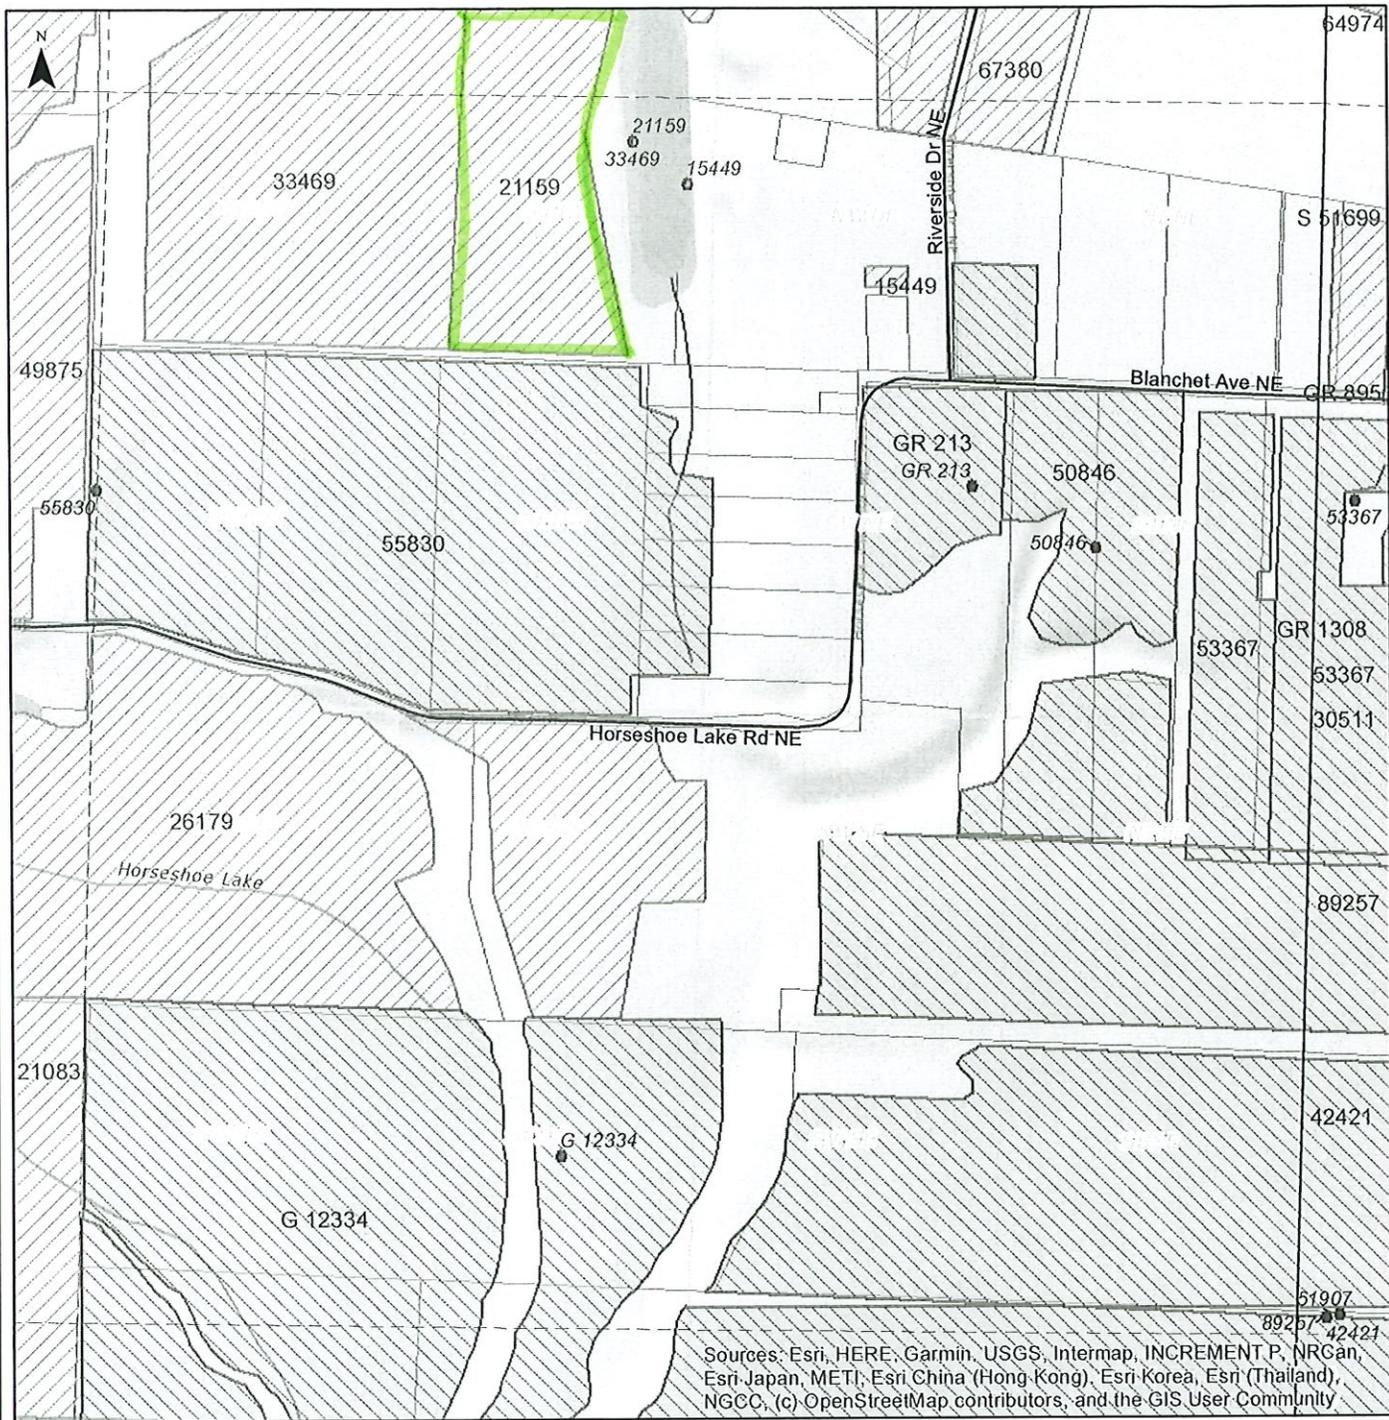

Sources: Esri, HERE, Garmin, USGS, Intermap, INCREMENT P, NRCan, Esri Japan, METI, Esri China (Hong Kong), Esri Korea, Esri (Thailand), NGCC, (c) OpenStreetMap contributors, and the GIS User Community

0 1,000 Feet

For more information:
<http://www.wrd.state.or.us> and
<http://apps.wrd.state.or.us/apps/wr/wrinfo/>

This map is for informational purposes only. It is not intended for legal, engineering or surveying purposes. Municipal rights are not included on this map.

Points of Diversion Places of Use



Legend

◇ Water Rights - Outline to be determined. (Applies to all colors)

Water right labels indicate certificate number or permit letter(s) and number. Municipal uses excluded.

Index Map

