


18

19

20

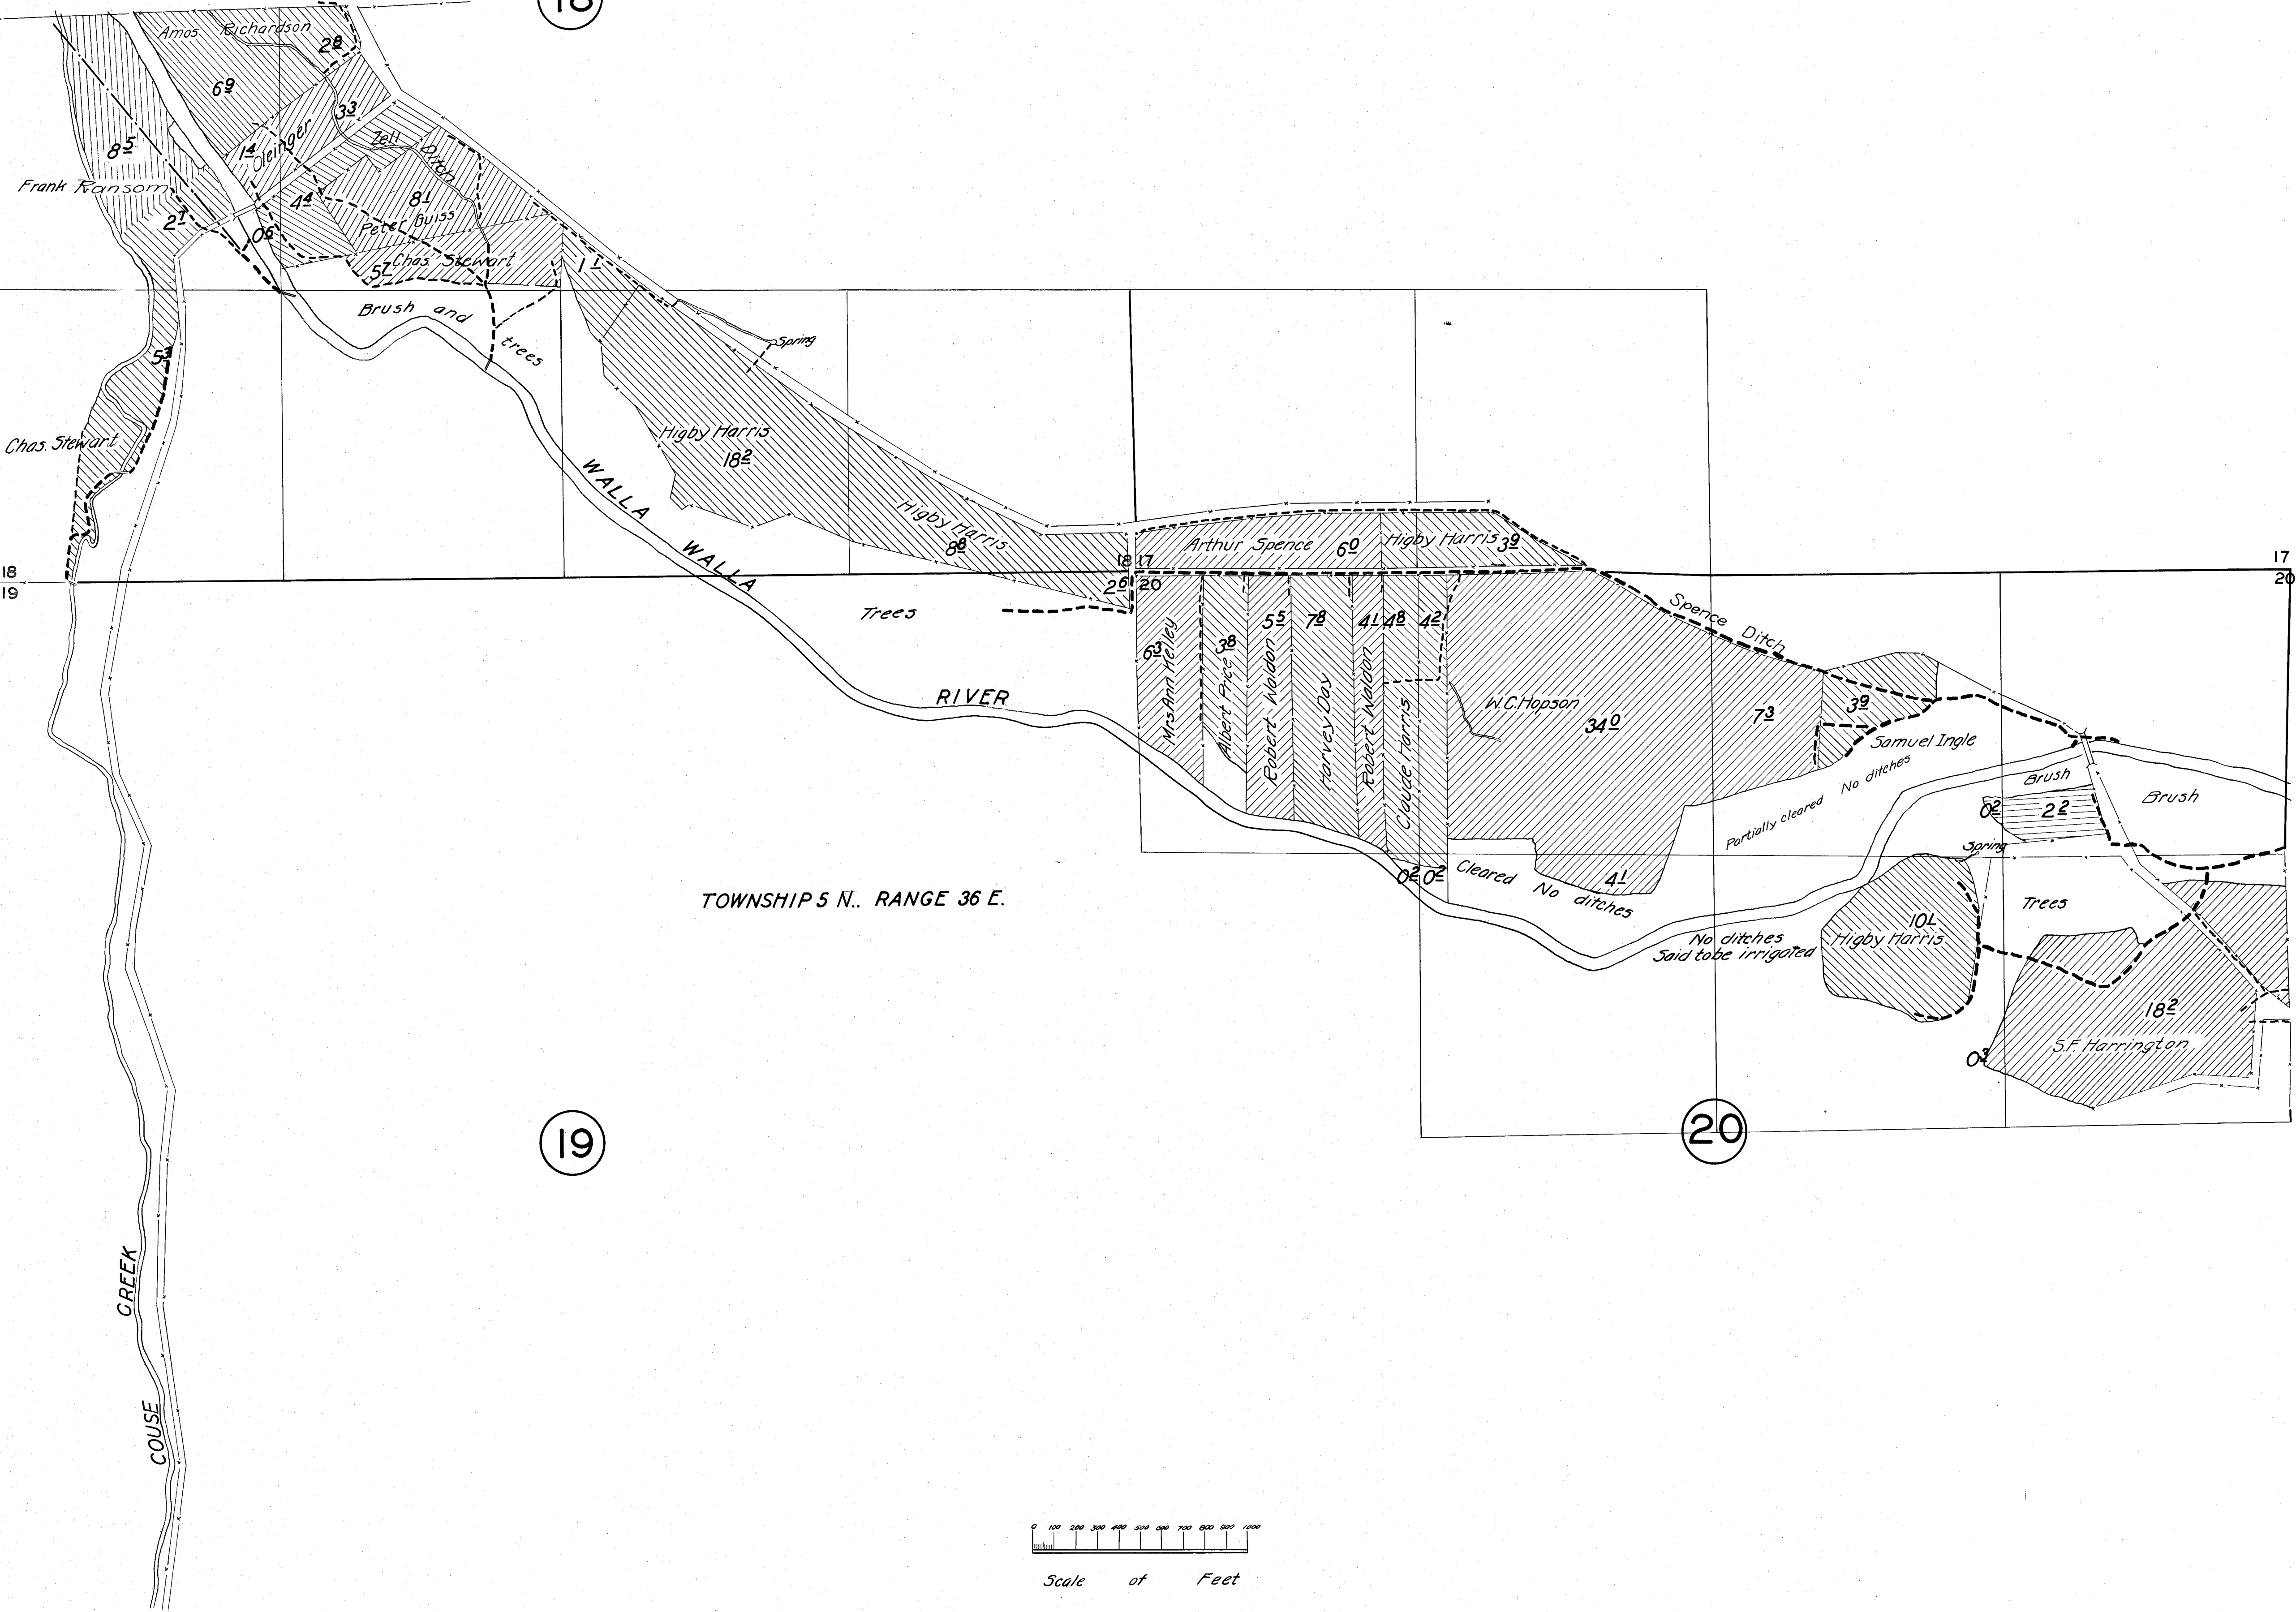

TOWNSHIP 5 N., RANGE 36 E.

