


Map Based Acreage Report

10/27/2020

Page 3 of 30

Gressley Farms LLC - Policy #: 763139

Map Page# 1	Layout: PLSS
007-018S-046E	355.2 Cropland Acres

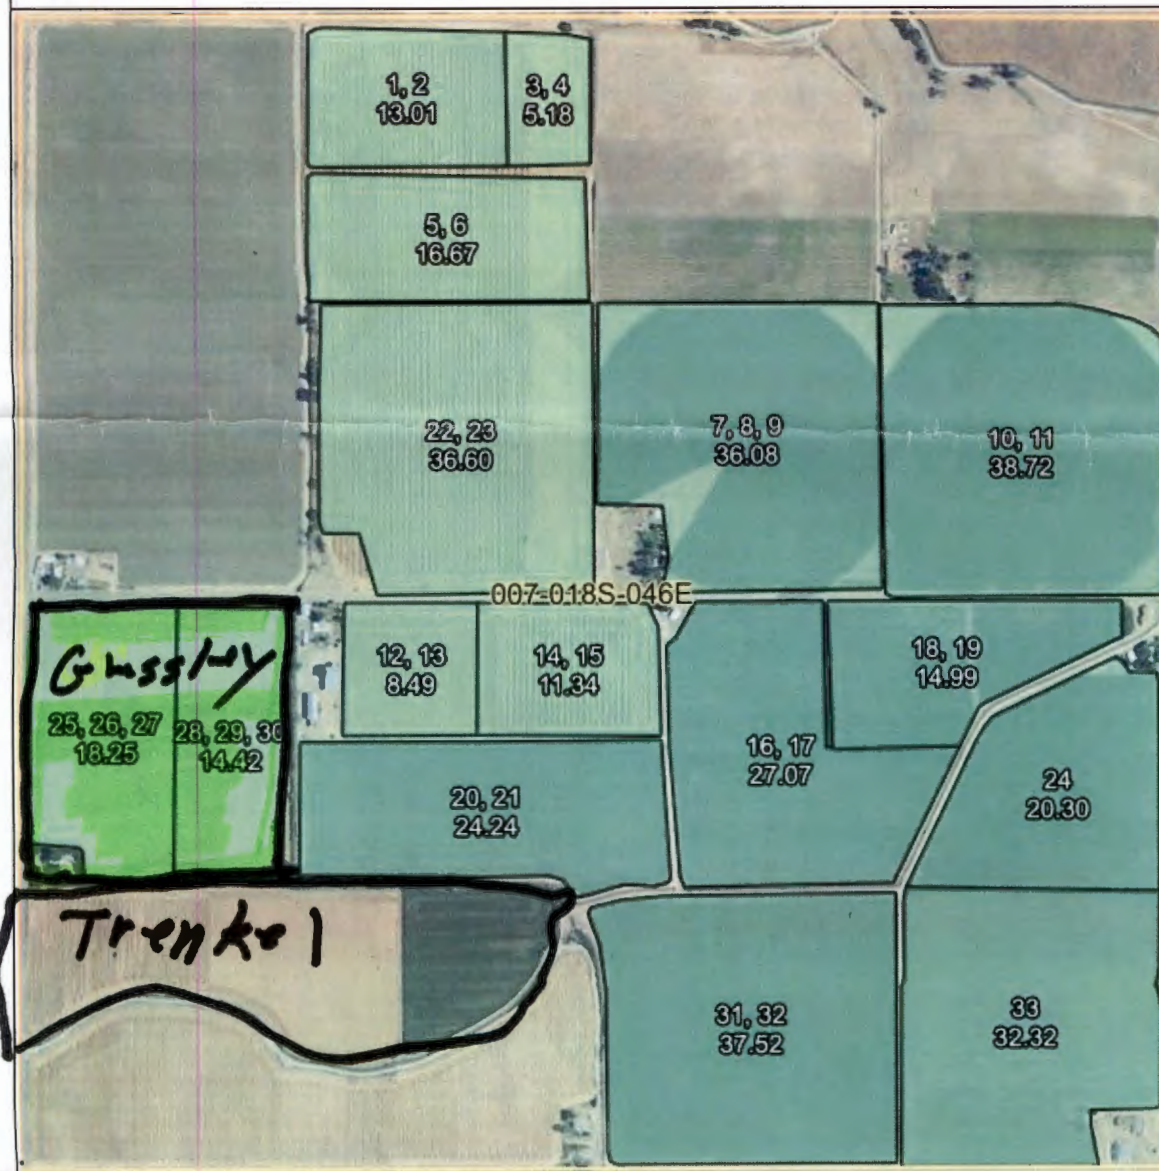

County(s)	OR-Malheur
Unit Numbers	none

RECEIVED
 JAN 25 2021
 OWRD

