


Groundwater Application - L3 Farms, Inc.

REVISED 11/16/2021

E-RECEIVED
November 17, 2021
OWRD

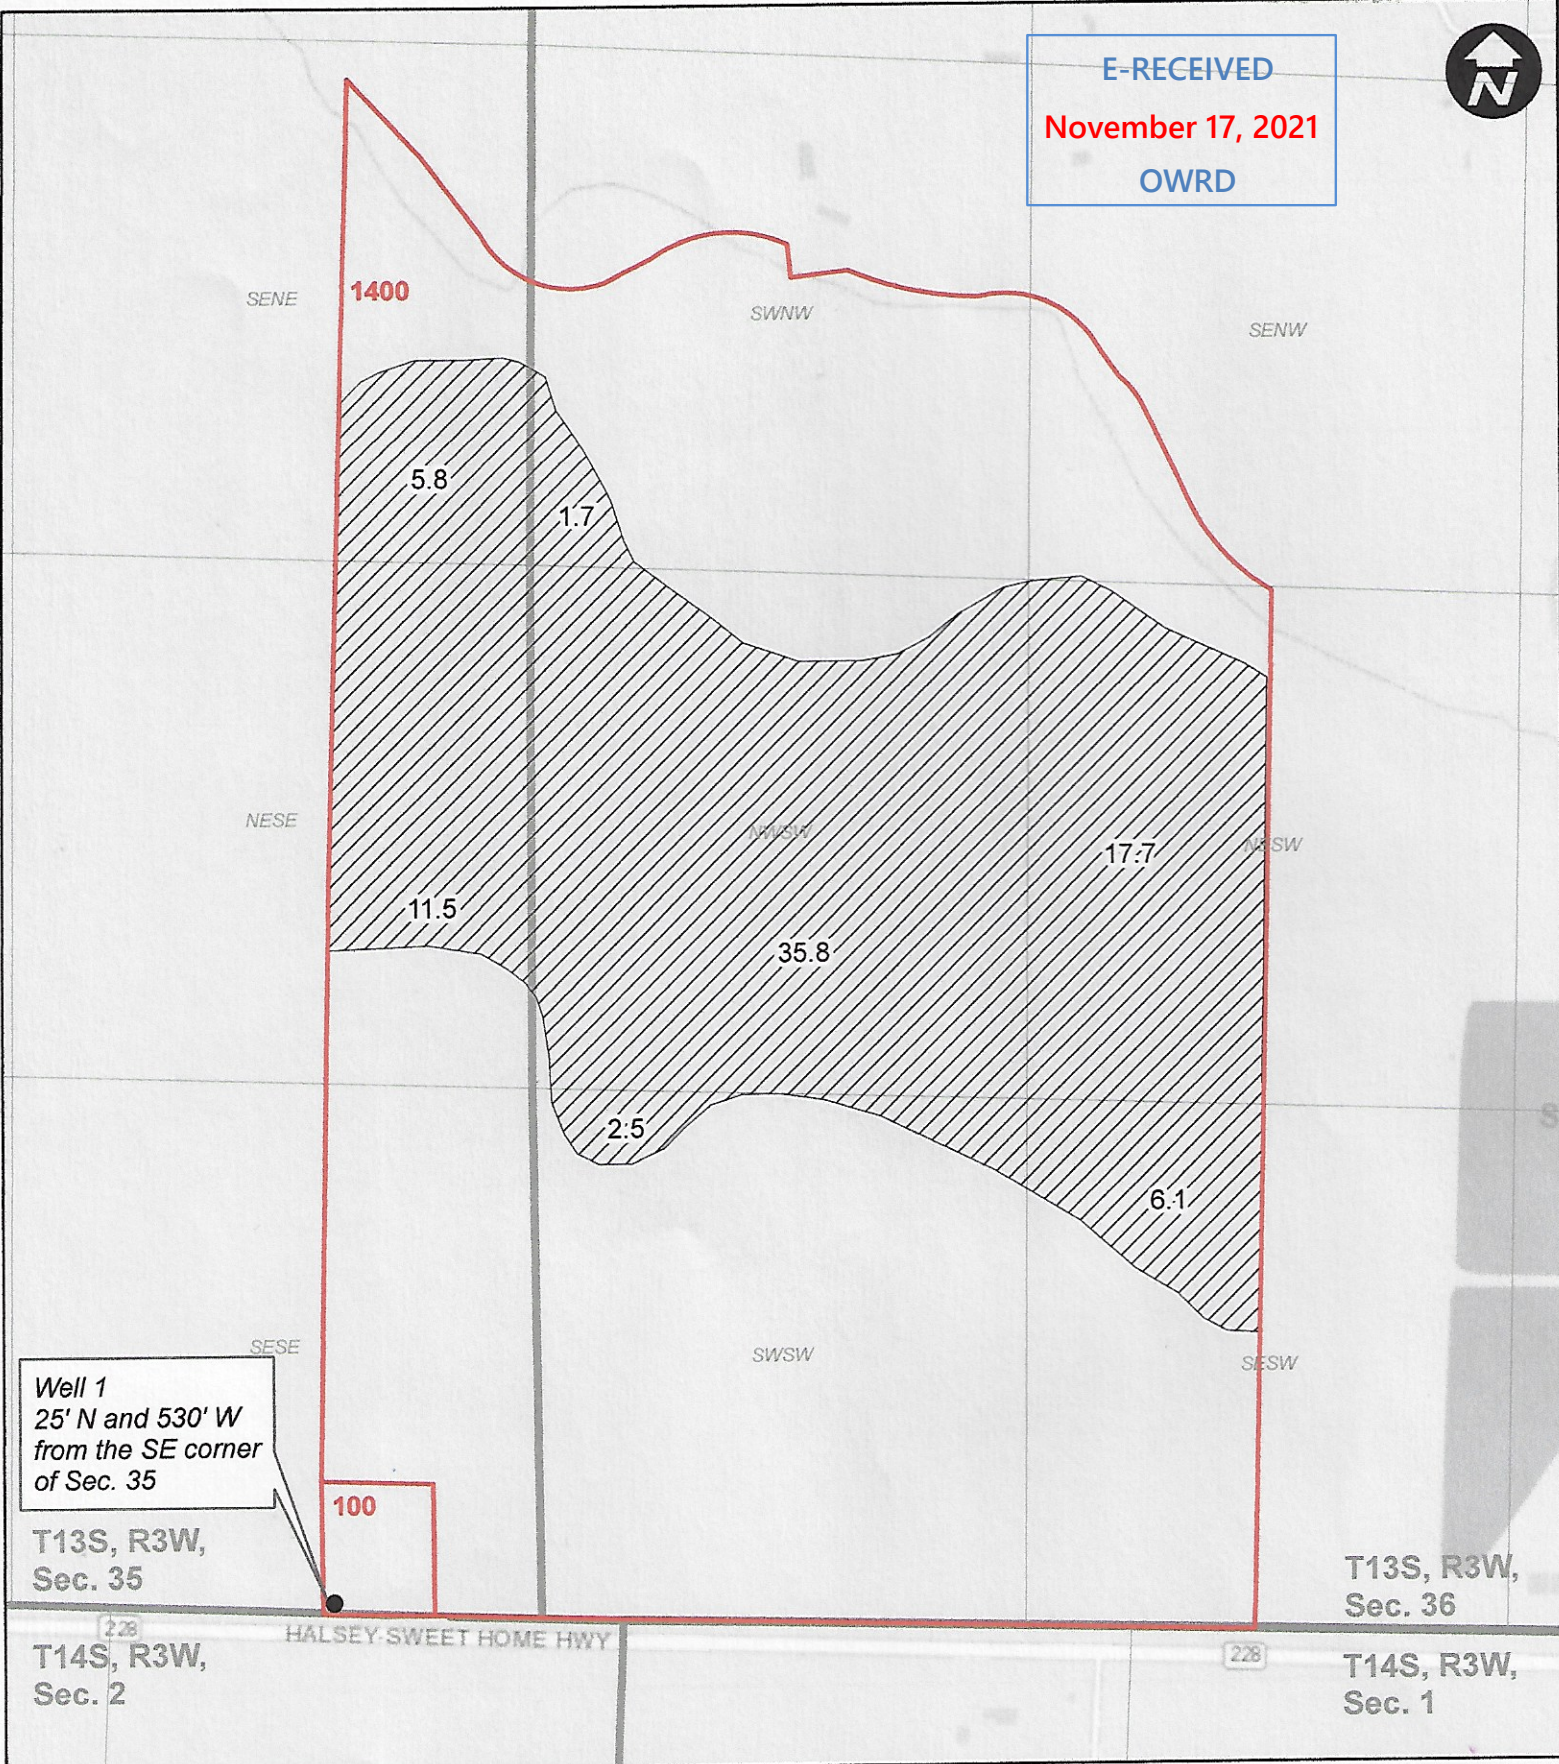

Legend

- Proposed POU (81.1 ac.)
- Taxlots