


Township 1 S, Range 23 E.

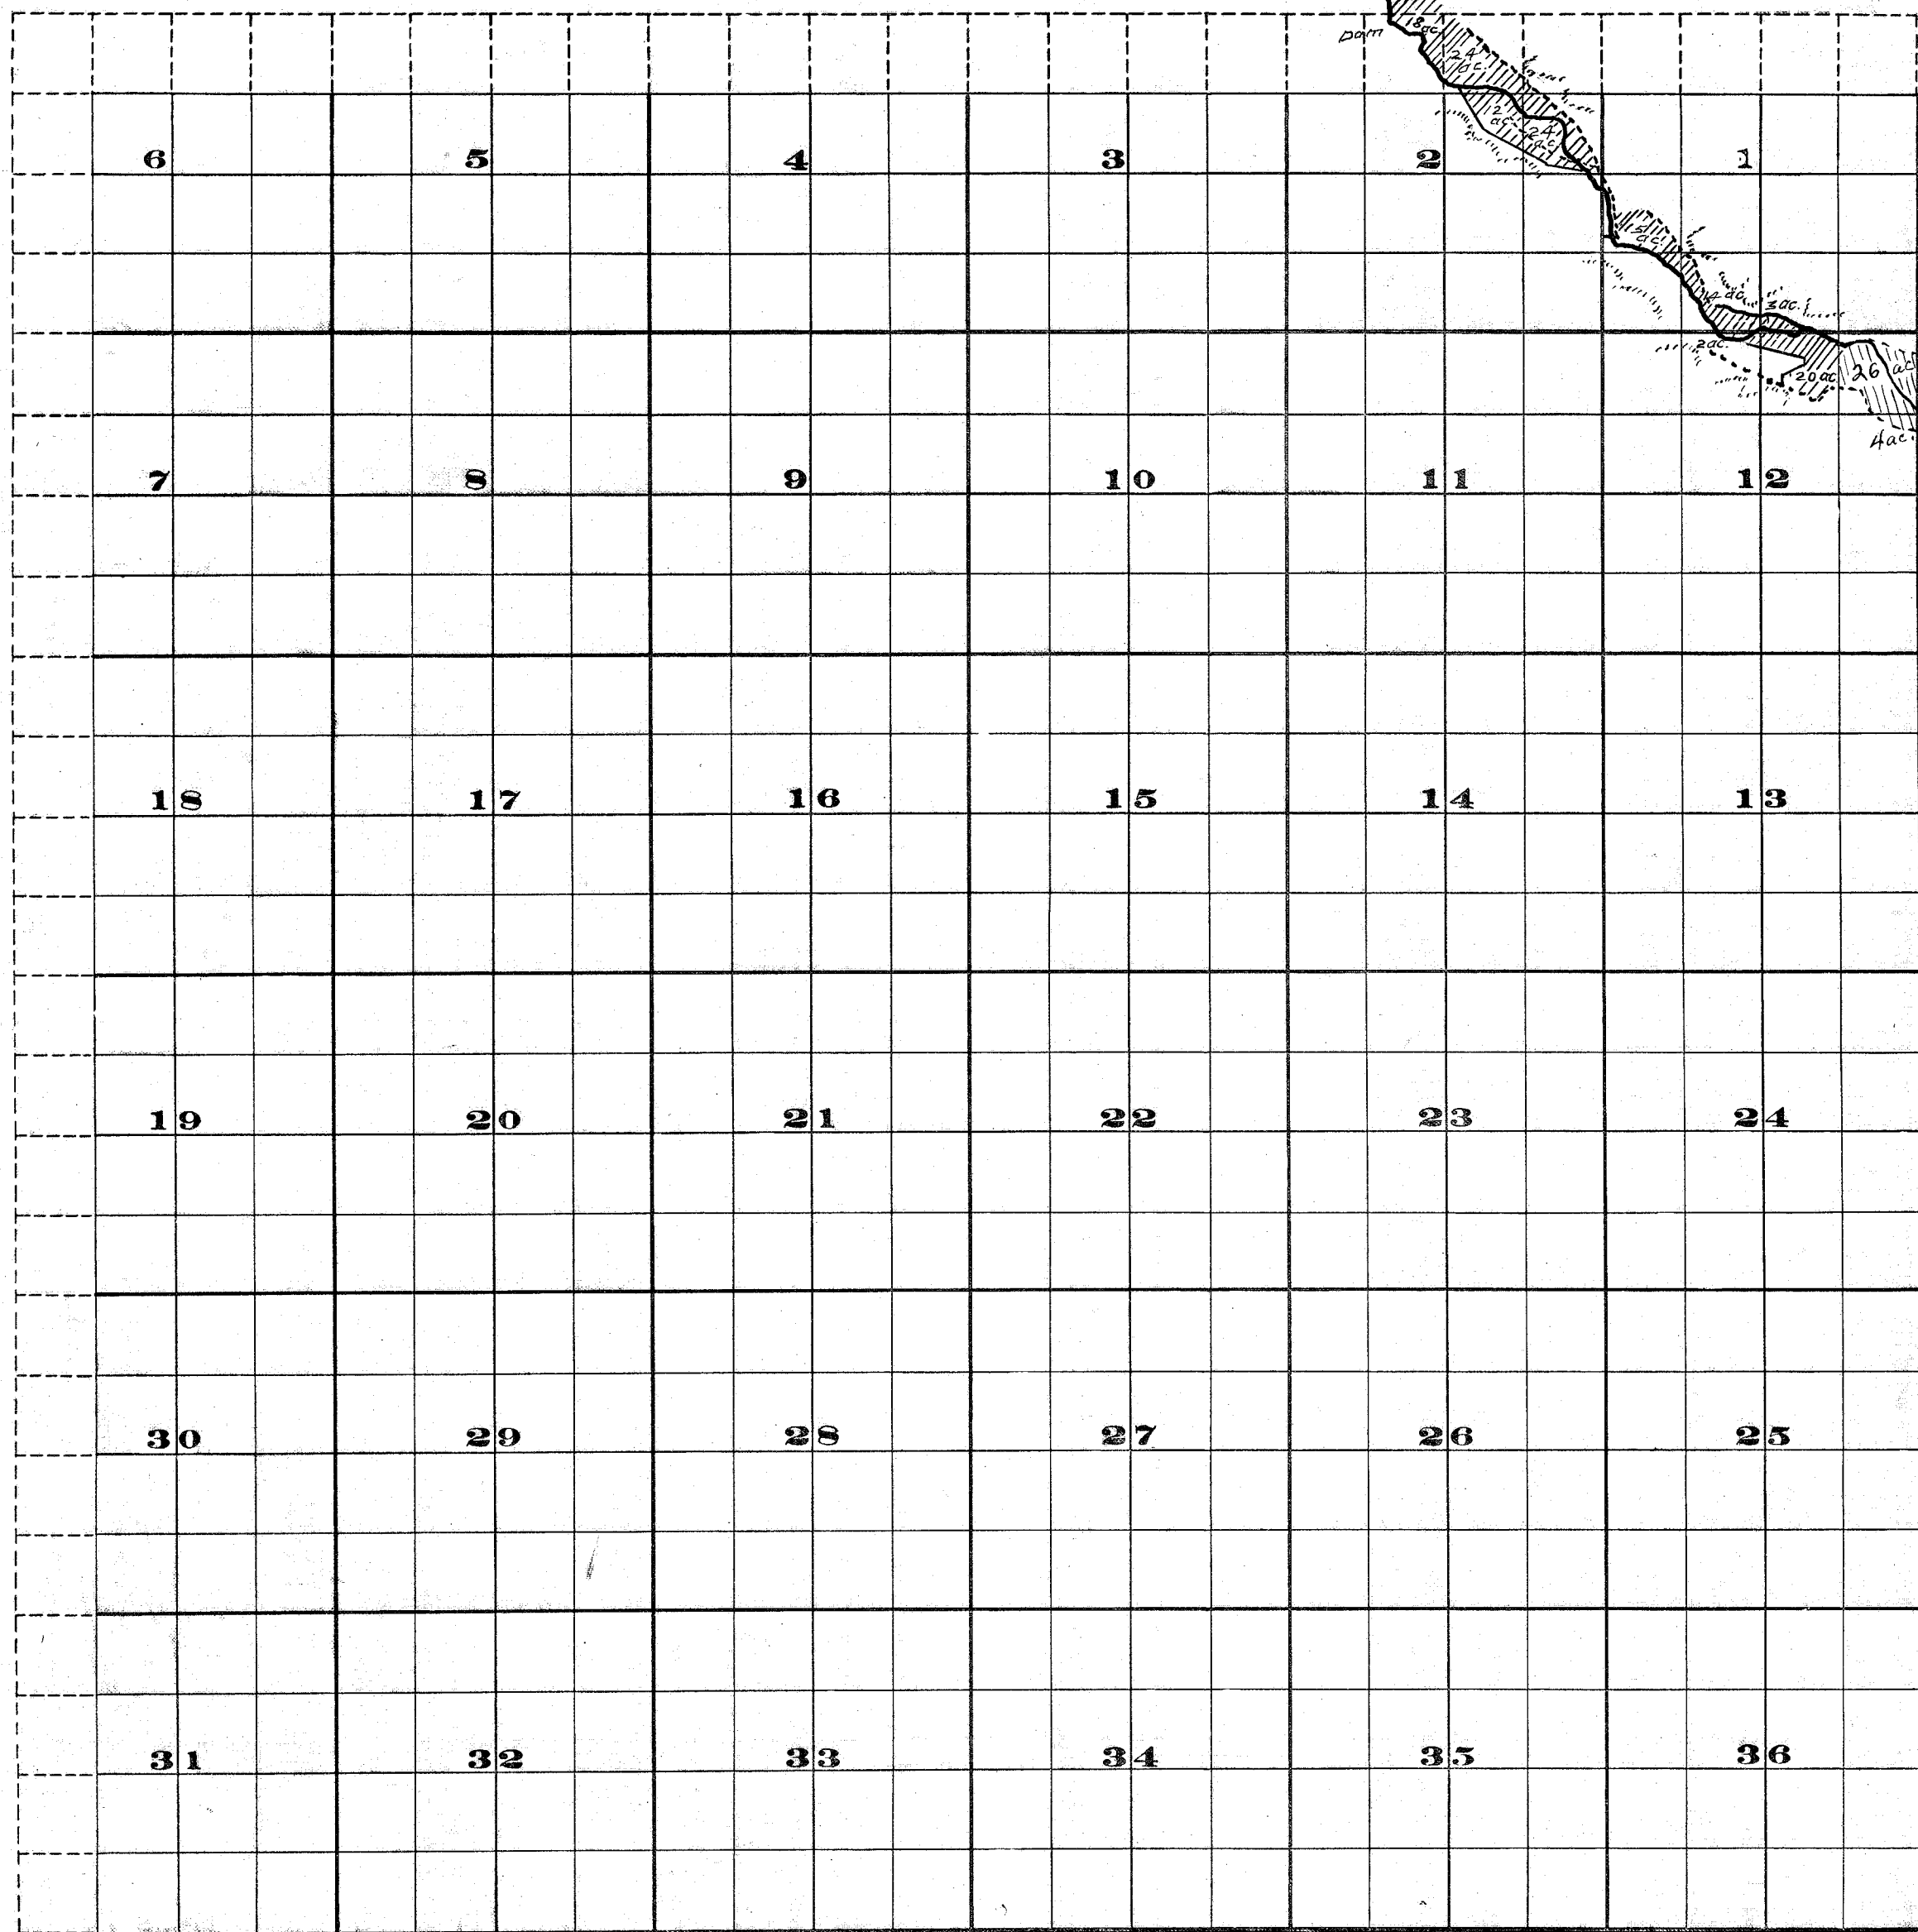

THE S.A. BRISTOL CO., PRINTERS & BOOKBINDERS, CHEYENNE, WYO

FROM OFFICE OF THE STATE ENGINEER, SALEM, OREGON

Surveyed by R.D. Cooper, July 1909
John H. Lewis State Engineer

Willow Creek Adjudication.

Examined July 14, 1909