


RECEIVED

OCT 01 1998

WATER RESOURCES DEPT.
SALEM, OREGON

Section 3 T.35, R.3E, W.M.

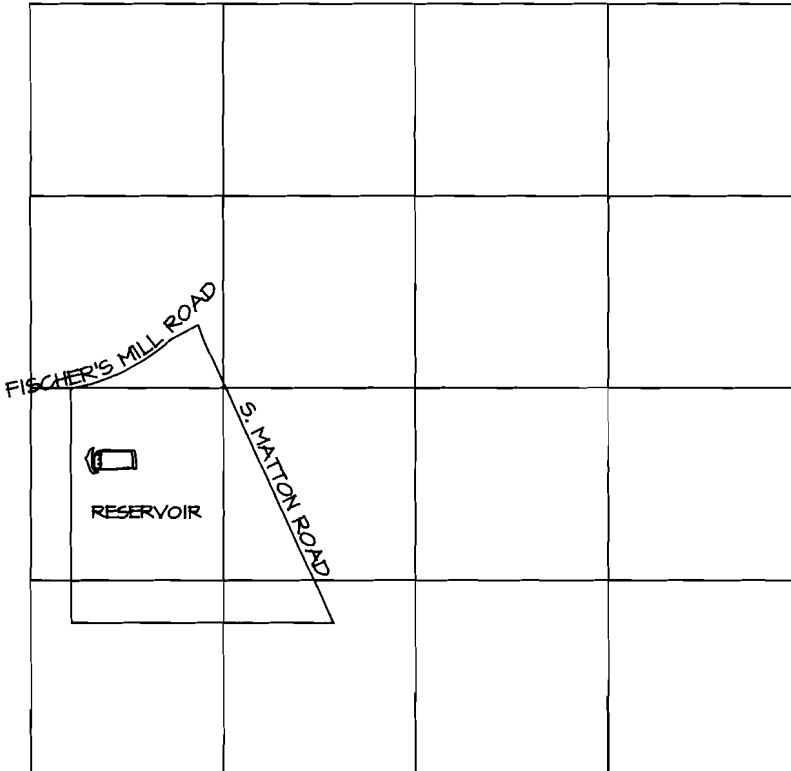

SCALE 1" = 1320'

THE RESERVOIR IS 2,162 FEET NORTH AND 428 FEET EAST
OF THE S.W. CORNER OF SECTION 3.

BENEFICIAL USE MAP
FOR
ARLENE FISCHER

APPLIC. NO. R-73058 PERMIT NO. R-11510

THE PREPARATION OF THIS MAP IS FOR THE
PURPOSE OF IDENTIFYING THE LOCATION
OF THE WATER RIGHT ONLY AND HAS NO
INTENT TO PROVIDE DIMENSIONS OR LOCATION
OF PROPERTY OWNERSHIP LINES.

Jonathan S. Eymond