

SEE MAP 2N 13 31

PARCEL 100 & 400

1. 1/4 SECTION

1" = 660'

SEE MAP 2N 13 31C

Wasco Co.

Hood Basin

WATER RESOURCES DEPT
SALEM, OREGON

JUN 01 2007

RECEIVED

Well location
1433 feet west of S.E. Corner of section 11
175 feet North of S.E. Corner of section 11

SEE MAP IN 12 1


Revised
6/20/2006, 9C
2N 12 36

TAX Lot 4100 shaded
8.5 acres SW/SE
.9 acres SE/SW

RECEIVED

JUN 01 2007

WATER RESOURCES DEPT
SALEM, OREGON

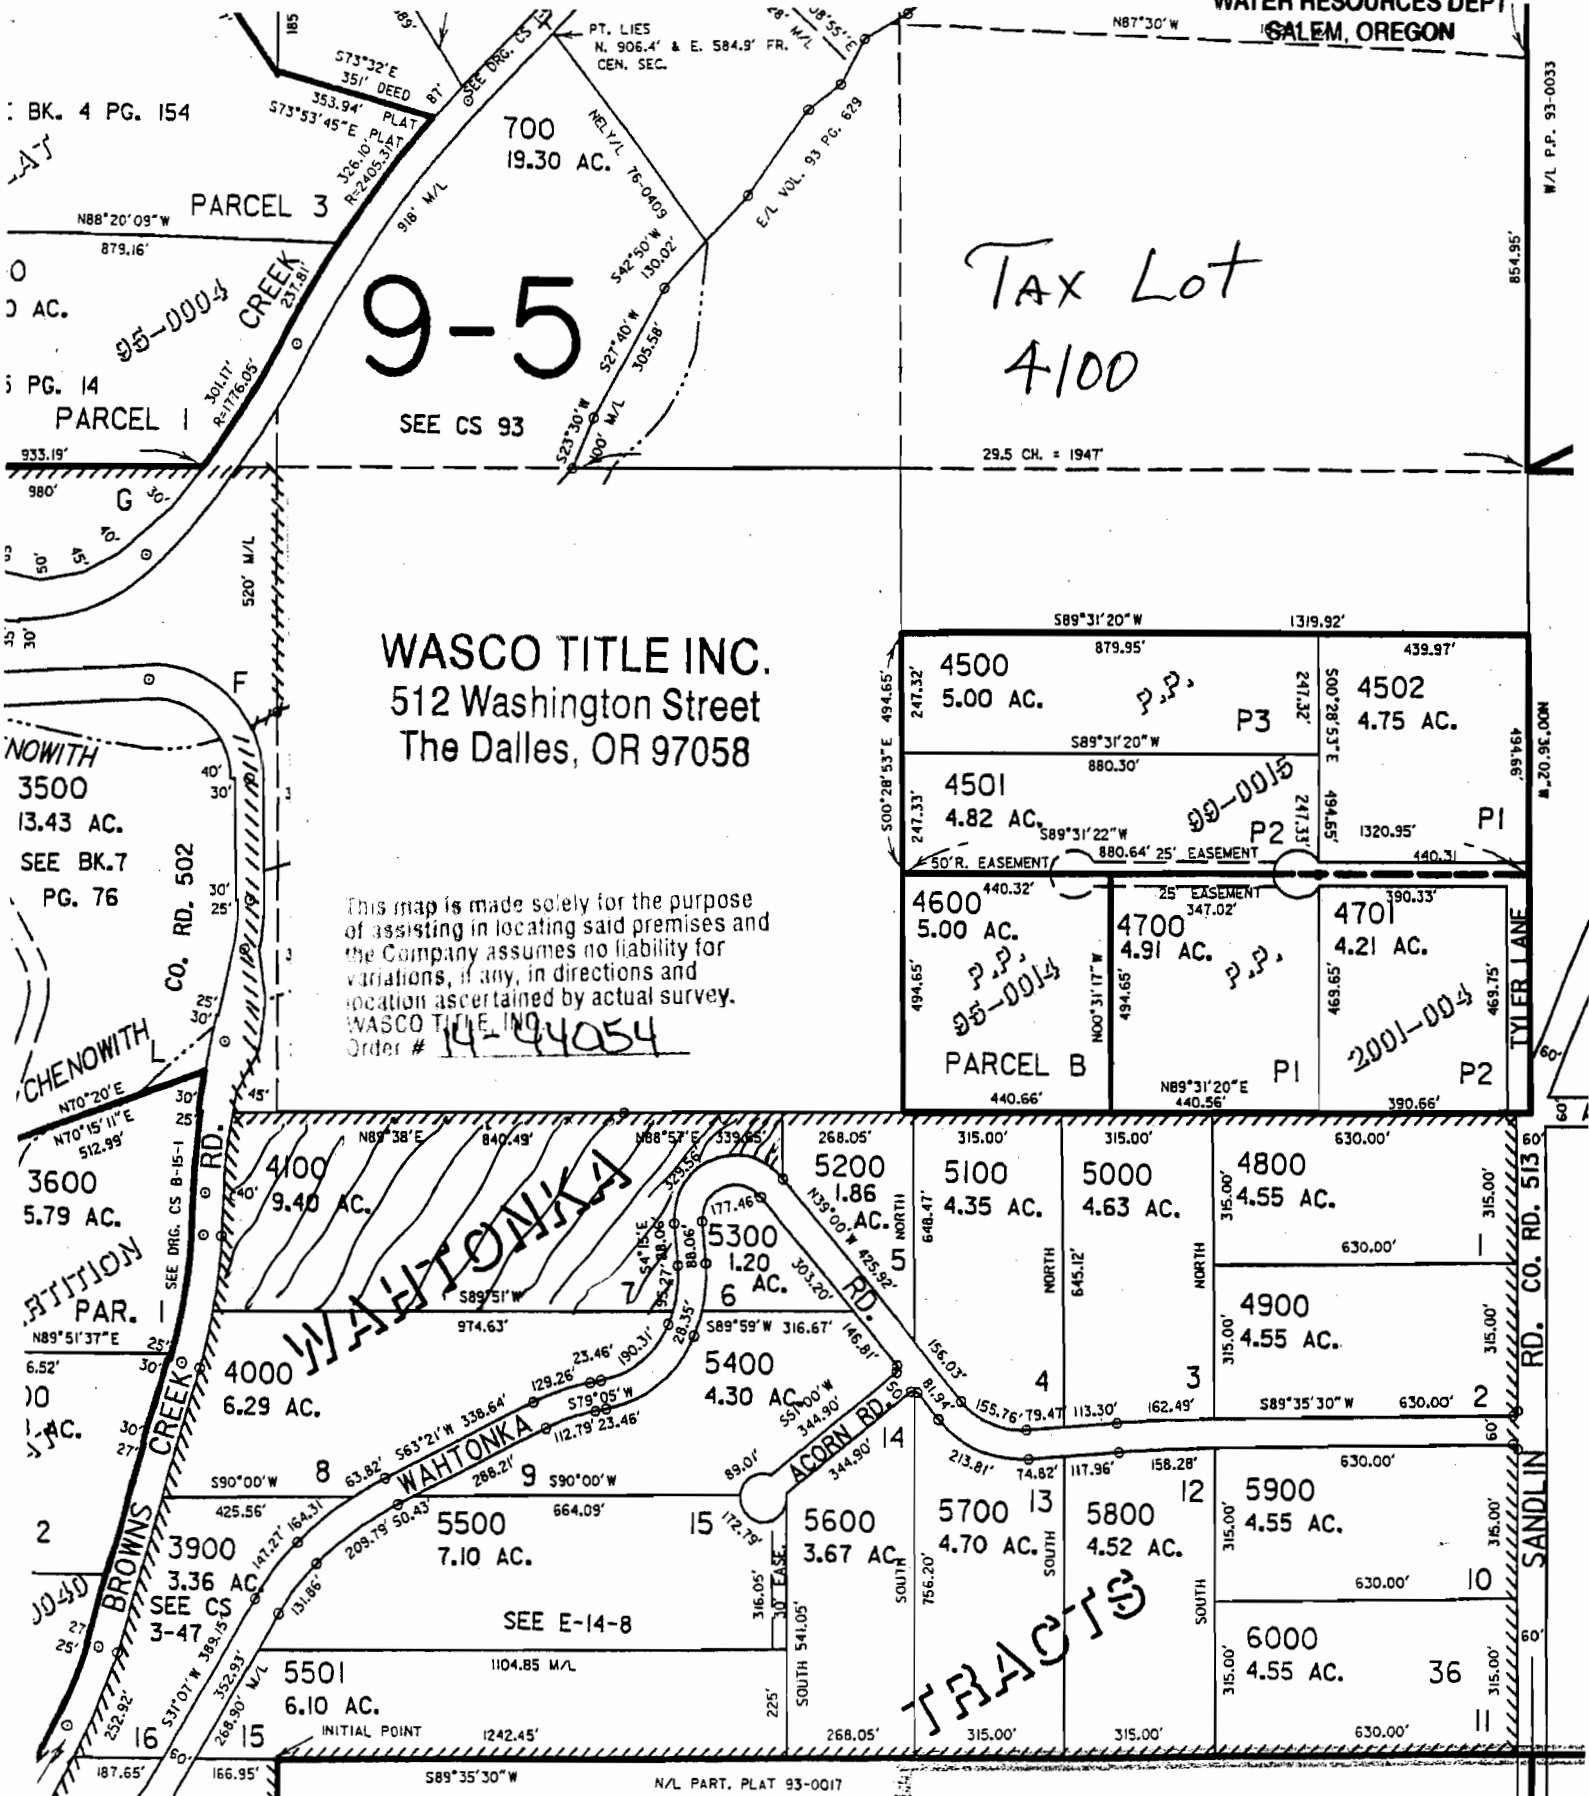

9-5

TAX Lot
4100

WASCO TITLE INC.
512 Washington Street
The Dalles, OR 97058

This map is made solely for the purpose
of assisting in locating said premises and
the Company assumes no liability for
variations, if any, in directions and
location ascertained by actual survey.
WASCO TITLE, INC.
Order # 14-94054

TRACTS

BK. 4 PG. 154

PG. 14

PG. 76

3500
13.43 AC.

3600
5.79 AC.

4000
6.29 AC.

3900
3.36 AC.

5501
6.10 AC.

700
19.30 AC.

4500
5.00 AC.

4501
4.82 AC.

4600
5.00 AC.

4700
4.91 AC.

5100
4.35 AC.

5000
4.63 AC.

5700
4.70 AC.

5800
4.52 AC.

5900
4.55 AC.

4800
4.55 AC.

4900
4.55 AC.

5900
4.55 AC.

6000
4.55 AC.

36

PARCEL 3

PARCEL 1

PARCEL B

PAR. 1

SEE E-14-8

P.P.

P.P.

P.P.


























