

RECEIVED


FEB 19 2021

OWRD

Groundwater Permit Application

Sunset Farm JC, LLC

Township 16 S. Range 5 W., W.M. NW NE, Section 1, TL 700

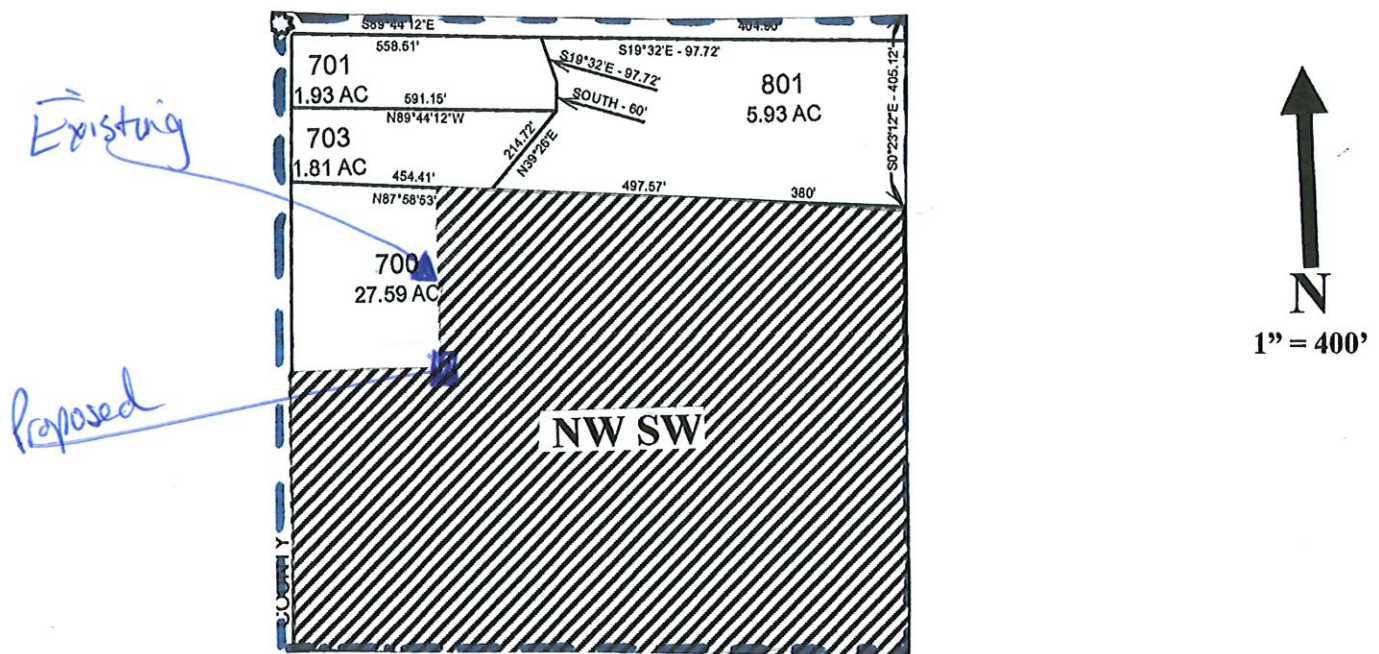

Irrigation Place of Use, 25 Acres

- △ Point of Appropriation: LANE 8397
260 Feet East and 520 Feet South, from the Reference Corner
- Point of Appropriation: PROPOSED
337 Feet East and 704 Feet South, from the Reference Corner
- ⊛ Reference Corner: Center ¼ Corner of Section 1, T.16 S., R. 5 W.