

Application to Store Water - Reservoir

Sunset Farm JC, LLC


Township 16 S. Range 5 W., W.M. NW NE, Section 1, TL 700

RECEIVED

FEB 19 2021

OWRD

Existing
Pond
location

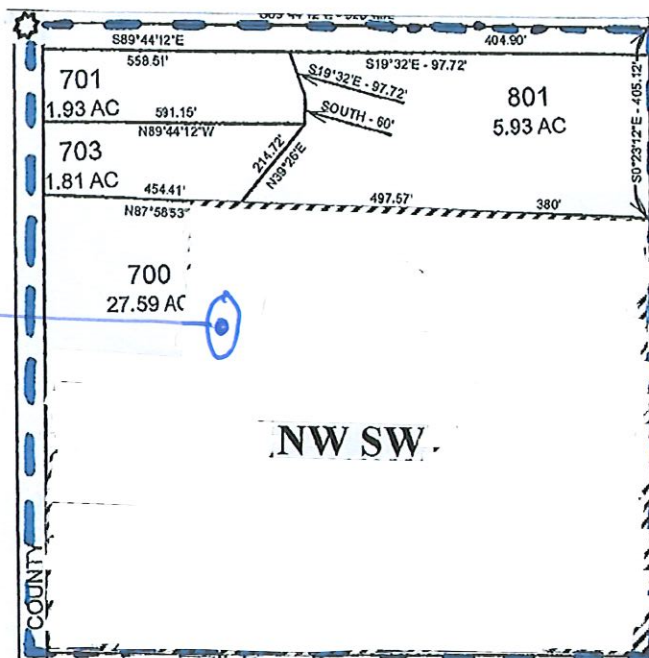

N
1" = 400'

367 Feet East and 600 Feet South, from the Reference Corner

☼ Reference Corner: Center 1/4 Corner of Section 1, T.16 S., R. 5 W.