



Oregon Water Resources Department
 725 Summer Street NE, Suite A
 Salem, Oregon 97301
 (503) 986-0900
 www.wrd.state.or.us

RECEIVED

APR 27 2020

**Ownership Update
 For Certificated Rights
 Only**

Sent 4/24/20
 JP

OWRD

NO FEES ARE REQUIRED TO SUBMIT THIS FORM

NOTICE: A certificate of water right typically stays with the land. In order to track water right ownership, the Department requests that this form be submitted to the Department. **To update multiple rights, a separate form is required for each right.**

If you have any questions about this form, please contact your local watermaster, or call the Water Resources Department at (503) 986-0900.

This form is not for Applications, Permits, Transfers, Groundwater Registrations, or Limited Licenses. To notify the Department of changes in ownership to these types of authorizations, an Assignment is required.

Current Landowner Information

Name: Broken Top Community Club DBA - Broken Top Club
 Mailing Address: 62000 Broken Top Dr.
 City: Bend State: OR Zip: 97702
 Phone (Home): 541-213-1885 Work: 541-383-8200 Other: _____

Property Description

County: Deschutes Township: 18S Range: 11E Section: 1
 Taxlot Number(s): 181101000019
 Street Address of water right property: 62000 Broken Top Dr.
 Water Right Information: Application: G-12033 Permit: G-11091 Certificate #: 93055

Are all the lands associated with this water right owned by the requester? Yes No _____ If No, include a map showing the portion of the right involved.

Name of individual completing this form: JACK PERKINS Phone: 541-383-8200
 Signature of requestor: [Signature] Date: 4/24/20

The Department does not change names on certificates. This form will be placed in the file for future reference only. The Department does not provide acknowledgement that this form has been received.

STATE OF OREGON
 COUNTY OF DESCHUTES
 CERTIFICATE OF WATER RIGHT

RECEIVED

APR 27 2020

OWRD

THIS CERTIFICATE ISSUED TO

GOLD RING HOLDINGS LLC
 5837 JEAN RD
 LAKE OSWEGO OR 97035

confirms the right to the use of water perfected under the terms of Permit G-11091. The amount of water used to which this right is entitled is limited to the amount used beneficially, and shall not exceed the amount specified, or its equivalent in the case of rotation, measured at the point of diversion from the source. The specific limits and conditions of the use are listed below.

APPLICATION FILE NUMBER: G-12033

SOURCE OF WATER: ONE WELL IN THE DESCHUTES RIVER BASIN

PURPOSE OR USE: QUASI-MUNICIPAL USE

MAXIMUM RATE: 2.7 CUBIC FEET PER SECOND

DATE OF PRIORITY: FEBRUARY 22, 1990

The well is located as follows:

Twp	Rng	Mer	Sec	Q-Q	Measured Distances
18 S	11 E	WM	1	NW SE	2650 FEET SOUTH AND 1400 FEET WEST FROM NE CORNER, SECTION 1

A description of the place of use is as follows:

Twp	Rng	Mer	Sec	Q-Q
18 S	11 E	WM	1	NE NE
18 S	11 E	WM	1	NW NE
18 S	11 E	WM	1	SW NE
18 S	11 E	WM	1	SE NE
18 S	11 E	WM	1	NE NW
18 S	11 E	WM	1	NW NW
18 S	11 E	WM	1	SW NW
18 S	11 E	WM	1	SE NW
18 S	11 E	WM	1	NE SW
18 S	11 E	WM	1	NW SW

Twp	Rng	Mer	Sec	Q-Q
18 S	11 E	WM	1	SW SW
18 S	11 E	WM	1	SE SW
18 S	11 E	WM	1	NE SE
18 S	11 E	WM	1	NW SE
18 S	11 E	WM	1	SW SE
18 S	11 E	WM	1	SE SE
18 S	11 E	WM	2	SE NE
18 S	11 E	WM	12	NW NE
18 S	11 E	WM	12	NE NW
18 S	12 E	WM	6	NW SW

NOTICE OF RIGHT TO PETITION FOR RECONSIDERATION OR JUDICIAL REVIEW

This is an order in other than a contested case. This order is subject to judicial review under ORS 183.484 and ORS 536.075. Any petition for judicial review must be filed within the 60-day time period specified by ORS 183.484(2). Pursuant to ORS 183.484, ORS 536.075 and OAR 137-004-0080, you may petition for judicial review and petition the Director for reconsideration of this order. A petition for reconsideration may be granted or denied by the Director, and if no action is taken within 60 days following the date the petition was filed, the petition shall be deemed denied. In addition, under ORS 537.260 any person with an application, permit or water right certificate subsequent in priority may jointly or severally contest the issuance of the certificate within three months after issuance of the certificate.

RECEIVED

APR 27 2020

OWRD

Claim of Beneficial Use Point of Diversion & Place of Use Map


RECEIVED BY OWRD

MAY 04 2017

Application G-12033, Permit G-11091; Permit Amendment T-8065

Deschutes County
Township 18 South, Range 11 & 12 East (W.M.)

SALEM, OR

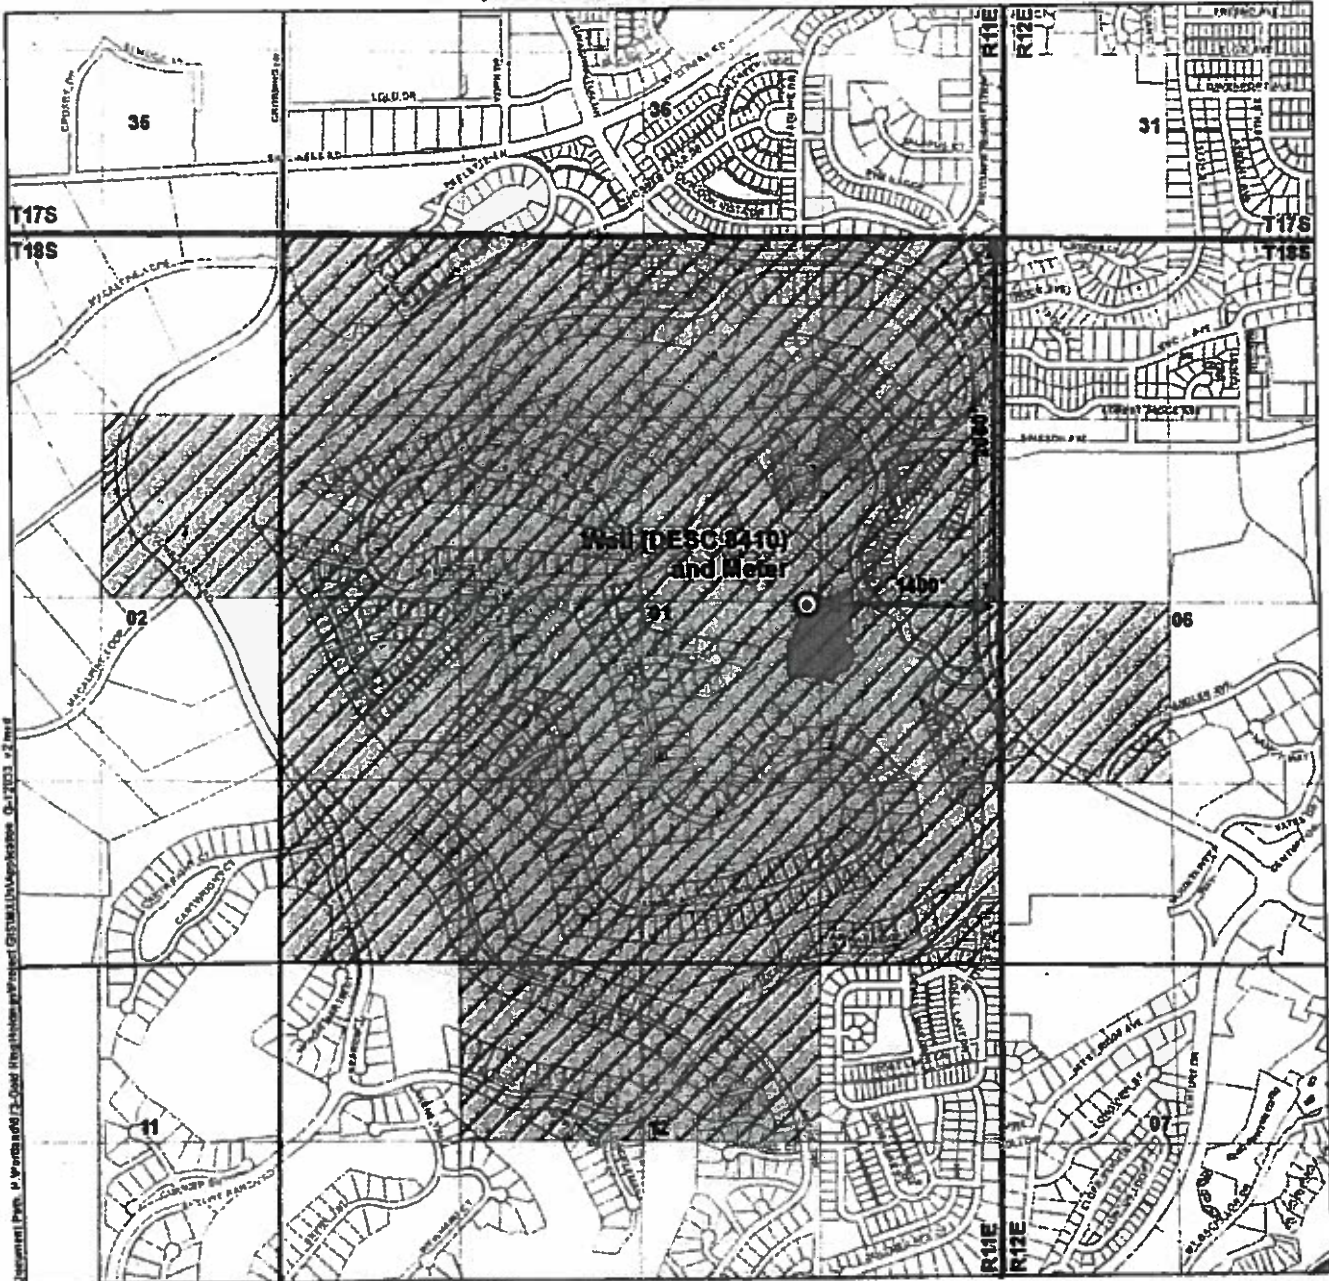


LEGEND

- Well Location
- Tax Lot
- Waterbody
- Place of Use (POU)

POD LOCATION DESCRIPTION

Point of Diversion
 Proposed Well Located 2,650 feet South and 1400 feet West from the NE corner of Section 1, Township 18 South, Range 11 East (W.M.)
 Meter Location
 Meter Located 4' SW of well inside vault

Certified Water Rights Examiner Stamp

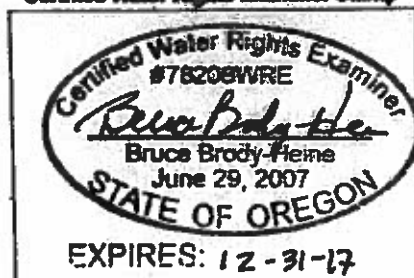

DISCLAIMER

This map was prepared for the purpose of identifying the location of a water right only and it is not intended to provide legal dimensions or location of property ownership lines.

MAP NOTES

Date: May 1, 2017
 Data Sources: Deschutes County, BLM, OWRD

