



Oregon Water Resources Department
 725 Summer Street NE, Suite A
 Salem, Oregon 97301
 (503) 986-0900
 www.wrd.state.or.us

Request for Assignment

RECEIVED

FEB 01 2021

OWRD

If the Department determines that the application is incomplete, fees have not been paid, or the required documents are not acceptable, the application and all fees submitted will be returned to the applicant.

If for multiple rights, a separate form and fee for each right will be required.

I, Judy Steagall

(Name of Current Holder of Record)

13805 NE Lawson Prineville, OR 97754 (503) 349-7743

(Mailing Address) (City) (State) (Zip) (Phone #)

- hereby assign all my interest in and to the entire application/permit/transfer/limited license/groundwater statement; (example, sold all the land authorized under the right)
- hereby assign all my interest in and to a portion of application/permit/transfer/limited license/groundwater statement; (You must include a map showing the portion of the application/permit/transfer order/limited license/groundwater statement to be assigned. Example, sold a portion of the land authorized under the right)
- hereby assign a portion of my interest in and to the entire application/permit/transfer/limited license/groundwater statement; (example, adding an additional person)

Application # _____; Permit # _____; Transfer # _____;

Limited License # _____; Groundwater Statement # GR-3380;

as filed in the office of the Water Resources Director, to:

Watkinson Family Trust: W Grant and Diane R Watkinson Trustee

(Name of New Owner)

15784 Twin Fir Rd Lake Oswego, OR 97035 (503) 635-0163

(Mailing Address) (City) (State) (Zip) (Phone #)

Note: If there are other owners of the property described in the application, permit, transfer order, limited license, or groundwater statement, you must provide a list of all other owners' names and mailing addresses and attach it to this form. Write the initials (first letters) of your first and last names at the spot indicated below _____.

J I hereby certify that I have notified all other owners of the property described in this application, permit, transfer order, limited license, or groundwater statement of this Request of Assignment.

Witness my hand this 16 day of January, 2021.
 (Day) (Month) (Year)

Signature of Current Holder of Record Judy Steagall

Failure to provide any of the required information will result in the return of your application.

This certifies assignment and record change at Oregon Water Resources Department effective 8:00 a.m. on date of receipt at Salem, Oregon.
 Fee receipt # 134433
 For Director by Mary F. Bjork, Program Analyst in Water Rights Division. MFB

The completed "Request for Assignment" form *must* be submitted to the Department along with the recording fee of \$100.


part assign. - Approve MFB 2-17-2021

SW Advance Rd

7 8
18 17

T.3S. R.1E. Section 18, W.M.

Authorized Well 1 (CLAC 9387) is located 1,070 feet south and 2,360 feet west from the NE corner, Section 18.

 Area (3.6 Acres) registered under GR-3380, priority date 9-30-1950, to be assigned to Watkinson Family Trust: W. Grant and Diane R. Watkinson, Trustee.

 Area (25.4 Acres) registered under GR-3380, priority date 9-30-1950, to remain under Wilbur Bruck.

 Tax lot boundary

RECEIVED

FEB 03 2021

OWRD

Scale: 1" = 400'



This map was prepared for the purpose of identifying the location of a water right only and is not intended to provide legal dimensions or location of property ownership lines.

Partial Assignment Map GR-3380

Watkinson Family Trust: W. Grant and Diane R. Watkinson, Trustee
T.3S. R.1E. Section 18, W.M.

01/2021

13.0 12.4

3.6


TL 3 1E 18
700

TL 3 1E 18 600

TL 3 1E 18
800

Authorized Well 1
(CLAC 9387)

SW 53rd Ave

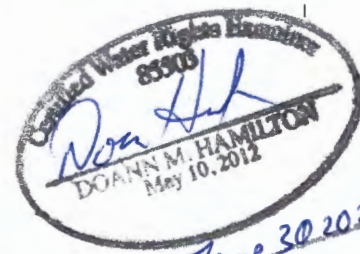

June 30 2021

SW Kruse Rd

18

Pacific Hydro-Geology Inc.