

RECEIVED

AUG 11 1999

WATER RIGHT EXAMINER
STATE OF OREGON

DLC 39

POINT OF DIVERSION
UNDER T-7263

DLC 40

DITCH SUPPLIES WATER TO
SUMP UNDER T-7263 DURING
IRRIGATION SEASON ONLY

FINAL
PROOF
SURVEY
RESERVOIR

CARIS CREEK

RESERVOIR

(ALSO SUMP UNDER T-7263)

INLET: 366' NORTH & 56' EAST
OUTLET: 300' NORTH & 52' EAST
FROM SW COR. SECTION 30

25 30

36 31

DLC 38

T.37 S.

R.5 W.

R.4 W. W.M.

APPLICATION R-75053 PERMIT R-12659
IN NAME OF


CHERYL SHAW

SURVEYED: JULY 16, 1999

BY:

JONATHAN C. SPERO C.W.R.E. 123
1002 KINCAID RD./P.O. BOX 16
WILLIAMS, OREGON 97544
PH. (541) 846-6845

THIS MAP IS FOR THE PURPOSE OF
IDENTIFYING THE LOCATION OF THE
WATER RIGHT ONLY AND IS NOT IN-
TENDED TO PROVIDE LEGAL DIMEN-
SIONS OR LOCATIONS OF PROPERTY
OWNERSHIP LINES.

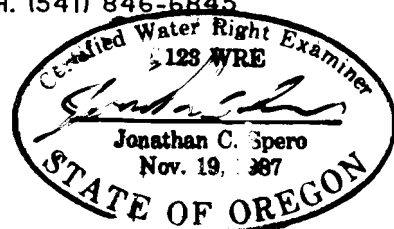

SCALE: 1" = 400'

RENEWAL DATE: JUNE 30, 2000