


SECTION PLAT

Section 5 Township 26-S Range 31-E

County of Harney State of OR

NORTH

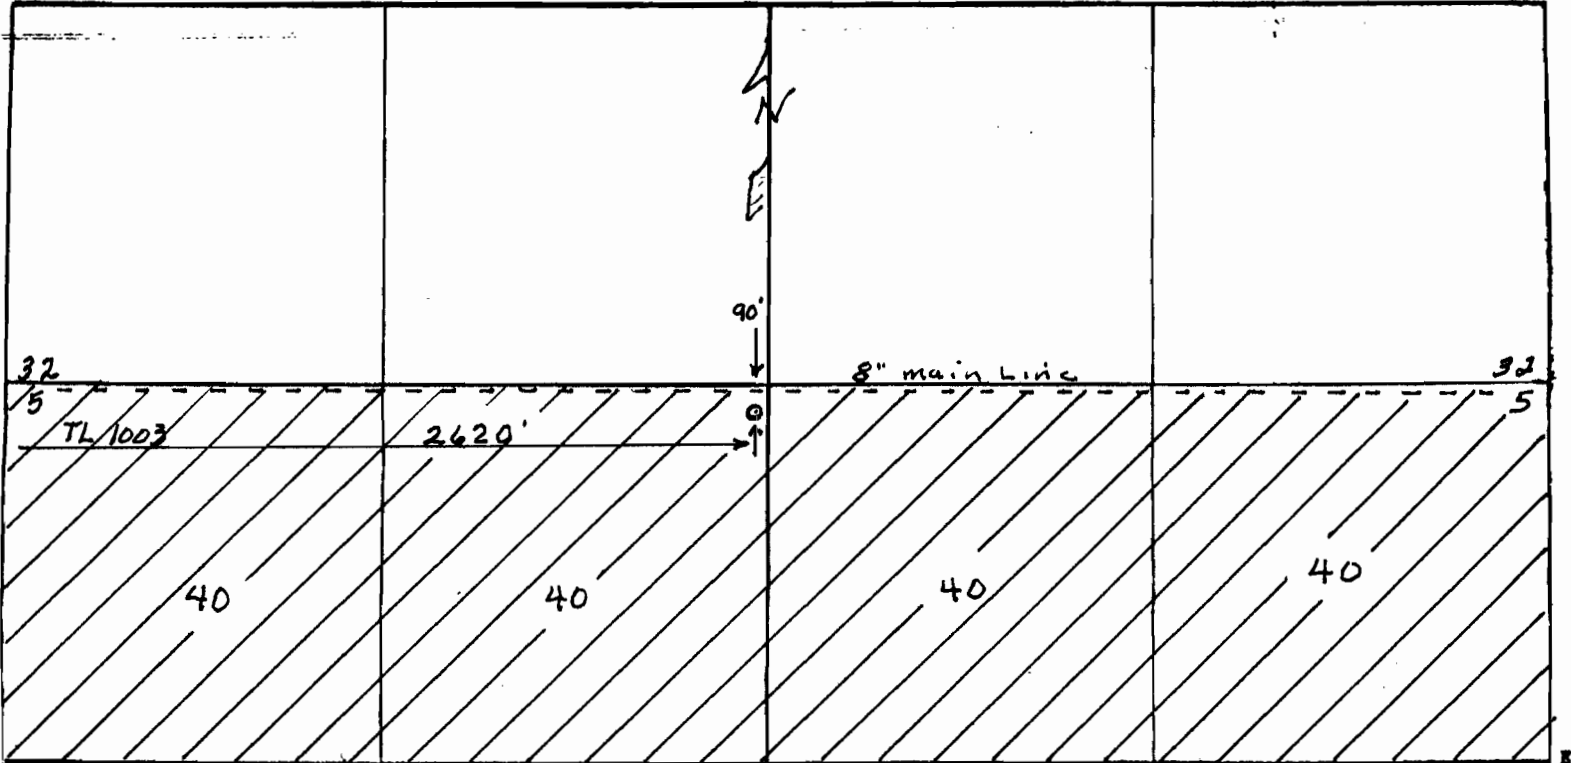

RECEIVED

MAY 23 2007

WATER RESOURCES DEPT
SALEM, OREGON

scale = 1" = 660'