


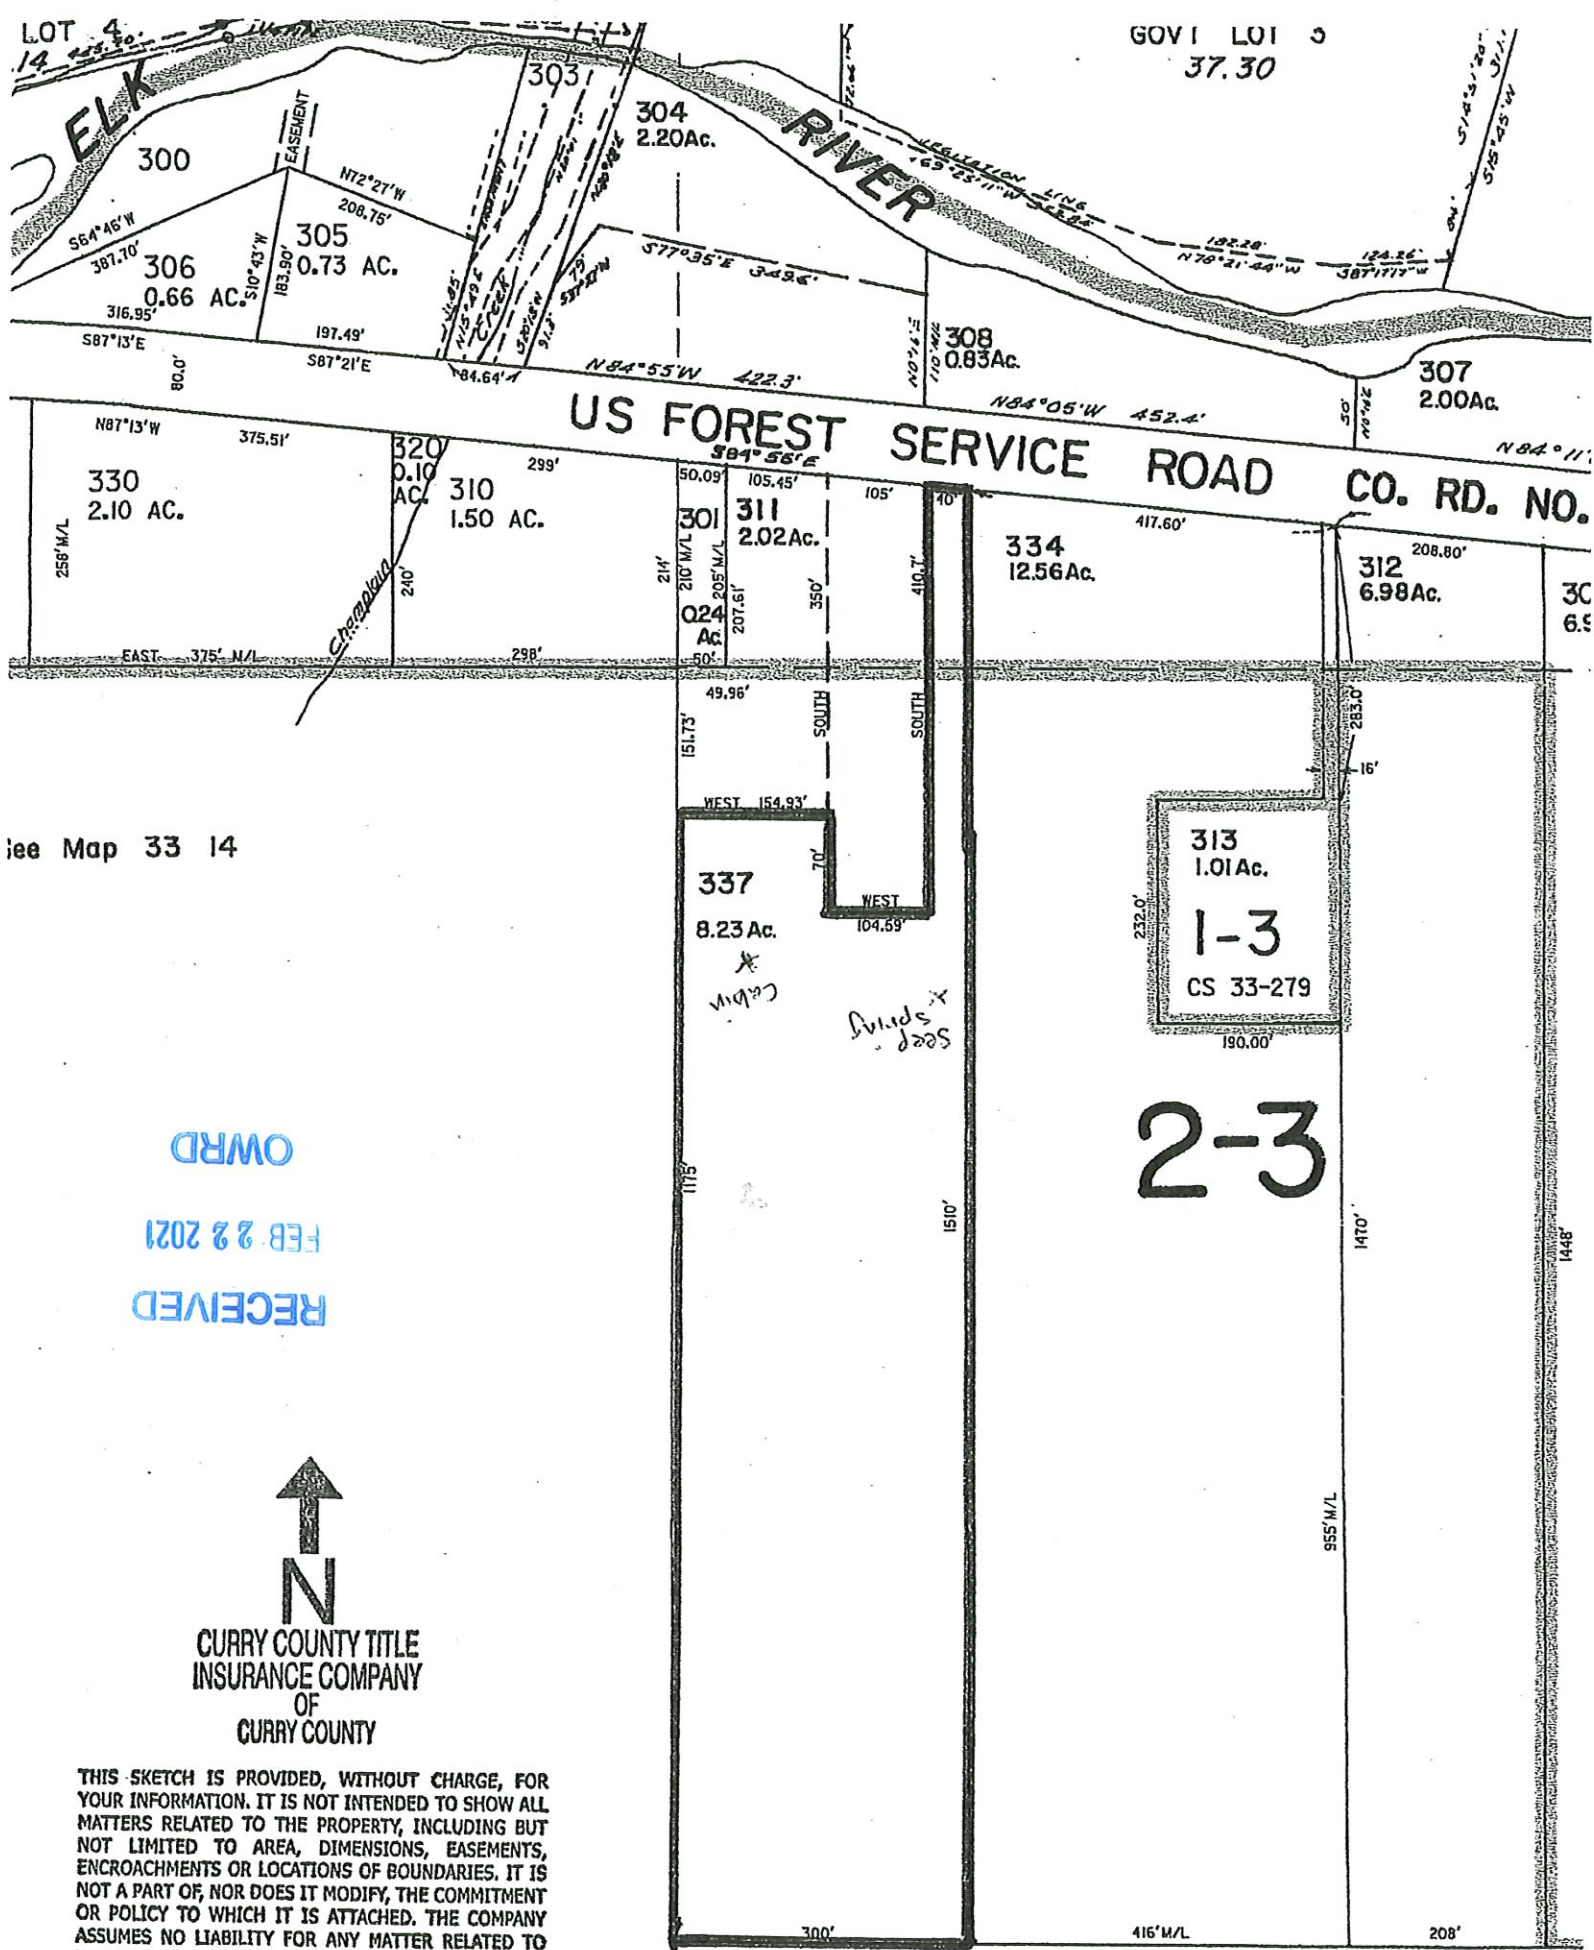

See Map 33 14

OWRD

FEB 22 2021

RECEIVED



**CURRY COUNTY TITLE
INSURANCE COMPANY
OF
CURRY COUNTY**

THIS SKETCH IS PROVIDED, WITHOUT CHARGE, FOR YOUR INFORMATION. IT IS NOT INTENDED TO SHOW ALL MATTERS RELATED TO THE PROPERTY, INCLUDING BUT NOT LIMITED TO AREA, DIMENSIONS, EASEMENTS, ENCROACHMENTS OR LOCATIONS OF BOUNDARIES. IT IS NOT A PART OF, NOR DOES IT MODIFY, THE COMMITMENT OR POLICY TO WHICH IT IS ATTACHED. THE COMPANY ASSUMES NO LIABILITY FOR ANY MATTER RELATED TO THIS SKETCH, UNLESS SUCH COVERAGE IS SPECIFICALLY PROVIDED BY THE COVERED RISKS OF THE POLICY. REFERENCE SHOULD BE MADE TO AN ACCURATE SURVEY FOR FURTHER INFORMATION.


west property line

east property line

Steep forested hillside

RECEIVED
FEB 22 2021
OWRD

The spring and the majority
of the lot reside in Township 33S,
Range 14 W, Section 7 NE NW

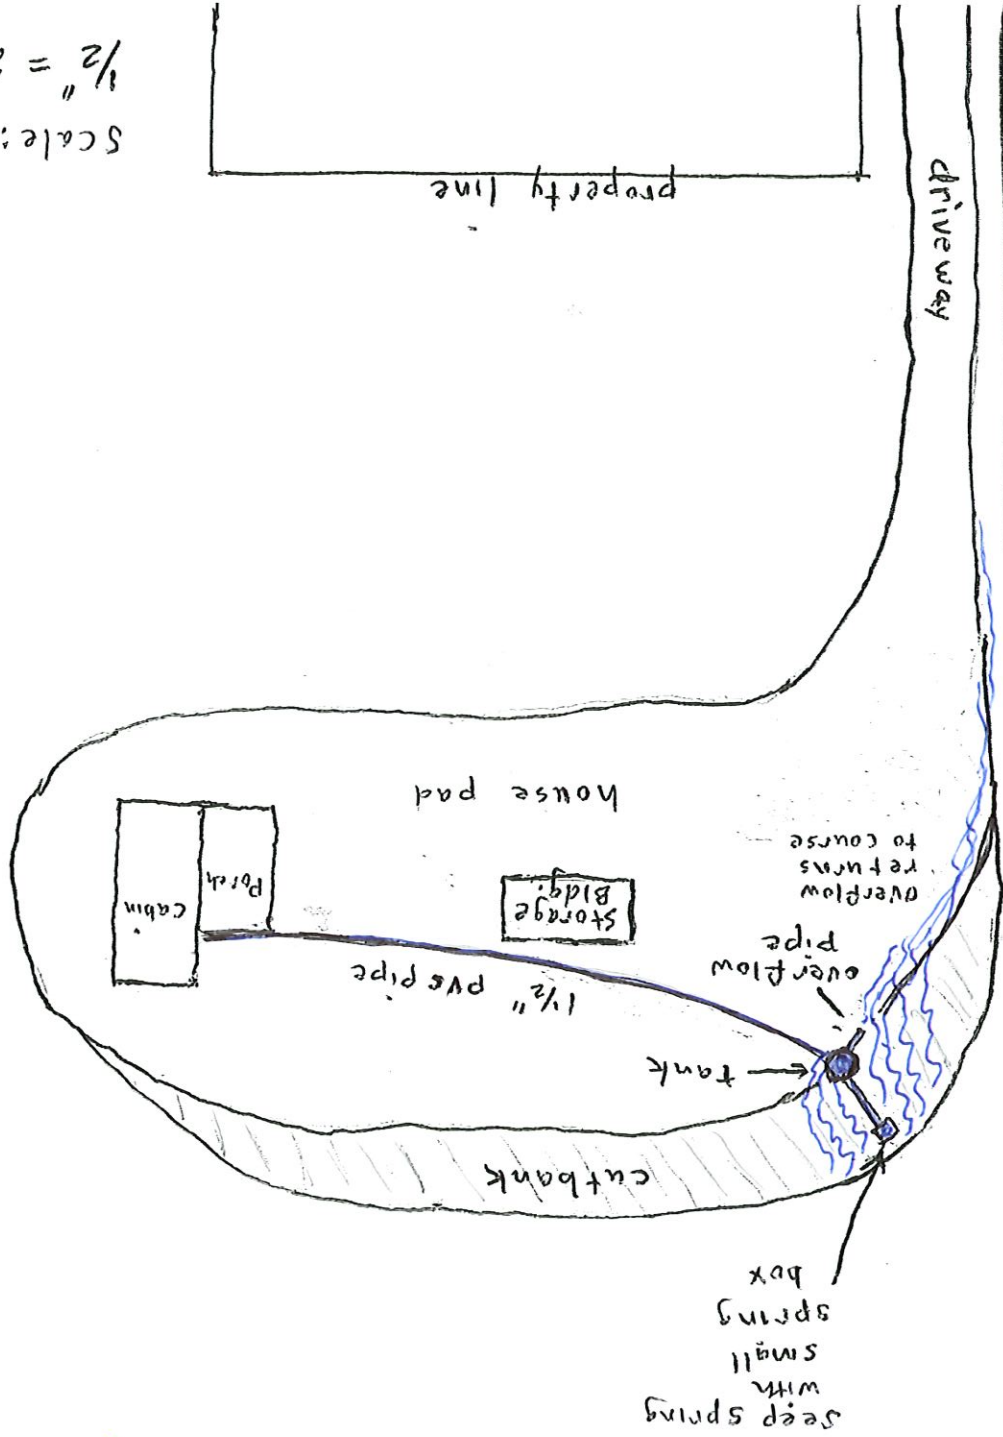

The driveway resides on

T33R 14S 06C

Tax Lot 337

as it is listed by the
County tax assessor.


N
North

Scale:

1/2" = 20'

Water Right Application Map #3
Melissa Bishop

Location: NE $\frac{1}{4}$ NW $\frac{1}{4}$, Section 7, Township 33 South, Range 14 West, Tax Lot 337

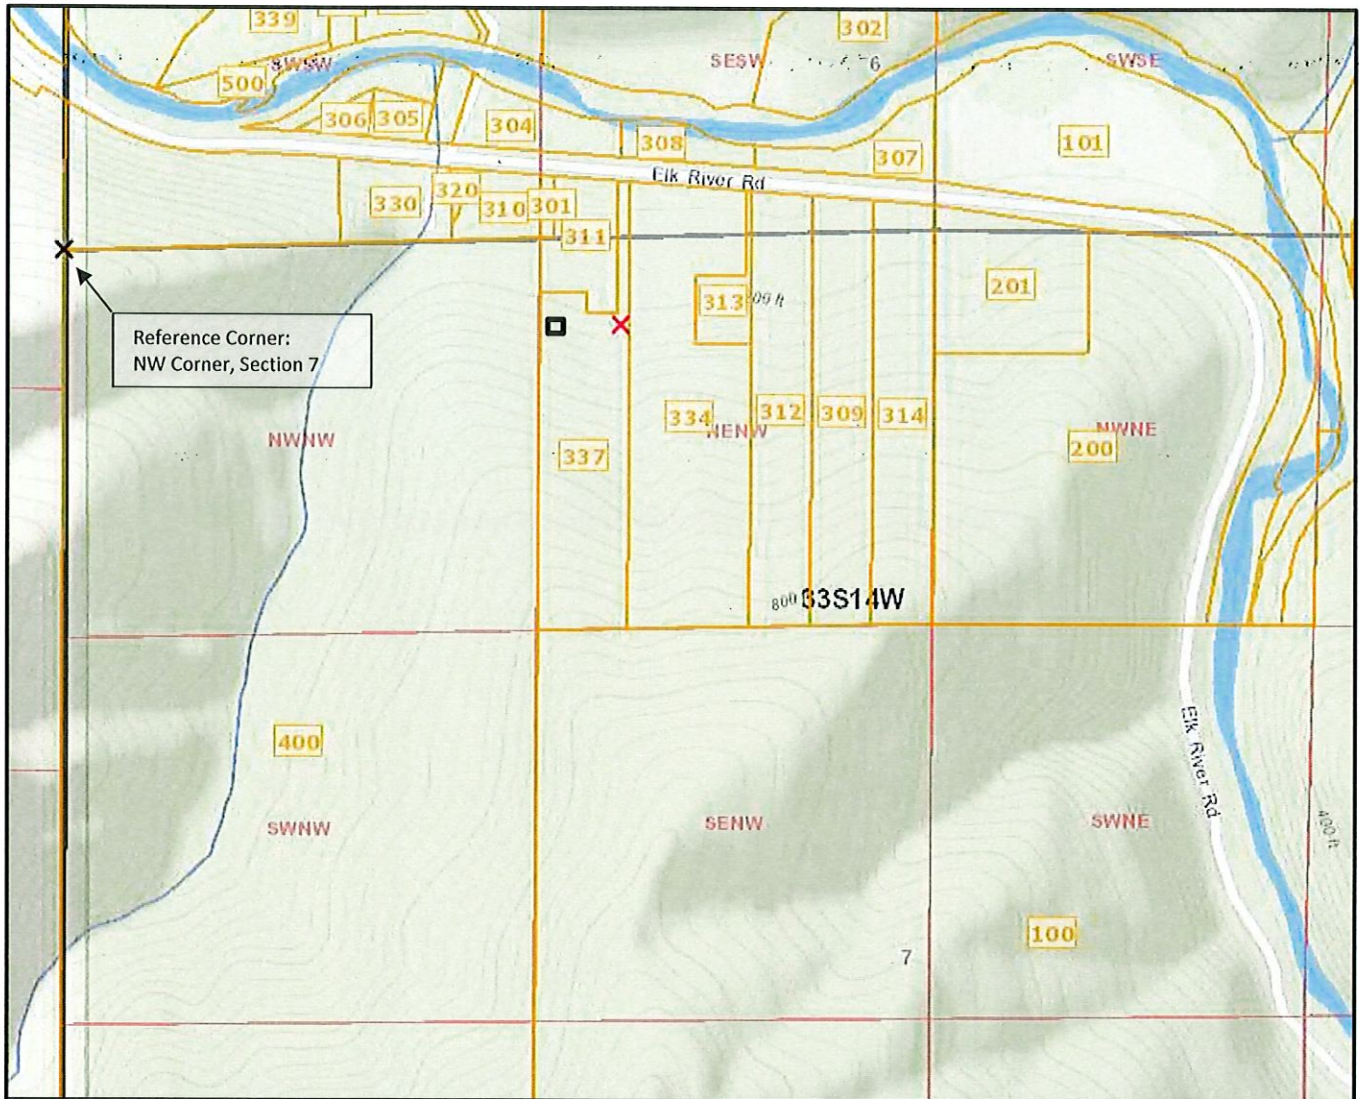

Location of Spring: 336 Feet South and 1871 Feet East from NW Corner, Section 7

Legend:

- X = Reference Corner (NW Corner, Section 7)
- X = Location of Spring
- = Domestic use (cabin)



Scale:

1 inch = 600 feet

RECEIVED

MAR 10 2021

OWRD