

# MONEY SLIP

|                |                   |
|----------------|-------------------|
| DATE: 3-8-2021 | RECEIPT #: 134704 |
|----------------|-------------------|

RECEIVED FROM: Inland West Inc.  
Bon + Julie Williams

|             |  |
|-------------|--|
| APPLICATION |  |
| PERMIT      |  |
| TRANSFER    |  |

CASH ☐ CHECK # ☒ 4083 OTHER (IDENTIFY) ☐

|             |           |
|-------------|-----------|
| TOTAL REC'D | \$ 200.00 |
|-------------|-----------|

|               |                      |
|---------------|----------------------|
| 1083 TREASURY | 4170 MISC CASH ACCT. |
|---------------|----------------------|

|                   |    |
|-------------------|----|
| 0407 COPIES       | \$ |
| OTHER: (IDENTIFY) | \$ |

0243 Instream Lease \_\_\_\_\_ 0244 Muni Water Mgmt. Plan \_\_\_\_\_ 0245 Cons. Water \_\_\_\_\_

|               |                          |
|---------------|--------------------------|
| 1083 TREASURY | 4270 WRD OPERATING ACCT. |
|---------------|--------------------------|

| MISCELLANEOUS                  |  |    |
|--------------------------------|--|----|
| 0407 COPY & TAPE FEES          |  | \$ |
| 0410 RESEARCH FEES             |  | \$ |
| 0408 MISC REVENUE (IDENTIFY)   |  | \$ |
| TC162 DEPOSIT LIAB. (IDENTIFY) |  | \$ |
| 0240 EXTENSION OF TIME         |  | \$ |

| WATER RIGHTS       |    | EXAM FEE |      | RECORD FEE |
|--------------------|----|----------|------|------------|
| 0201 SURFACE WATER | \$ |          | 0202 | \$         |
| 0203 GROUND WATER  | \$ |          | 0204 | \$         |
| 0205 TRANSFER      | \$ |          |      |            |

| WELL CONSTRUCTION           |    | EXAM FEE |      | RECORD FEE |
|-----------------------------|----|----------|------|------------|
| 0218 WELL DRILL CONSTRUCTOR | \$ |          | 0219 | \$         |
| LANDOWNER'S PERMIT          |    |          | 0220 | \$         |
| OTHER (IDENTIFY)            |    |          |      |            |

|               |                    |
|---------------|--------------------|
| 0607 TREASURY | 0467 HYDROELECTRIC |
|---------------|--------------------|

|                                 |            |    |
|---------------------------------|------------|----|
| 0233 POWER LICENSE FEE (FW/WRD) | LIC NUMBER |    |
| 0231 HYDRO LICENSE FEE (FW/WRD) |            | \$ |
|                                 |            | \$ |
| HYDRO APPLICATION               |            | \$ |

**SPECIAL INSTRUCTIONS:**

☐ RETURN TO APPLICANT -- LETTER ATTACHED



**Oregon**  
Kate Brown, Governor

**Water Resources Department**

725 Summer St NE, Suite A

Salem, OR 97301

(503) 986-0900

Fax (503) 986-0904

March 11, 2021

Waibel Ranches LLC  
8055 SW Powell Butte Hwy  
Powell Butte OR 97753

On March 08, 2021 the Water Resources Department received the Claim of Beneficial Use (COBU) for the following file(s):

Application R-86911 Permit R-14547

The COBU included a report and map. The Department hopes to review your submittal within approximately 2 - 4 years. At that time we will review these items and provide a final certificate, proposed certificate, or a request for additional information.

If you are interested in having your COBU reviewed sooner, you may pay to have your file processed immediately, using the Reimbursement Authority program, which is described at:

<https://www.oregon.gov/OWRD/programs/WaterRights/RA/Pages/Certificate.aspx>

Customer Service phone: (503) 986-0900

Enclosed is your receipt for the \$200.00 COBU recording fee

If you sell the property, please contact the Department, or have the new owners contact the Department about the need to file an assignment.

Cc: file R-86911

# CBU Intake and Certificate Processing Checklist for Qualifying Alternative Reservoirs

Under ORS 537.409(10)(11) (COBU by Permittee for "Alternative Reservoirs")

Total developed capacity must be less than 9.2 acre feet

A fee of \$200 must accompany this form

File No. R- 86911

File Marked \_\_\_\_\_

Date Rec'd. 03/08/2021

Claim Logged \_\_\_\_\_

Reviewer Judy

Peer Review \_\_\_\_\_

## Intake Checklist

**Does a secondary permit exist for use of water under this permit at the time of this submittal?**

☐ YES ☒ NO (If "Yes", this self certification cannot be accepted. The Claim must be prepared by a CWRE for both the reservoir and the secondary use permit.)

**Are reservoir dimensions included?** ☒ YES ☐ NO

**Signed by all permittees** ☒ YES ☐ NO (Must be signed by all permittees. If not, Assignment may be

needed). **Was a map included?** ☒ YES ☐ NO (Must Identify Location of the Reservoir)

## Processing Notes and Conclusions

**The Claimed maximum capacity of the reservoir in acre feet is:** \_\_\_\_\_

**The Permitted capacity of the reservoir in acre feet is:** \_\_\_\_\_

**Is this reservoir located within an "Area of Interest"?** ☐ YES ☐ NO

**Identified Party** \_\_\_\_\_

**Current Ownership Check:**

**Does the County Assessor indicate that there is a new landowner?** ☐ YES ☐ NO

(If new owners, indicate name and mailing address below)

**Issue:** ☐ PROPOSED (If fewer acre feet were developed than were permitted)

☐ CERTIFICATE # \_\_\_\_\_

**CLAIM OF  
BENEFICIAL USE  
for Reservoirs storing less than  
9.2 acre-feet permitted under  
ORS 537.409**



Oregon Water Resources Department  
725 Summer Street NE, Suite A  
Salem, Oregon 97301-1266  
(503) 986-0900  
[www.oregon.gov/OWRD](http://www.oregon.gov/OWRD)

RECEIVED

MAR 08 2021

OWRD

A fee of \$200 must accompany this form.  
The Claim will be returned if the fee is not included.

This form may be completed by the permit holder of record if:

- 1) The permit was issued under the authority of ORS 537.409; and
- 2) No secondary permit exists for the use of water stored in the reservoir; and
- 3) The developed capacity of the reservoir is less than 9.2 acre-feet; and
- 4) The water was stored by the date required in the permit; and

A separate form shall be completed for each permit.

This form must be submitted to the Water Resources Department within one year of storage of water in the reservoir.

Please type or print in dark ink. If the data provided is found to contain errors or omissions, it may be returned. The Department may require the submittal of additional information.

If you have questions regarding the completion of this form, please call 503-986-0900 and ask for the Certificate Section.

**SECTION 1**

**GENERAL INFORMATION**

**File Information:**

|                           |                      |
|---------------------------|----------------------|
| APPLICATION #<br>R- 86911 | PERMIT #<br>R- 14547 |
|---------------------------|----------------------|

**Applicant Information:**

|                                         |              |                           |                                |  |
|-----------------------------------------|--------------|---------------------------|--------------------------------|--|
| APPLICANT NAME<br>WAIBOL RANCHES LLC    |              | PHONE NO.<br>541.419.1853 | ADDITIONAL CONTACT NO.         |  |
| ADDRESS<br>601 UNION STREET, SUITE 3315 |              |                           |                                |  |
| CITY<br>SEATTLE                         | STATE<br>WA. | ZIP<br>98101              | E-MAIL<br>ZICOWS.WA1@QUAIL.COM |  |

**SECTION 2**  
**RESERVOIR INFORMATION**

RECEIVED

MAR 08 2021

OWRD

**Reservoir Dimensions and Capacity:**

| AVERAGE<br>LENGTH | AVERAGE<br>WIDTH | AVERAGE<br>DEPTH | MAXIMUM CAPACITY<br>IN ACRE-FEET |
|-------------------|------------------|------------------|----------------------------------|
| 8'-0"             | 3'-0"            | 3'-0"            | 0.01 ac FT.                      |

To determine capacity in acre-feet use for the above table, use the following calculation:

$$\text{Acre-feet} = \frac{(\text{Average Length})(\text{Average Width})(\text{Average Depth})}{43,560}$$

**SECTION 3**

**MAP**

Attach a map identifying the reservoir location. If the water right application map accurately reflects the location of the reservoir, you may attach a copy of it. Otherwise, you must submit a map meeting the standards of OAR 690-310-0050, which are attached.

Preparation of the map by a Certified Water Rights Examiner is **not** required for this type of permit, but may be submitted.

**SECTION 4**

**SIGNATURE**

*This Claim of Beneficial Use must be signed by each permit holder of record.*

By my signature, I certify that the information contained herein is true and correct to the best of my knowledge.

| SIGNATURE | PRINT OR TYPE NAME | TITLE | DATE |
|-----------|--------------------|-------|------|
|           |                    |       |      |
|           |                    |       |      |
|           |                    |       |      |

**SECTION 2  
RESERVOIR INFORMATION**

Reservoir Dimensions and Capacity:

| AVERAGE<br>LENGTH | AVERAGE<br>WIDTH | AVERAGE<br>DEPTH | MAXIMUM CAPACITY<br>IN ACRE-FEET |
|-------------------|------------------|------------------|----------------------------------|
| 8'-0"             | 3'-0"            | 3'-0"            | 0.01 ac FT.                      |

To determine capacity in acre-feet use for the above table, use the following calculation:

$$\text{Acre-feet} = \frac{(\text{Average Length})(\text{Average Width})(\text{Average Depth})}{43,560}$$

**SECTION 3  
MAP**



Attach a map identifying the reservoir location. If the water right application map accurately reflects the location of the reservoir, you may attach a copy of it. Otherwise, you must submit a map meeting the standards of OAR 690-310-0050, which are attached.

Preparation of the map by a Certified Water Rights Examiner is **not** required for this type of permit, but may be submitted.

**SECTION 4  
SIGNATURE**

*This Claim of Beneficial Use must be signed by each permit holder of record.*

By my signature, I certify that the information contained herein is true and correct to the best of my knowledge.
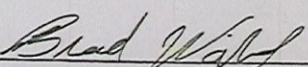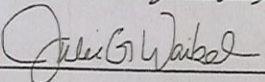
| SIGNATURE                                                                           | PRINT OR TYPE NAME | TITLE           | DATE   |
|-------------------------------------------------------------------------------------|--------------------|-----------------|--------|
|  | Brad Waibel        | managing member | 3/5/21 |
|  | Julie Waibel       | Managing member | 3/5/21 |
|                                                                                     |                    |                 |        |

**RECEIVED**  
MAR 08 2021  
**OWRD**

R-14847




Scale  
1"=1320'

RECEIVED

MAR 08 2021

OWRD

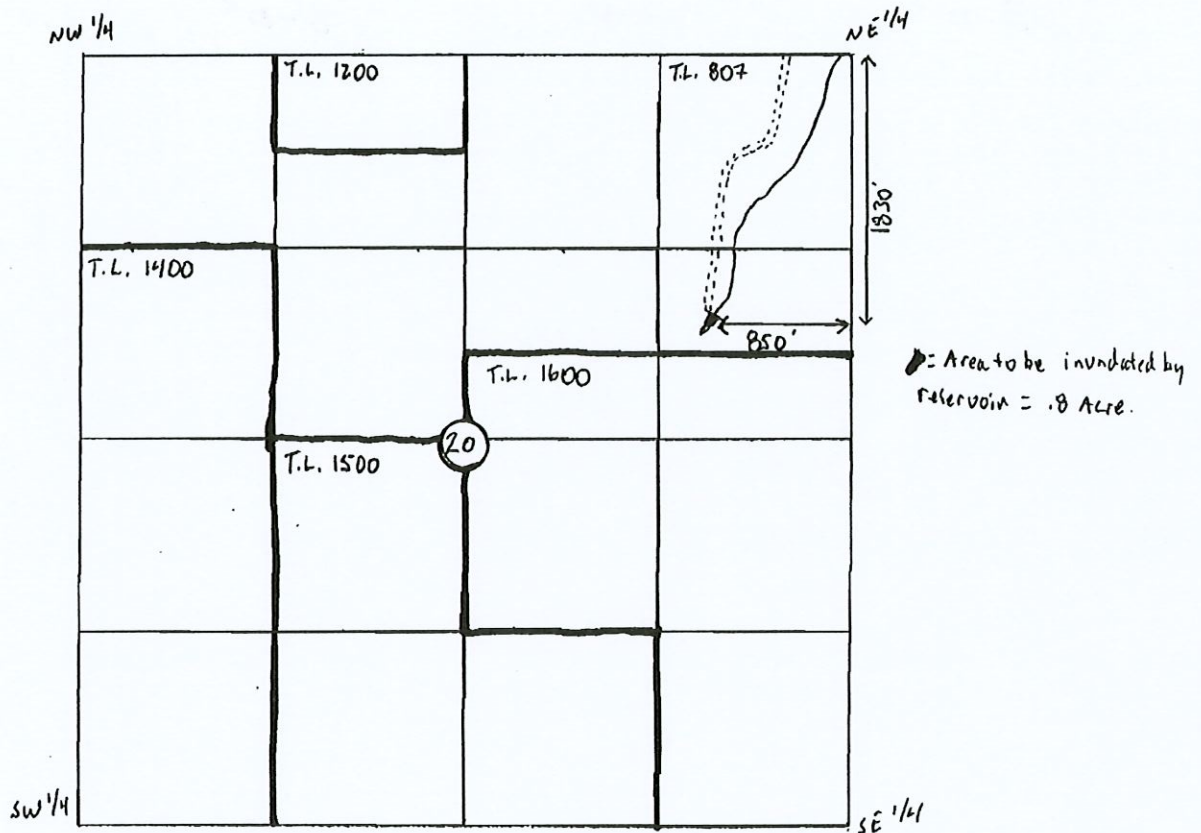

DAM/Reservoir location: SE 1/4 NE 1/4, Township 15 South, Range 17 East, Section 20, W.M.  
POB/DAM: 1830' South & 850' West of the NE corner of Section 20, T.15S, R.17E, W.M.

## FINAL PROOF SURVEY UNDER

RECEIVED

JUN 25 2007

WATER RESOURCES DEPT  
SALEM OREGON


Application No. R86911 Permit No. ....  
IN NAME OF

Les. Subw. title. Waters. of Oregon, Inc. ....

Surveyed ..... 19....., by .....

JAN 19 2021

OWRD

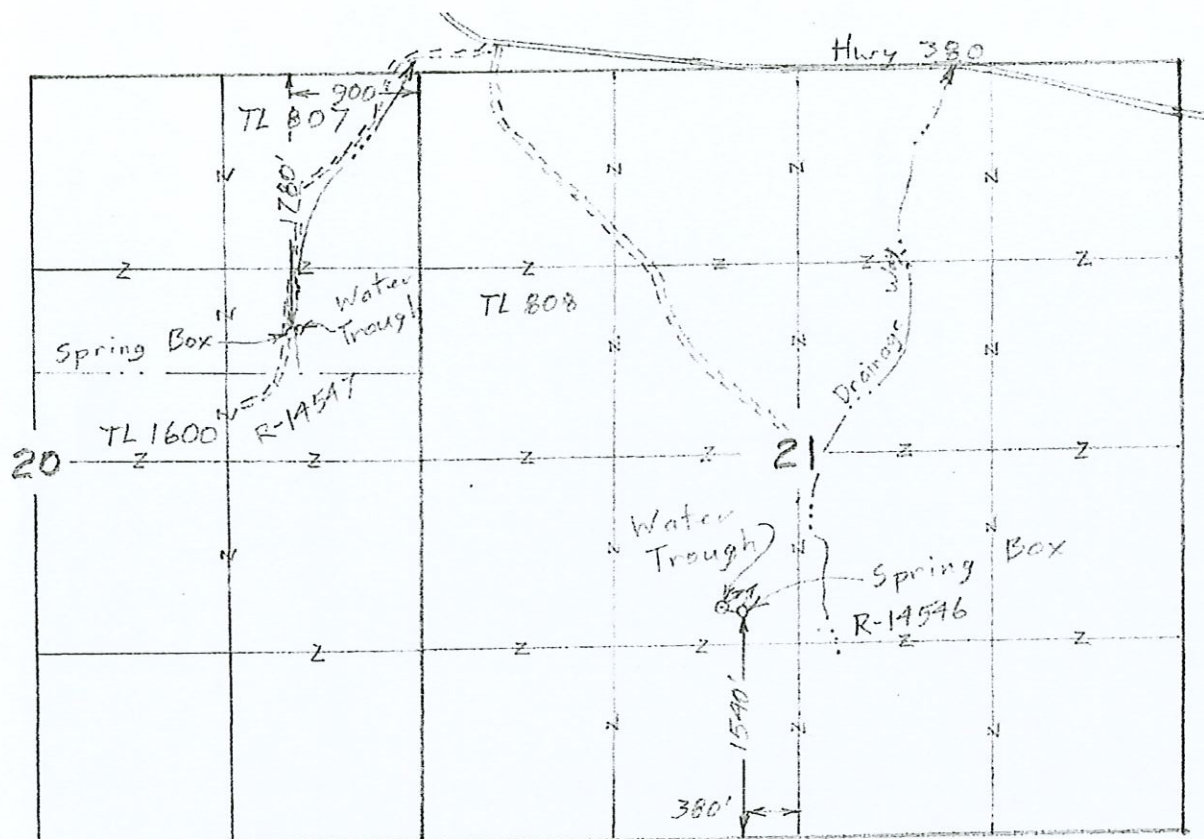

Surveyed July 25, 2013

Scale  
1" = 1320'  
(4" = 1 mile)

Claim of Beneficial Use Map  
for  
Waibel Ranch, LLC

RECEIVED

MAR 08 2021

OWRD

App R-86910 Per R-14546

App R-86911 Per R-14547



Renewal Dec 31, 2007

**This map is for the purpose of  
locating a water right only  
and has no intent to provide  
legal dimensions or the location  
of property lines.**

**ESTES SURVEYS, LLC**

~~PO Box 17519~~  
~~Salem, OR 97305-7519~~  
~~(503) 585-7593~~

60382 Arnold Rd  
Bend, OR 97702  
(541) 382-7391